CI

IREDELL COUNTY HEALTH DEPARTMENT

STATESVILLE 704-878-5305 CI MOORESVILLE 704-664-5281

IMPROVEMENT PERMIT / AUTHORIZATION TO CONSTRUCT / OPERATION PERMIT / EXISTING SYSTEM INSPECTION

PERMIT# 119175 PIN# 4726-03-4050 DATE 4/7/04

OWNER OR CONTRACTOR Larry Munday PHONE: Business (704)902-1479 Home —

ADDRESS 623 Shiloh Rd Statesville N.C. 28677

LOCATION Hwy 115 N. @ Scotts Creek Rd @ Cottle Ridge Drive @ West Windsee Court on Right

SUBDIVISION Cottle Ridge BLOCK / SECTION — LOT 28 LOT AREA .46 Acres SITE CLASS. 5 DESIGN FLOW 360 L.T.A.R. .025 gpd/ft2

Septic Tank: 1000 Gallons; STB 1007 Date 1-6-06
Pump Tank: 1000 Gallons; PT 273 Date 2-13-06
Pump Make: Zoeller Model BN 98 B Serial No.
Nitrification Field: No Fields 1 Square Feet 1440 Linear Feet 360
No Lines 4@90' Trench Width 36" Max Trench Bottom Depth 36" Gravel Depth 2"/4

☒ New System ☐ Repair System Type: I, II, III, IV, V, VI
System Description: Pump, 25% Reduction
Repair System Description: Pump & 4 Laterals
Maintenance Agreement Required: ☐ Yes ☒ No


☒ House/Mod. Home No. Bedrooms 3
☐ Mobile Home No. Bathrooms 2
☐ Business No. Employees
☐ Other
☐ Slab ☒ Crawl Space ☐ Basement w/plumbing ☐ Basement wo/plumbing

Water Supply: ☐ Individual ☒ Public ☐ Community

Comments:/Conditions: ① Install liner on Contour

Comments:/Conditions: Zabel Fill

INITIAL SITE SKETCH (Not To Scale)

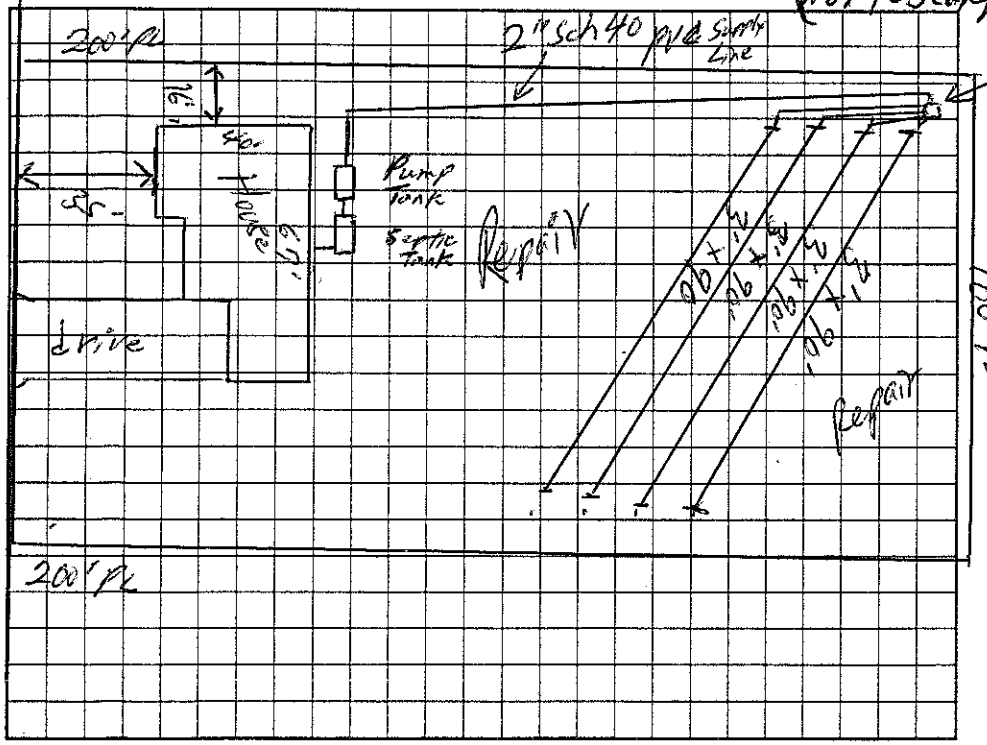

AS BUILT SKETCH

Permit can be suspended or revoked if any false information is supplied toward securing the permit/any unauthorized changes are made to the site/any unauthorized changes are made in the installation of the system. Improvement Permit with plat valid without expiration. Improvement Permit with site plan valid for sixty months. Authorization to Construct is valid for a period equal to that of Improvement Permit – not to exceed sixty months.

Signed: Larry Munday date 5-24-04 Installed by:

Improvement Permit by: William C. Johnson date 4/7/04 Operation Permit by: James date 4-20-06

Authorization to Construct by: William C. Johnson date 4/7/04 Existing System Inspection by: date

HEALTH DEPT. COPY: WHITE OWNER COPY (FINAL): YELLOW OWNER COPY (INITIAL): PINK