IREDELL COUNTY HEALTH DEPARTMENT

STATESVILLE 704-878-5305 CJ MOORESVILLE 704-664-5281

IMPROVEMENT PERMIT / AUTHORIZATION TO CONSTRUCT / OPERATION PERMIT / EXISTING SYSTEM INSPECTION

PERMIT# 11 8000 PIN# ~~4726-02-3887~~ 4726-03-4270 DATE 4/2/03

OWNER OR CONTRACTOR Standard Building Co. Inc. PHONE: Business (704) 902-4618 Home —

ADDRESS 161 Berringer Drive Statesville, N.C. 28625

LOCATION Hwy 115 N. @ Scotts Creek Rd, (L) on Celtic Ridge 1st Rt to Right Lot on Left

SUBDIVISION Celtic Ridge BLOCK / SECTION — LOT 31 LOT AREA .459 Ac SITE CLASS. 15 DESIGN FLOW 360 L.T.A.R. .25 gpd/sqft

Septic Tank: 1000 Gallons; STB 1012 Date 1-24-03
Pump Tank: — Gallons; PT — Date —
Pump Make: — Model Equi-Flo Serial No. —
Nitrification Field: No Fields 1 Square Feet 1440 Linear Feet 360
No Lines 4@90 Trench Width 36" Max Trench Bottom Depth 30" Gravel Depth NA

☒ New System ☐ Repair System Type: I, II, III, IV, V, VI
System Description: Gravity, 2 Sq Bedroom
Repair System Description: Gravity, 1 Pump Low Pressure Pipe
Maintenance Agreement Required: ☐ Yes ☒ No


☒ House/Mod. Home No. Bedrooms 3
☐ Mobile Home No. Bathrooms 2
☐ Business No. Employees —
☐ Other —
☐ Slab ☒ Crawl Space ☐ Basement w/plumbing ☐ Basement wo/plumbing

Water Supply: ☐ Individual ☒ Public ☐ Community

Comments:/Conditions:

Comments:/Conditions: -ST Model # Tuf-Tite filter Installed
-ST Infiltrator ~~Pipe~~ chambers

INITIAL SITE SKETCH

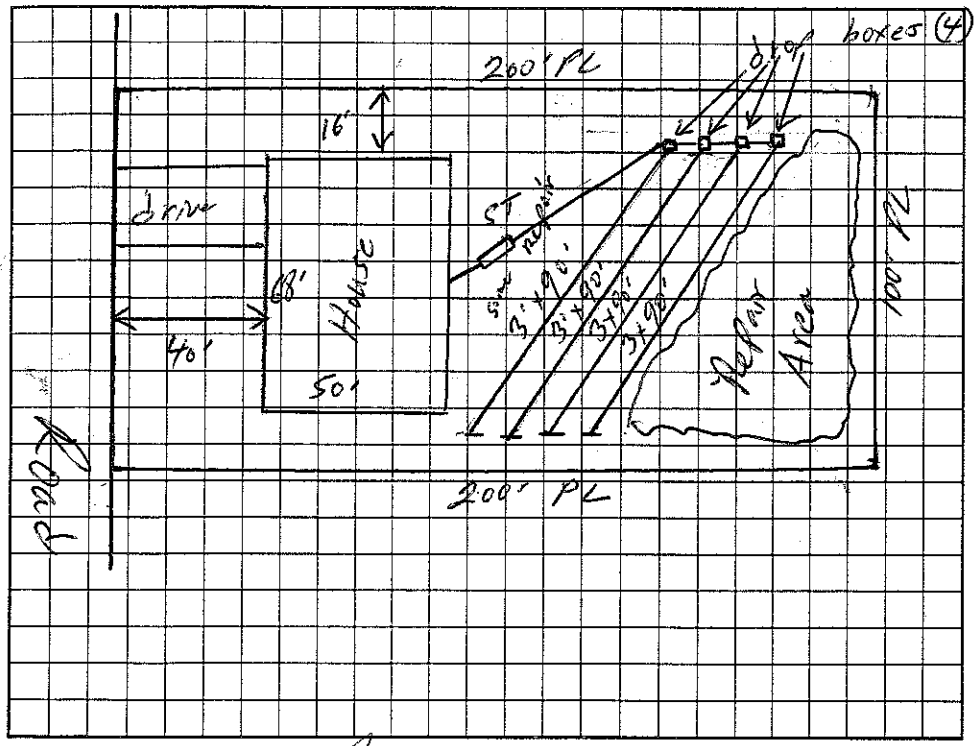

AS BUILT SKETCH

Installed as Shown Per Initial Site Sketch

Permit can be suspended or revoked if any false information is supplied toward securing the permit/any unauthorized changes are made to the site/any unauthorized changes are made in the installation of the system. Improvement Permit with plat valid without expiration. Improvement Permit with site plan valid for sixty months. Authorization to Construct is valid for a period equal to that of Improvement Permit – not to exceed sixty months.

Signed: [signature] date 4/2/2003 Installed by: Steve Jordan

Improvement Permit by: [signature] date 4/2/03 Operation Permit by: [signature] date 7/24/03

Authorization to Construct by: [signature] date 4/2/03 Existing System Inspection by: — date —

HEALTH DEPT. COPY: WHITE OWNER COPY (FINAL): YELLOW OWNER COPY (INITIAL): PINK