IREDELL COUNTY HEALTH DEPARTMENT

STATESVILLE 704-878-5305 CI MOORESVILLE 704-664-5281

IMPROVEMENT PERMIT / AUTHORIZATION TO CONSTRUCT / OPERATION PERMIT / EXISTING SYSTEM INSPECTION

PERMIT# 117296 PIN# 4726-03-5414 DATE 12/23/03

OWNER OR CONTRACTOR Sonoma Builders Inc PHONE: Business (704) 376-6571 Home —

ADDRESS 1655 Scotland Ave. Charlotte N.C. 28207

LOCATION Hwy 115 N. @ Scotts Creek Rd. Cen Celtic Ridge, @ W. Edenburgh, 2nd lot on Right

SUBDIVISION Celtic Ridge BLOCK / SECTION — LOT 39' LOT AREA .461 Ac. SITE CLASS. #5 DESIGN FLOW 360 L.T.A.R. .25 gpd/ft²

Septic Tank: 4000 Gallons; STB 1012 Date 1-3-04
Pump Tank: — Gallons; PT — Date —
Pump Make: — Model Equal to Serial No. —
Nitrification Field: No Fields 1 Square Feet 1440 Linear Feet 360
No Lines 6 Trench Width 36" Max Trench Bottom Depth 30" Gravel Depth N/A

☒ New System ☐ Repair System Type: I, II, III, IV, V, VI
System Description: Gravity, 25% Reduction
Repair System Description: Pump, Low Pressure Pipe
Maintenance Agreement Required: ☐ Yes ☐ No


☒ House/Mod. Home No. Bedrooms 3
☐ Mobile Home No. Bathrooms 2
☐ Business No. Employees —
☐ Other —
☐ Slab ☒ Crawl Space ☐ Basement w/plumbing ☐ Basement wo/plumbing

Water Supply: ☐ Individual ☒ Public ☐ Community


Comments:/Conditions: ① Install lines on contour ② Sewage collection stub out of house must remain high to prevent septic system from being pump system.

Comments:/Conditions: - Tuff-Tite filter + ST marker
- Infiltrator Chambers Installed (58)

INITIAL SITE SKETCH Scale 1" = 40 Ft

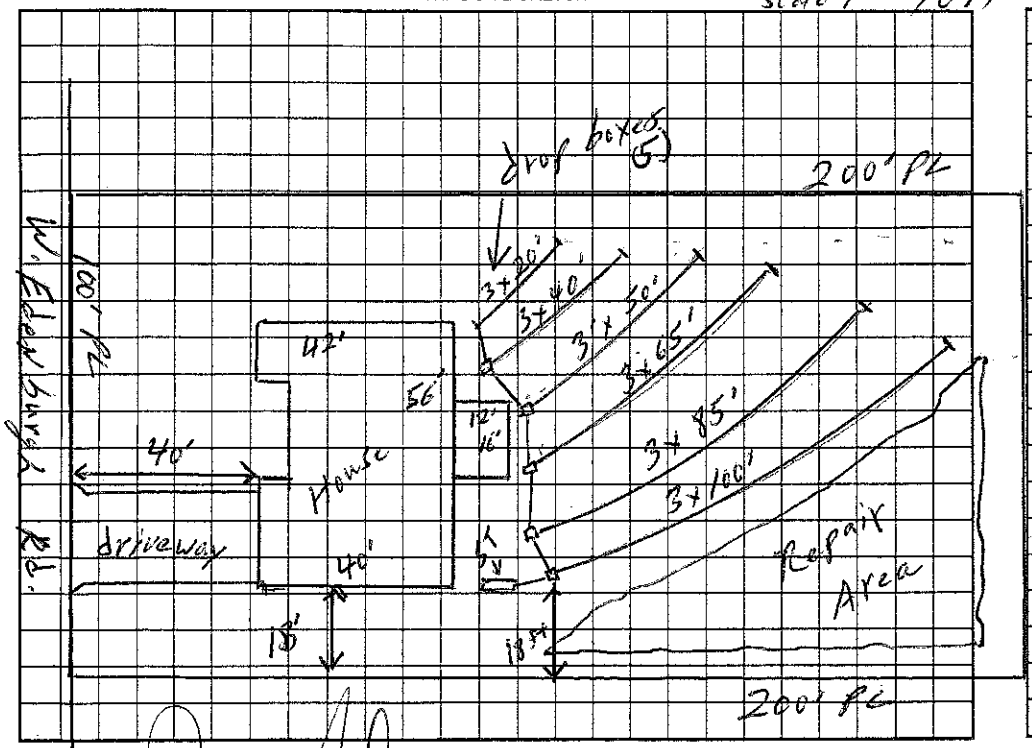

AS BUILT SKETCH

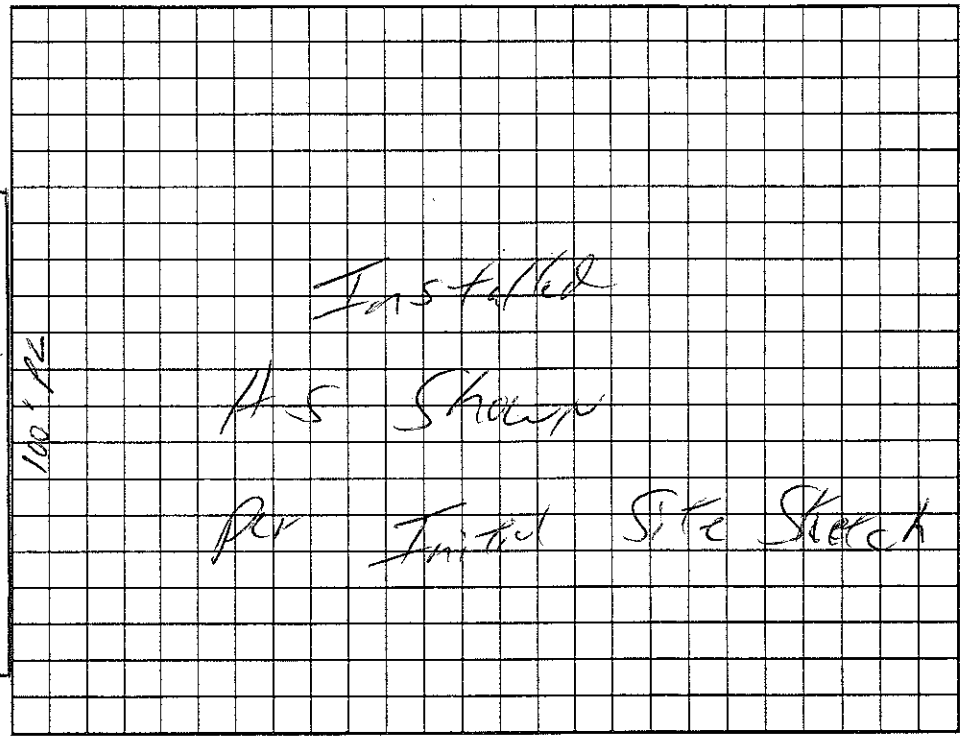

Permit can be suspended or revoked if any false information is supplied toward securing the permit/any unauthorized changes are made to the site/any unauthorized changes are made in the installation of the system. Improvement Permit with plat valid without expiration. Improvement Permit with site plan valid for sixty months. Authorization to Construct is valid for a period equal to that of Improvement Permit – not to exceed sixty months.

Signed: — date —

Improvement Permit by: William O. Johnson date 12/23/03

Authorization to Construct by: William O. Johnson date 12/23/03

Installed by: Steve Jordan

Operation Permit by: William O. Johnson date 6-1-04

Existing System Inspection by: — date —

HEALTH DEPT. COPY: WHITE OWNER COPY (FINAL): YELLOW OWNER COPY (INITIAL): PINK