IREDELL COUNTY HEALTH DEPARTMENT

STATESVILLE 704-878-5305 cj MOORESVILLE 704-664-5281

IMPROVEMENT PERMIT / AUTHORIZATION TO CONSTRUCT / OPERATION PERMIT / EXISTING SYSTEM INSPECTION

PERMIT# 111529 PIN# 4726-03-~~3888.7~~ 7127 DATE 3/28/03

OWNER OR CONTRACTOR Petree / Styron Builders LLC PHONE: Business (828)478-5083 Home —

ADDRESS 2700 Trent Pines Court Denrills Ford, N.C 28673

LOCATION Hwy 115 N @ Scotts Creek @ Celtic Ridge @ on Edinburgh on right Corner

SUBDIVISION Celtic Ridge BLOCK / SECTION — LOT 7 LOT AREA .459 Ac. SITE CLASS. 5 DESIGN FLOW 360 L.T.A.R. .25 sq ft/ft²

Septic Tank: 1000 Gallons; STB 1012 Date 2-25-03
Pump Tank: — Gallons; PT — Date —
Pump Make: — Model — Serial No. —
Nitrification Field: No Fields 1 Square Feet Reduction 1440 Linear Feet 360
No Lines 4@90 Trench Width 36" Max Trench Bottom Depth 30 Gravel Depth NA

☒ New System ☐ Repair System Type: I, II, (III), IV, V, VI
System Description: 25% Reduction Gravity
Repair System Description: 50% Reduction Pump
Maintenance Agreement Required: ☐ Yes ☒ No

☒ House/Mod. Home No. Bedrooms 3
☐ Mobile Home No. Bathrooms 2
☐ Business No. Employees —
☐ Other —
☐ Slab ☒ Crawl Space ☐ Basement w/plumbing ☐ Basement wo/plumbing


Water Supply: ☐ Individual ☒ Public ☐ Community

Comments:/Conditions:


Comments:/Conditions:

ST marker + Tuft - Tile to be Confirmed
-58 Inst Probe Chamber Footage (14,13,15,14)

INITIAL SITE SKETCH 1" = 40'

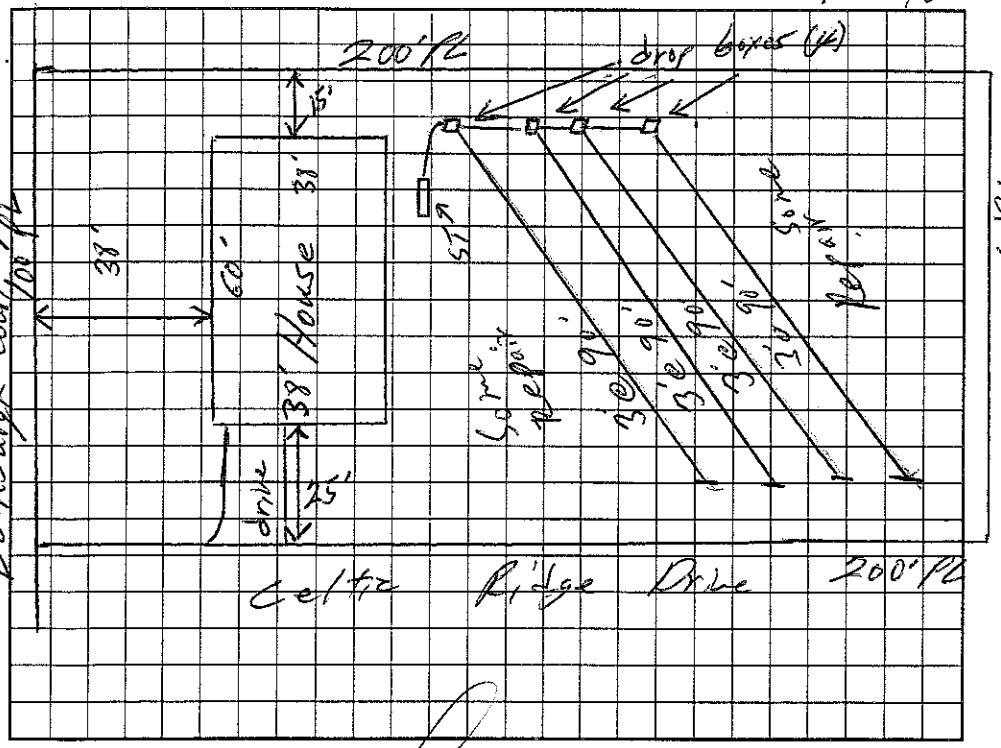

AS BUILT SKETCH

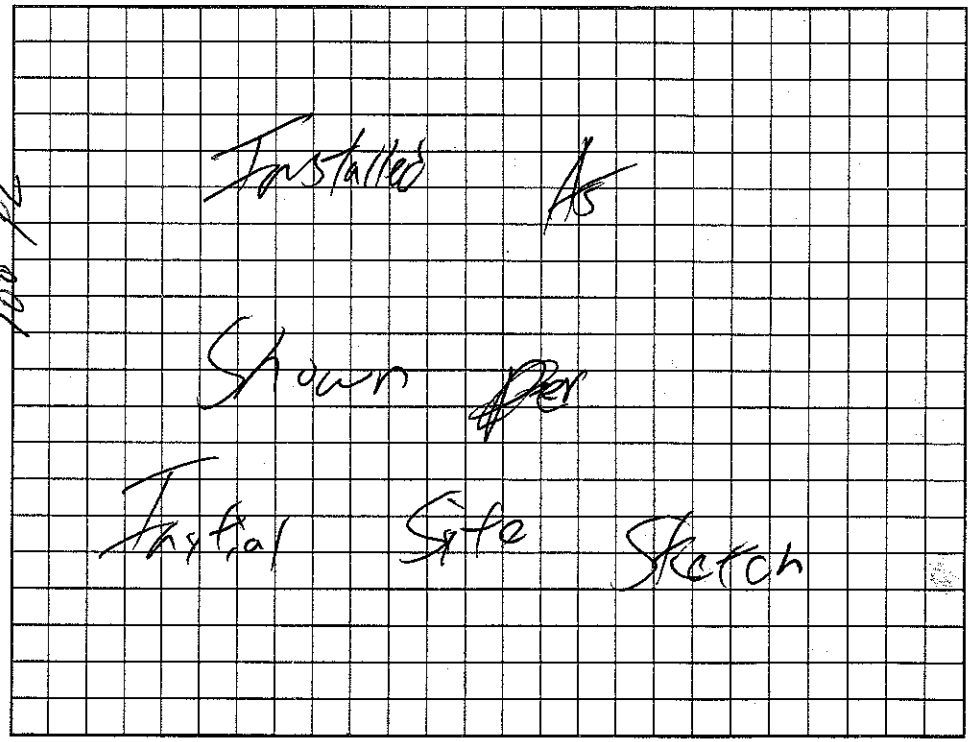

Permit can be suspended or revoked if any false information is supplied toward securing the permit/any unauthorized changes are made to the site/any unauthorized changes are made in the installation of the system. Improvement Permit with plat valid without expiration. Improvement Permit with site plan valid for sixty months. Authorization to Construct is valid for a period equal to that of Improvement Permit – not to exceed sixty months.

Signed: [signature] date 3/31/03
Improvement Permit by: William O. Johnson date 3/28/03
Authorization to Construct by: William O. Johnson date 3/28/03

Installed by: Steve Jordan
Operation Permit by: William O. Johnson date 7/24/03
Existing System Inspection by: — date —

HEALTH DEPT. COPY: WHITE OWNER COPY (FINAL): YELLOW OWNER COPY (INITIAL): PINK