IREDELL COUNTY HEALTH DEPARTMENT

STATESVILLE 704-878-5305 MOORESVILLE 704-664-5281

IMPROVEMENT PERMIT / AUTHORIZATION TO CONSTRUCT / OPERATION PERMIT / EXISTING SYSTEM INSPECTION

PERMIT# 117646 PIN# 4726-03-7461 DATE 1/28/04

OWNER OR CONTRACTOR Petree/Stynes Builders PHONE: Business (704) 902-4607 Home

ADDRESS 2700 Trent River Ct Sherrills Ford, N.C. 28673

LOCATION Hwy 115 N. @ Scotts Creek Rd, @ on Celtic Ridge Dr. @ on E. Edinburgh + Celtic Ridge Corner

SUBDIVISION Celtic Ridge BLOCK / SECTION — LOT 1 LOT AREA ± .463 Acres SITE CLASS. P5 DESIGN FLOW 360 L.T.A.R. ± .25

Septic Tank: 4000 Gallons; STB 1617 Date 10-3-05

Pump Tank: 4000 Gallons; PT 17 Date 2-15-06

Pump Make: Gaylds ½HP Model WE03L2M4 Serial No.

Nitrification Field: No Fields 1 Square Feet Min to 1440 Linear Feet 360

No Lines 5 @ 72' Trench Width 36" Max Trench Bottom Depth 32" Gravel Depth NA

☒ New System ☐ Repair System Type: I, II, III, IV, V, VI

System Description: Pump, 25% Reduction

Repair System Description: Pump, LP Panel

Maintenance Agreement Required: ☐ Yes ☒ No

☒ House/Mod. Home ☐ Mobile Home ☐ Business ☐ Other

No. Bedrooms 3 No. Bathrooms 2 No. Employees

☐ Slab ☒ Crawl Space ☐ Basement w/plumbing ☐ Basement wo/plumbing

Water Supply: ☐ Individual ☒ Public ☐ Community


Comments:/Conditions: ① Install lines on contour ② maintain proper setbacks

Comments:/Conditions:

Yellow filter

No risers w/ST markers

INITIAL SITE SKETCH Scale 1" = 40 ft

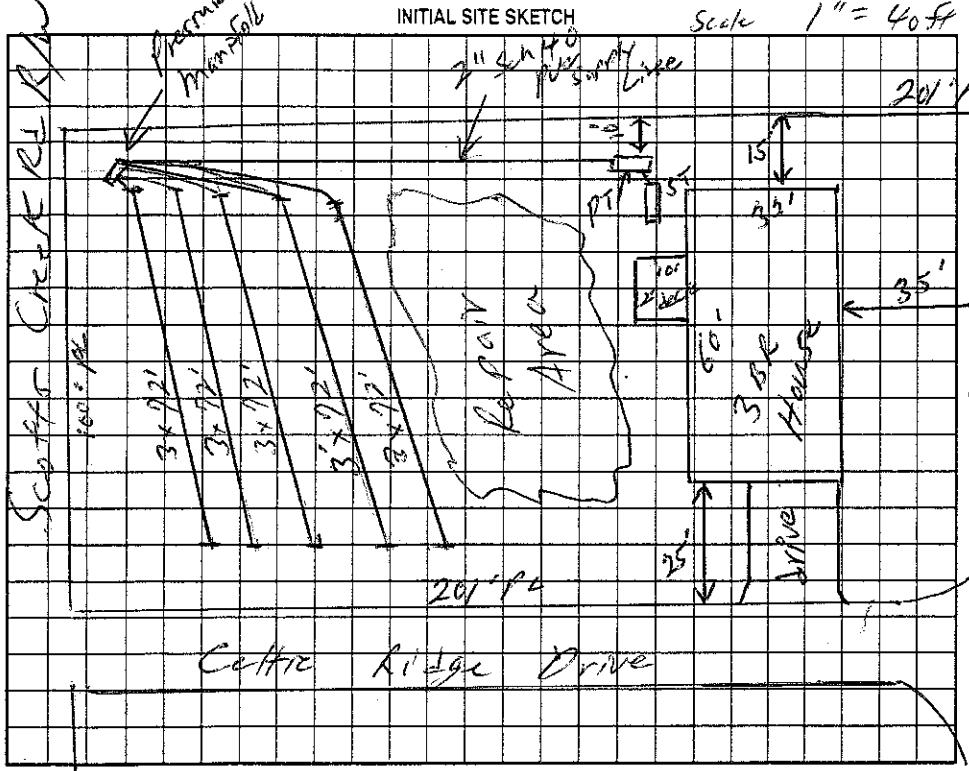

AS BUILT SKETCH

Permit can be suspended or revoked if any false information is supplied toward securing the permit/any unauthorized changes are made to the site/any unauthorized changes are made in the installation of the system. Improvement Permit with plat valid without expiration. Improvement Permit with site plan valid for sixty months. Authorization to Construct is valid for a period equal to that of Improvement Permit – not to exceed sixty months.

Signed: Becky Petree date 1/22/04

Improvement Permit by: William O. Johnson date 1/28/04

Authorization to Construct by: William O. Johnson date 1/28/04

Installed by: Steve Jordan

Operation Permit by: Kyle Cook date 8-11-07

Existing System Inspection by: date

HEALTH DEPT. COPY: WHITE OWNER COPY (FINAL): YELLOW OWNER COPY (INITIAL): PINK