IREDELL COUNTY HEALTH DEPARTMENT

STATESVILLE 704-878-5305 (CT) MOORESVILLE 704-664-5281

IMPROVEMENT PERMIT / AUTHORIZATION TO CONSTRUCT / OPERATION PERMIT / EXISTING SYSTEM INSPECTION

(CJ)

PERMIT# 117647 PIN# 4726-03-8369 DATE 1/28/04

OWNER OR CONTRACTOR Petree / Styrom Builders PHONE: Business (704) 902-4609 Home —

ADDRESS 2700 Trent River Ct Sherrills Ford, N.C. 28673

LOCATION Hwy 115 N, (L) Scotts Creek Rd, (L) on Celtic Ridge Dr. (L) on E. Edinburgh Dr N 1057

SUBDIVISION Celtic Ridge BLOCK / SECTION — LOT 2 LOT AREA .463 Acres SITE CLASS. PS DESIGN FLOW 360 L.T.A.R. .25 gpd/ft²

Septic Tank: 4000 Gallons; STB 1012 Date 5-28-05
Pump Tank: 4000 Gallons; PT 17 Date 4-10-05
Pump Make: GOULDS Model WE0512HD10 Serial No. B053875
Nitrification Field: No Fields 1 Square Feet Each to 1440 Linear Feet 360
No Lines 4@90 Trench Width 36" Max Trench Bottom Depth 32" Gravel Depth N/A

☒ New System ☐ Repair System Type: I, II, III, IV, V, VI
System Description: Pump 25% Reduction
Repair System Description: Pump, Low Pressure Panel
Maintenance Agreement Required: ☐ Yes ☒ No

☒ House/Mod. Home No. Bedrooms 3
☐ Mobile Home No. Bathrooms 2
☐ Business No. Employees —
☐ Other


☐ Slab ☒ Crawl Space ☐ Basement w/plumbing ☐ Basement wo/plumbing

Water Supply: ☐ Individual ☒ Public ☐ Community


Comments:/Conditions: (1) Install lines on Contour (2) maintain proper setbacks (3) Do Not install when wet

Comments:/Conditions: SEPTIC TANK WITH MARKER INSTALLED USING "TUFFTITE" FILTER V.D EVERYTHING OK 8-30-05

INITIAL SITE SKETCH

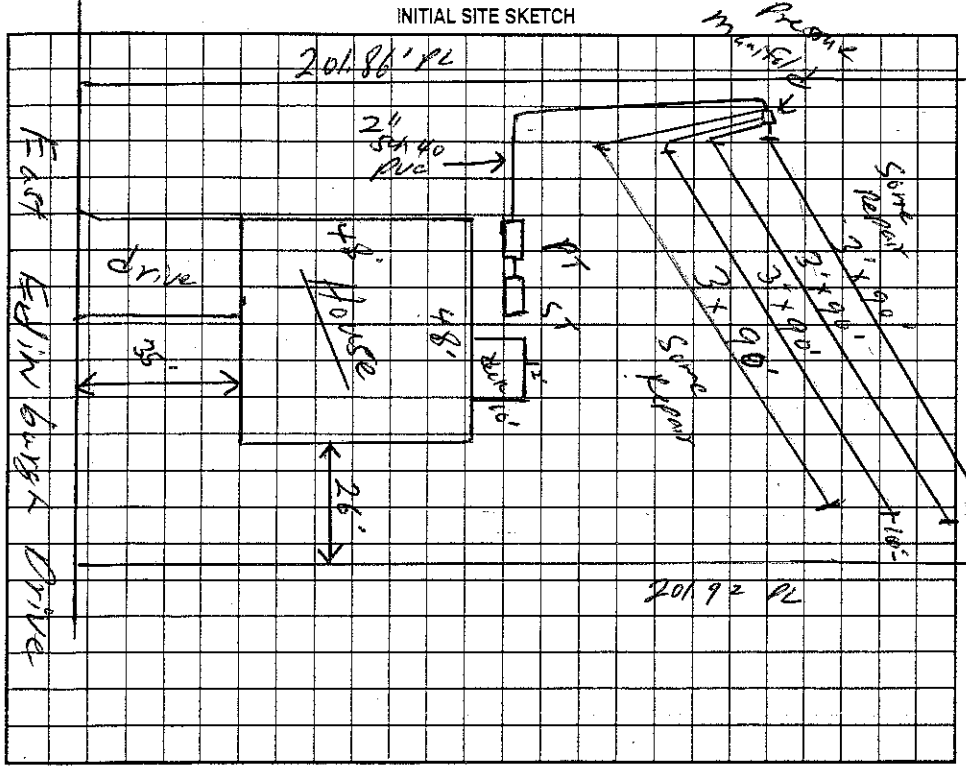

AS BUILT SKETCH

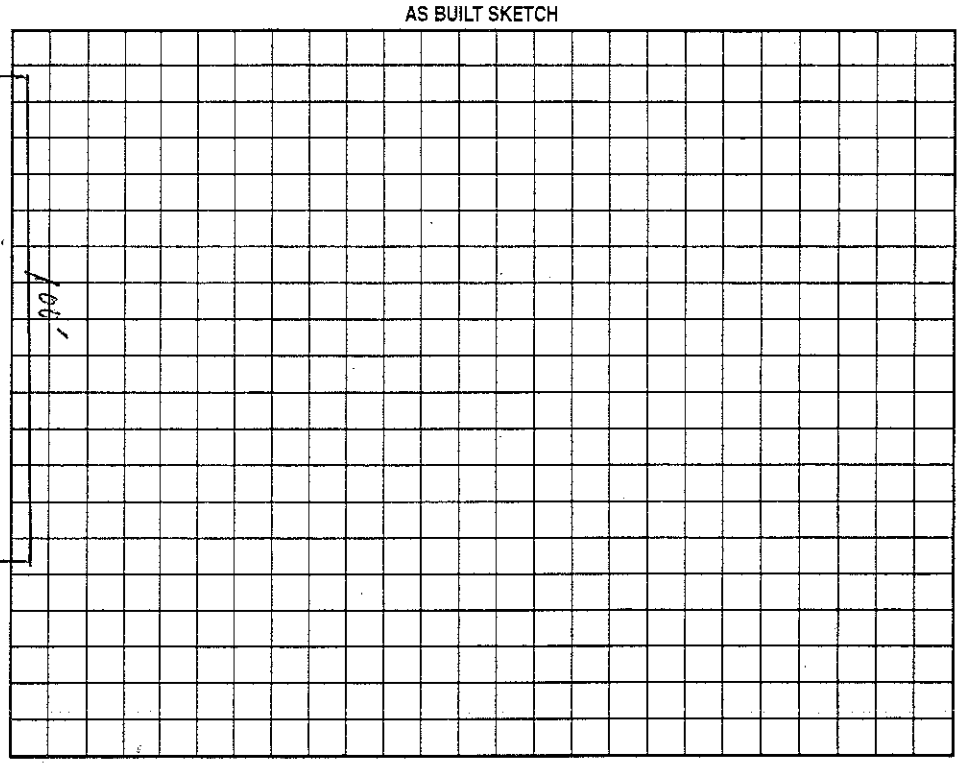

Permit can be suspended or revoked if any false information is supplied toward securing the permit/any unauthorized changes are made to the site/any unauthorized changes are made in the installation of the system. Improvement Permit with plat valid without expiration. Improvement Permit with site plan valid for sixty months. Authorization to Construct is valid for a period equal to that of Improvement Permit – not to exceed sixty months.

Signed: Drew Petree date 4/22/04 Installed by: PIEDMONT BACKHOE

Improvement Permit by: William O Johnson date 1/28/04 Operation Permit by: [signature] date 8-30-05

Authorization to Construct by: William O Johnson date 1/28/04 Existing System Inspection by: — date —

HEALTH DEPT. COPY: WHITE OWNER COPY (FINAL): YELLOW OWNER COPY (INITIAL): PINK