IREDELL COUNTY HEALTH DEPARTMENT

Statesville Phone TR 3-7271 Mooresville Phone NO 3-1271

PERMIT TO INSTALL SEPTIC TANK

Permit NO. _____ Permit Date Dec. 3 19 66

Owner Sam Arrington Address Off Scotts Rd.

Installed By CLYDE HOKE Address Rt. 7, city


Location of Property Left on Scotts Rd out 115 N - before Marsh McLaws Dairy - 2 mile on left. Brad a Day Poultry

Tank		Capacity		Length of Lines		Fixtures	
Block	( )	800	( )	150'	( )	No. of Baths	(4)
Precast	(4)	900	( )	175'	( )	Dishwasher	( )
Lash		1000	(4)	200'	( )	Garbage Grdr.	( )
		1100	( )	225'	(4)	Auto-Washer	(1)
		1200	( )	250'	( )	Other	
		Other		Other			

NOTIFY HEALTH DEPARTMENT AT LEAST EIGHT HOURS BEFORE TANK IS TO BE INSPECTED.

Final Inspection 12-3 19 66 Approved (4) ~~Disapproved~~ ( )

Remarks No well on Property

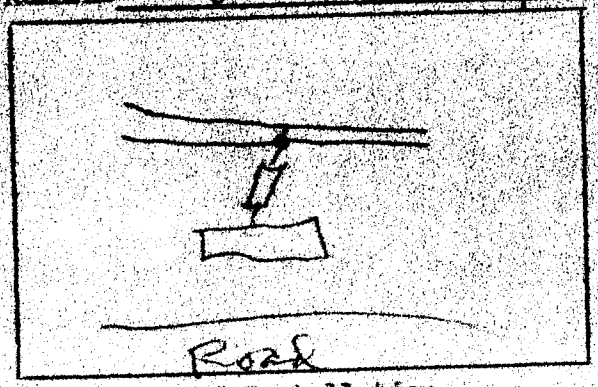

Sketch of Installation

Rut

Sanitarian