IREDELL COUNTY HEALTH DEPARTMENT

STATESVILLE 704-878-5305 MOORESVILLE 704-664-5281

IMPROVEMENT PERMIT / AUTHORIZATION TO CONSTRUCT / OPERATION PERMIT / EXISTING SYSTEM INSPECTION

PERMIT# 09298 PIN# 4726 23 1437 DATE 11-27-00

OWNER OR CONTRACTOR J. R. WILLARD PIERCE PHONE: Business Home 873-1042

ADDRESS 552 SCOTTS CREEK RD STATESVILLE, NC 28625

LOCATION NC 115 N, TL SCOTTS CREEK RD, MH ON RIGHT AT BOX # 552

SUBDIVISION BLOCK / SECTION LOT LOT AREA 1.25 ACRES SITE CLASS PS DESIGN FLOW 360 L.T.A.R. 0.30 GPD/FT²

Septic Tank: 1000 EXISTING Gallons; STB Date

Pump Tank: Gallons; PT Date

Pump Make: Model Serial No.

Nitrification Field: No Fields 1 Square Feet 420 Linear Feet 140

No Lines TWO Trench Width 36" Max Trench Bottom Depth 36" Gravel Depth 12"

☒ New System ☐ Repair System Type: I (II) III, IV, V, VI

System Description: CONVENTIONAL GRAVITY

Repair System Description: CONV. GRAVITY

Maintenance Agreement Required: ☐ Yes ☒ No

☐ House/Mod. Home No. Bedrooms 3

☒ Mobile Home No. Bathrooms 2

☐ Business No. Employees

☐ Other


☐ Slab ☒ Crawl Space ☐ Basement w/plumbing ☐ Basement wo/plumbing

Water Supply: ☒ Individual ☐ Public ☐ Community WELL

Comments:/Conditions: REPLACE EXISTING DIST. BOX AS SHOWN. FEED OLD & NEW LINES EVENLY.

Comments:/Conditions: SEPTIC TANK PUMPED-OUT, NEW SANITARY TEE INSTALLED

INITIAL SITE SKETCH

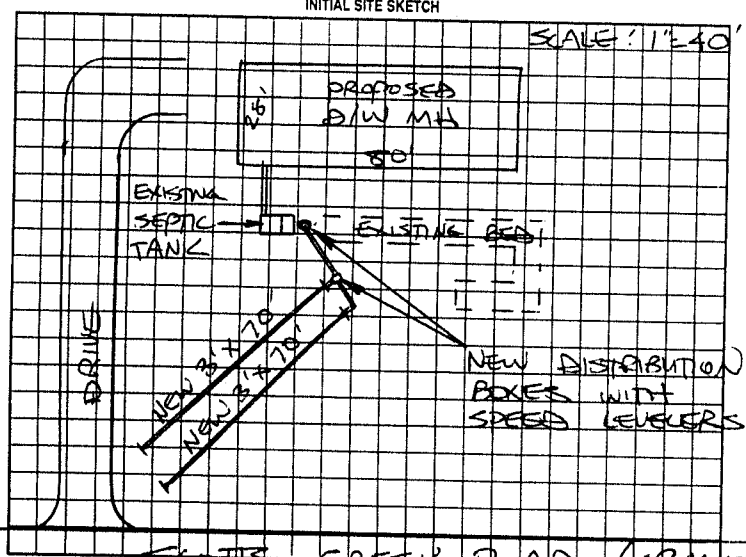

AS BUILT SKETCH

SYSTEM EXPANDED ACCORDING TO INITIAL SITE SKETCH

Permit can be suspended or revoked if any false information is supplied toward securing the permit/any unauthorized changes are made to the site/any unauthorized changes are made in the installation of the system. Improvement Permit with plat valid without expiration. Improvement Permit with site plan valid for sixty months. Authorization to Construct is valid for a period equal to that of Improvement Permit – not to exceed sixty months.

Signed: J R W Pierce date 11-27-00 Installed by: MARK BYER GRADING

Improvement Permit by: STEVE HEDRICK date 11-27-00 Operation Permit by: STEVE HEDRICK date 12-4-00

Authorization to Construct by: STEVE HEDRICK date 11-27-00 Existing System Inspection by: date

HEALTH DEPT. COPY: WHITE OWNER COPY (FINAL) YELLOW OWNER COPY (INITIAL) PINK