ICHD - ENVIRONMENTAL HEALTH DIVISION

Statesville Office (704) 878-5305 Mooresville Office (704) 660-3625

PERMIT # AP-315722

SEPTIC: IMPROVEMENT PERMIT / AUTHORIZATION TO CONSTRUCT / OPERATION PERMIT / EXISTING SYSTEM

PIN # 4726--27--9911

APPLICANT/OWNER: DON CLAYTON/MGI PROPERTIES APPLICANT ADDRESS: 3501 MOUNTAIN HILL DRIVE, WAKE FOREST, N.C. 27587

SITE ADDRESS: 183 SAMS WAY, STATESVILLE, N.C. 28625 PHONE: 919-422-6631 ALT. PHONE —

SITE DIRECTIONS: (N) ON 115; (L) ON MIDWAY, (L) ON SHORT DOG, (R) ON SAMS, LOT ON (L) SAP CONTROLLED: ☐ YES ☑ NO

SUBDIVISION: BEAGLE RUN SECTION: 2 LOT # 34 LOT AREA: 0.75 AC DESIGN FLOW: 480GPD L.T.A.R.: 0.225


Septic Tank	1000 (gal)	STB	1012	Date	11-15-2021	☑ New System	☐ Repair	☐ Expansion	System Type: I II (III) IV V VI	☑ Residence	No. Bedrooms 4
Pump Tank	— (gal)	PT	—	Date	—	System Description:			50% REDUCTION	☐ Business	No. Persons 8
Pump Make	—	Model	—	Serial #	—	Repair System Description:			50% REDUCTION	☐ Other	No. Employees
# Nitrification Fields	1	# Lines	6	Lincar Ft	360FT	Maintenance Agreement Required:	☐ YES	☑ NO		☐ Slab	☑ Crawl Space
Trench Width	24 IN	Trench Bottom Depth (Low side)	32 IN	Gravel Depth	—		☑ GRAVITY	☐ PRESSURE		☐ Basement w/plumbing	☐ Basement w/o plumbing

Water Supply: ☐ Private ☑ Public ☐ Community

Comments / Conditions: INSTALL ON CONTOUR, INSTALL ON 8FT CENTERS UTILIZE EQUAL DISTRIBUTION BY USING D-BOX, DO NOT EXCEED A 36 IN TRENCH BOTTOM, DONOT SHALLOW UP

83 PANELS REQUIRED

INITIAL SITE SKETCH

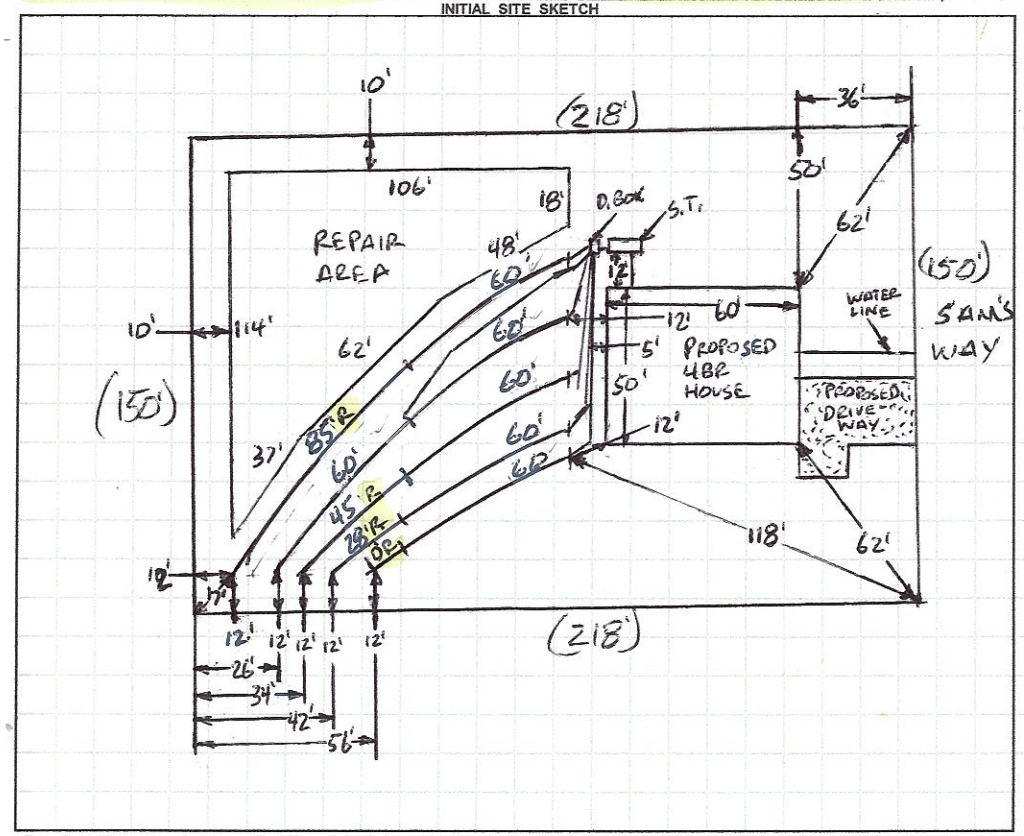

AS BUILT SKETCH

FOR SEPTIC FINAL INSPECTION CALL: 704-664-3703 between 8am-9am the day the inspection is needed. Be sure to speak with an inspector to confirm your time.

TANK & D-BOX CHECKED 1-28-2022

1 IN = 60 FT
S.T. = SEPTIC TANK
R = REPAIR

Permit can be suspended or revoked if any false information is supplied toward securing the permit / any unauthorized changes are made to the site / any unauthorized changes are made in the installation of the system. **CONTACT A LOCATOR SERVICE PRIOR TO ANY EXCAVATION**

☐ **IMPROVEMENT PERMIT** *with plat valid without expiration.* ☑ **IMPROVEMENT PERMIT** *with site plan valid for 60 mos.* ☑ **AUTHORIZATION TO CONSTRUCT** *valid for period equal to IMPROVEMENT PERMIT--not to exceed 60 mo.*

Owner / Applicant Signature: _____ Date: 5-26-21 Installed by: (STEVE JORDAN) Piedmont Backhoe Service

IMPROVEMENT PERMIT by: Bryant C. Little Date: 5-17-2021 OPERATION PERMIT by: _____ Date: 2-16-2022

AUTHORIZATION TO CONSTRUCT by: Bryant C. Little Date: 5-21-2021 Existing System Inspected by: _____ Date: _____

FOR SEPTIC FINAL INSPECTION: CALL 704-664-3703 between 8am-9am the day the inspection is needed.

DEPARTMENT OF HEALTH AND HUMAN SERVICES
DIVISION OF PUBLIC HEALTH, ENVIRONMENTAL HEALTH SECTION
ON-SITE WATER PROTECTION BRANCH

Sheet 1 of 1
PROPERTY ID #: 4726-27-99
COUNTY: IREDELL

SOIL/SITE EVALUATION
for ON-SITE WASTEWATER SYSTEM
(Complete all fields in full)

OWNER: MGI PROPERTIES / DON CLAYTON
ADDRESS: 3501 MOUNTAIN HILL DRIVE, WAKE FOREST, N.C. 27587
PROPOSED FACILITY: 4 BR
PROPOSED DESIGN FLOW (.1949): 480GPD
LOCATION OF SITE: 183 SAMS WAY, STATESVILLE, N.C. 28625
APPLICATION DATE 3-10-2021
DATE EVALUATED: 4-1-2021
PROPERTY SIZE: 0.75 AC
PROPERTY RECORDED: YES
WATER SUPPLY: ☐ Private ☑ ~~Public~~ ☐ Well ☐ Spring ☐ Other
EVALUATION METHOD: ☐ Auger Boring ☑ ~~Pit~~ ☐ Cut
TYPE OF WASTEWATER: ☑ ~~Sewage~~ ☐ Industrial Process ☐ Mixed

PROFILE #	.1940 LANDSCAPE POSITION/ SLOPE %	HORIZON DEPTH (IN.)	SOIL MORPHOLOGY (.1941) .1941 STRUCTURE/ TEXTURE	SOIL MORPHOLOGY (.1941) .1941 CONSISTENCE/ MINERALOGY	OTHER PROFILE FACTORS .1942 SOIL WETNESS/ COLOR	.1943 SOIL DEPTH	.1956 SAPRO CLASS	.1944 RESTR HORIZ	PROFILE CLASS & LTAR
1	~~LINEAR~~ HEAD 5%	0-15	SCL, SBK	~~FR~~, SS, SP, SEXP	COLLUVIAL FEW SAP INC THRU OUT R/B MATRIX	63"+	NA	NA	PS .3 .225 DUE TO LAND SCAPE
		15-63	C, SBK	FR, S, P, SEXP					
2	HEAD 7%	0-18	SCL, SBK	~~FR~~, SS, SP, SEXP	COLLUVIAL FEW SAP INC THRU OUT R/B MATRIX	69"+	NA	NA	PS .3
		18-52	C, SBK	~~FR~~, SS, P, SEXP					
		52-69	CL, WSBK	~~FR~~, SS, SP, SEXP					
3	LINEAR SIDE 7%	0-6	SCL, SBK	FR, SS, SP, SEXP	FEW SAP INC THRU OUT	70"+	NA	NA	PS .3
		6-40	C, SBK	FR, S, P, SEXP					
		40-70	CL, WSBK	FR, SS, SP, SEXP					
4	~~LINEAR SIDE~~ HEAD 3%	0-12	SCL, SBK	FR, SS, SP, SEXP	FEW SAP INC THRU OUT	66"+	NA	NA	PS .225 DUE TO LANDSCAPE
		12-40	C, SBK	FR, S, P, SEXP					
		40-66	CL, SBK	FR, SS, SP, SEXP					

DESCRIPTION	INITIAL SYSTEM	REPAIR SYSTEM
Available Space (.1945)	PS	PS
System Type(s)	50%	50%
Site LTAR	.225	.225

OTHER FACTORS (.1946): PS
SITE CLASSIFICATION (.1948): PS
EVALUATED BY: Bryant C. Collette
OTHER(S) PRESENT:

COMMENTS:

LEGEND

use the following standard abbreviations

LANDSCAPE POSITION	GROUP	SOIL TEXTURE	CONVENTIONAL .1955 LTAR*	LPP .1957 LTAR*	MINERALOGY/ CONSISTENCE	STRUCTURE
CC (Concave Slope)	I	S (Sand)	1.2 - 0.8	0.6 - 0.4	SEXP (Slightly Expansive)	G (Single Grain)
CV (Convex Slope)		LS (Loamy Sand)			EXP (Expansive)	M (Massive)
D (Drainage Way)						CR (Crumb)
DS (Debris Slump)	II	SL (Sandy Loam)	0.8 - 0.6	0.4 - 0.3		GR (Granular)
FP (Flood Plain)		L (Loam)				SBK (Subangular Blocky)
FS (Foot Slope)						ABK (Angular Blocky)
H (Head Slope)	III	Si (Silt)	0.6 - 0.3	0.3 - 0.15		PL (Platy)
L (Linear Slope)		SiCL (Silty Clay Loam)				PR (Prismatic)
N (Nose Slope)		CL (Clay Loam)				
R (Ridge)		SCL (Sandy Clay Loam)			**MOIST**	**WET**
S (Shoulder Slope)		SiL (Silt Loam)				
T (Terrace)					VFR (Very Friable)	NS (Non-sticky)
	IV	SC (Sandy Clay)	0.4 - 0.1	0.2 - 0.05	FR (Friable)	SS (Slightly Sticky)
		SiC (Silty Clay)			FI (Firm)	S (Sticky)
		C (Clay)			VFI (Very Firm v. Very Sticky)	VS (Very Sticky)
		O (Organic)	None	None	EFI (Extremely Firm)	NP (Non-plastic)
						SP (Slightly Plastic)
						P (Plastic)
						VP (Very Plastic)

*Adjust-LTAR due to depth, consistence, structure, soil wetness, landscape, position, wastewater flow and quality.


NOTES

HORIZON DEPTH	In inches below natural soil surface
DEPTH OF FILL	In inches from land surface
RESTRICTIVE HORIZON	Thickness and depth from land surface
SAPROLITE	S(suitable) or U(unsuitable)
SOIL WETNESS	Inches from land surface to free water or inches from land surface to soil colors with chroma 2 or less - record Munsell color chip designation
CLASSIFICATION	S (Suitable), PS (Provisionally Suitable), or U (Unsuitable)

Evaluation of saprolite shall be by pits.

Long-term Acceptance Rate (LTAR): gal/day/ft²

Show profile locations and other site features (dimensions, reference or benchmark, and North).

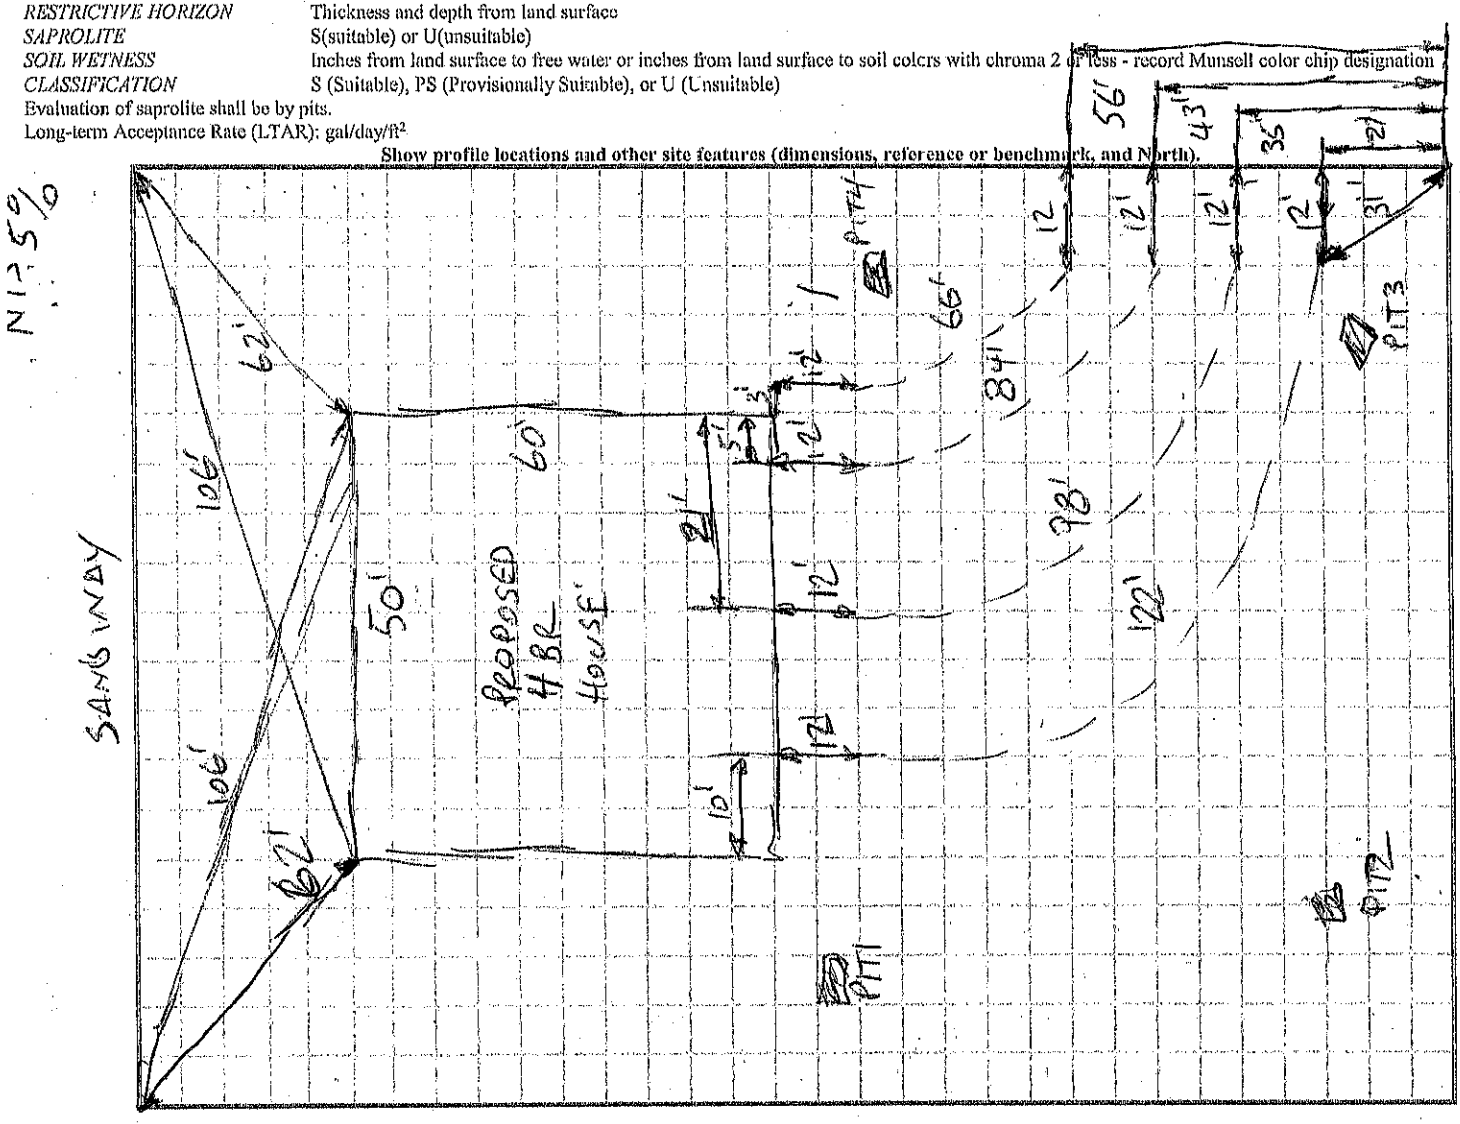

RECEIVED MAR 1 2 2021

APPLICATION MUST BE FILLED OUT COMPLETELY & BE LEGIBLE OR IT WILL NOT BE PROCESSED

Paid $500.00

Iredell County Health Department – Environmental Health Division

AP 315722

PAGE 1: ***APPLICATION FORM***

Application For: ( ) New Well Permit ( ) Well Repair Permit ( ) Well Abandonment
(✓) Septic Improvement Permit ( ) Authorization to Construct ( ) Existing System Inspection ( ) Septic System Repair

THE ABOVE PERMIT DOCUMENTS WILL BECOME INVALID IF INFORMATION PROVIDED ON THIS APPLICATION IS FALSIFIED OR CHANGED, OR IF THE SITE IS ALTERED. THE IMPROVEMENT PERMIT IS VALID FOR EITHER 60 MONTHS OR WITHOUT EXPIRATION DEPENDING UPON DOCUMENTATION SUBMITTED. APPLICATION WITH SITE PLAN 60 MONTHS, APPLICATION WITH COMPLETE, SCALED PLAT WITHOUT EXPIRATION. SEE 15A NCAC 18A .1937(j) FOR DETAILS.

Page 2: ***Site Plan Worksheet*** **form MUST accompany this application**

The following optional attachments may also be submitted: ( ) Survey Plat, scaled no more than 1 inch = 60 feet
Place an (X) beside whichever is submitted if applicable ( ) Custom Site Plan, scaled no more than 1 inch = 60 feet

Applicant Information: (PRINT CLEARLY)

Applicant Name: Don Cayton **Address:** 3501 MOuntain Hill Dr Wake Forest **Zip:** 27587

Applicant Email: don@velocitycmops.com **Phone:** 919-422-6631 **Alt. Phone:**

Owner Name: MGI Props NC 1 LLC **Address:** 15905 Brookway Dr Ste 4201 Huntersville **Zip:** 28078

Owner Email: greystonecrg@gmail.com **Phone:** 919-422-6631 **Alt. Phone:**

Property Information:

Street Address: 183 Sams Way Statesville NC

Subdivision Name: Beagle Run **Section/Phase:** P2 SHT1 **Lot Number:** 34

Driving Directions: I-40; North on NC 115; Left on Midway Rd; Left on Short Dog Dr; Right on Sams Way Dr

Site Development Information: ***(check or complete ALL that apply***

CHECK FOUNDATION TYPE

(X) New Single Family Residence
( ) New Multi-Family Residence
( ) Accessory Building
( ) Bedroom(s) Addition
( ) Repair to failing septic system ___ Tank ___ Drain lines Describe Problem:

Maximum Number of Bedrooms: 4
Maximum Number of Occupants: 4
( ) Swimming Pool
( ) Other Addition/Structure:

(X) Crawl Space Foundation
( ) Concrete Slab Foundation
( ) Basement with Plumbing
( ) Basement without Plumbing

Non-Residential Site Development: Type of Business:
Square Footage of Building: Max. Number of Employees: Max. Number of Seats/Beds/Other:

Water Supply: ( ) Replacement Well – Reason:
( ) Multi-connection Well Number of Houses: Number of Persons:

( ) New Well ( ) Existing Well ( ) Community Well (X) City Water ( ) Other Public Water

Desired Septic System Type: ***(you may rank in order of preference)*** Year existing system installed:
( ) No Preference ( ) Alternative (X) Conventional ( ) Innovative ( ) Modified Conventional ( ) Other:

Please answer the following to the best of your ability:

( ) Yes (X) No Does the site contain any jurisdictional wetlands?
( ) Yes (X) No Is any non-domestic sewage (i.e. industrial) to be generated?
( ) Yes (X) No Is the site subject to approval by any other public agency?

I have read this application and certify that the information provided herein is true, complete, and correct. Authorized county and state officials are granted right of entry to conduct necessary inspections to determine compliance with applicable laws and rules. I understand that I am solely responsible for the proper identification and labeling of all property lines and corners and making the site accessible so that a complete site evaluation can be performed.

Signature: _____ 03/10/21
Property owner or owner's legal representative signature (SIGNATURE REQUIRED) DATE

Public Health

IREDELL COUNTY DEPARTMENT OF ENVIRONMENTAL HEALTH

Public Health

DOCUMENTATION TO AUTHORIZE AN OWNER'S LEGAL REPRESENTATIVE

(Check and sign only ONE of the options below)

☑ **1. * APPLICANT AND OWNER ARE THE SAME. *** *(Sign here)* _____

Applications for permits require the "signature of the owner or owner's legal representative" (15A NCAC 18A .1937). If the owner does not sign the application himself or herself, they can submit any one of the following documents to designate their legal representative: *Power of Attorney; Real Estate Contract; Estate executor; Bankruptcy trustee; Court ordered guardianship*
In the absence of the above documentation, the property owner may provide the local health department with documentation that designates a legal representative. A property owner may:
Complete this form to document his or her legal representative, or provide his or her own form that contains the information in this form. If there are multiple property owners, then all property owners must sign the form that designates a legal representative.
By signing a form that designates a legal representative for purposes of 15A NCAC 18A .1937, the property owner authorizes that representative to act on their behalf in matters pertaining to the application and permitting process, including signing or receiving any application, document or permit. The owner retains full responsibility to meet all permit conditions specified by the local health department.

☐ **2.** I, _____, am the legal owner(s) of the property located at _____, identified as PIN (Parcel Identification Number)_____, located in Iredell County, North Carolina.

I do hereby authorize **(print legal representative/company name)** _____, _____, to act as an agent on my behalf in applying for/signing/obtaining any of the documents described below.

- Application for Improvement Permit (IP) / Authorization to Construct (AC)
- Improvement Permit (IP) / Authorization to Construct (AC)
- Application for soil-site evaluation (new/repair)
- Application/permit for private drinking water well/well abandonment
- Application for Compliance Inspection

I agree to abide by all decisions and/or conditions between the legal representative acting on my behalf and the Iredell County Department of Public Health, Environmental Health Division.


_____ _____
Signature of Owner(s) Date

Mooresville - Environmental Health
Fax: 704-662-3239
610 E. Center Avenue, Mooresville, NC 28115

Statesville - Environmental Health
ronda.hart@co.iredell.nc.us
Fax: 704-871-3483
349 N. Center Street, Statesville, NC 28677

IREDELL COUNTY HEALTH DEPARTMENT
ENVIRONMENTAL HEALTH DIVISION
PAGE 2: *SITE PLAN WORKSHEET*

SEE THE "SAMPLE SITE PLAN" BELOW. *INCOMPLETE SITE PLANS WILL BE RETURNED TO YOU FOR COMPLETION AND MAY RESULT IN A DELAY IN THE ISSUANCE OF YOUR SEPTIC SYSTEM PERMIT!!!*

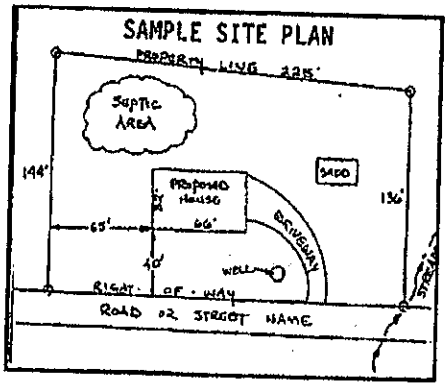

Place an (X) beside each item as you complete the site plan:

( ) **Property Line measurements are clearly identified**
( ) **All proposed structures are indicated**
( ) **Front and side setbacks from property line**
( ) **Preferred driveway location and well location**
( ) **Area you prefer your septic system to be placed**
( ) **North arrow, or other sufficient indicator of direction**

Circle N/A on the following if appropriate:

Location of septic systems and wells within 100' of your property	**N/A**
Location of easements and rights of ways on your property	**N/A**
Location of any designated wetlands on the property	**N/A**

USE THIS SPACE TO DRAW YOUR SITE PLAN


Show: proposed house or business footprint, wells, water lines, patios, pools and decks, and any other item that will occupy space on the site

See attached

Signature: _____

Property owner or owner's legal representative signature (SIGNATURE REQUIRED)

03/10/21
DATE

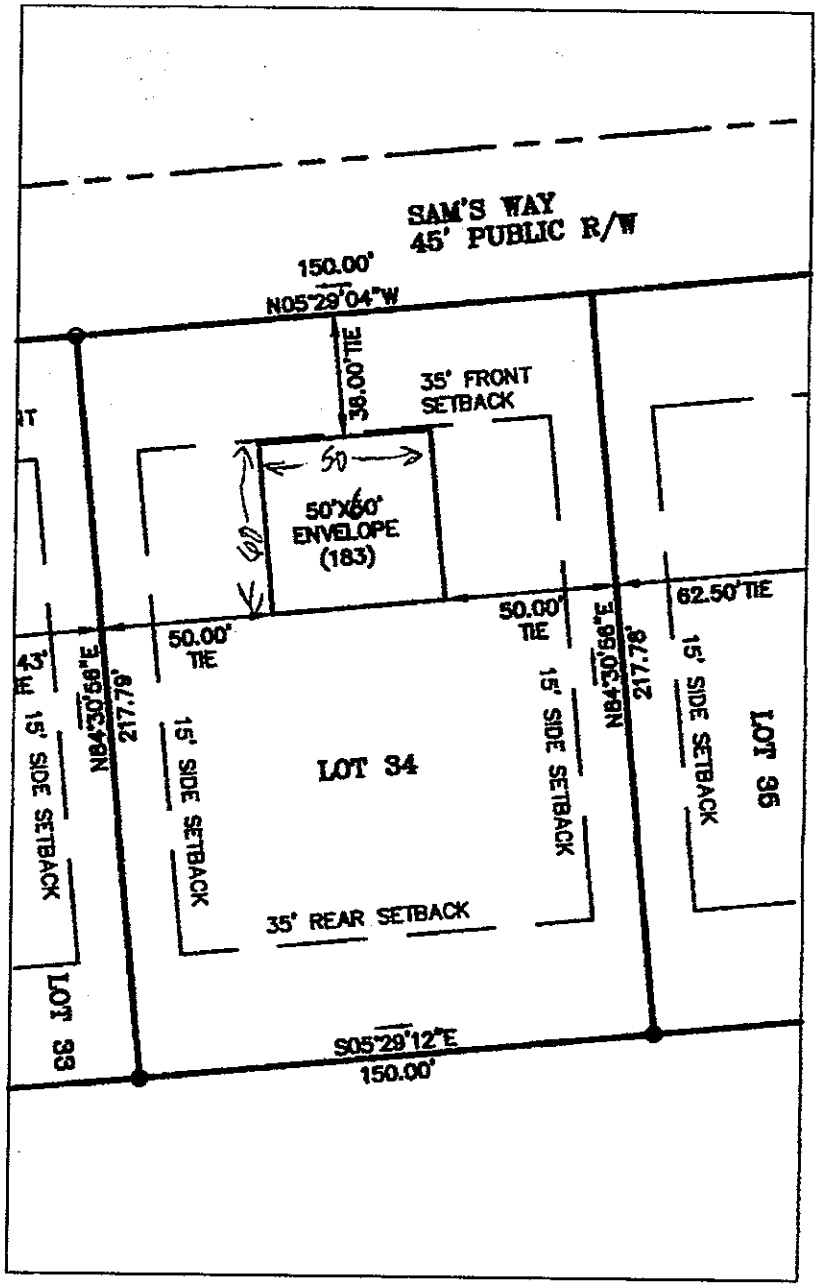

BASIS OF BEARING
NC GRID

PROPOSED HOUSE LAYOUT FOR
LOT 34
BEAGLE RUN SUBDIVISION
PHASE II
PLAT BOOK 57, PAGE 1

183 SAM'S WAY, STATESVILLE, NC

GRAPHIC SCALE


50 0 25 50 100

(IN FEET)
1 inch = 50 ft.

Acknowledgement Of
Plans Submittal ONLY!

Date 05/20/21

Bryant C. White Date 5-21-2021

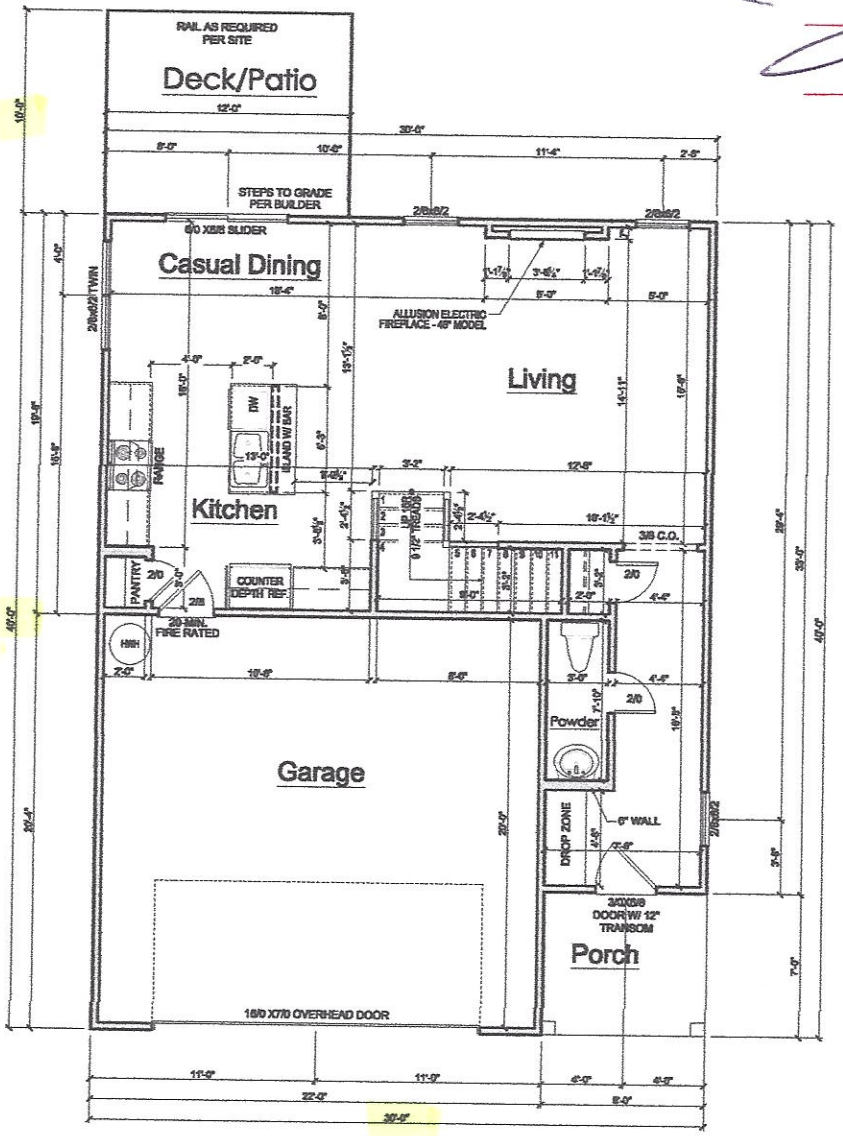

1 FIRST FLOOR PLAN 'A' & 'B'
SCALE: 1/4" = 1'-0"

GENERAL NOTES

WALLS:
ALL WALLS ARE DRAWN 4" THICK U.N.O. ANGLED WALL ARE DRAWN @45° U.N.O.

SMOKE DETECTORS:
LOCATION AND NUMBER OF DETECTORS SHALL CONFORM TO NEC.


EGRESS:
ALL BEDROOMS MUST HAVE AT LEAST ONE WINDOW WHICH CONFORMS TO R-310 OF THE N.C. BLDG. CODE. IT IS THE CONTRACTOR'S RESPONSIBILITY TO VERIFY CHOSEN WINDOWS MEET EGRESS REQUIREMENTS AS MANUFACTURERS VARY.

ATTIC ACCESS:
MIN. ATTIC ACCESS SHALL BE PROVIDED BY BUILDER AND LOCATED ON SITE.

WALL/CEILING HGT.
WALL AND CEILING HEIGHT NOTES ARE BASED ON NOMINAL WALL SIZE
KNEE WALL HEIGHT LABELS FOR WALLS UNDER RAFTERS ASSUME AN EXTRA 2" FOR FURRING (IN HEATED SPACES) FOR INSULATION. THE WALL HEIGHT REFERS TO THE HGT. FROM THE FLOOR DECKING TO THE BOTTOM OF THE FURRING.

NOTE:
HANDRAILS SHALL BE PROVIDE ON AT LEAST ONE SIDE OF STAIR TREADS WITH 4, OR MORE RISERS. VERTICAL HT. OF HANDRAILS SHALL BE NOT LESS THAN 34" AND NO MORE THAN 38" PER NC 2018 RESIDENTIAL CODE SEC. R311.7.8

GUARDS ON ALL HANDRAILS SHALL BE PLACED SO THAT A SPHERE OF 4" CANNOT PASS THROUGH PER NC 2018 RESIDENTIAL CODE SEC. R312.1

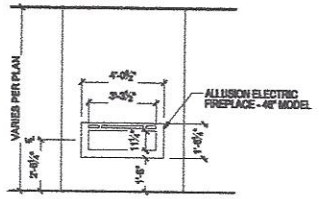

ALLUSION FIREPLACE - INTERIOR ELEV
SCALE: 1/8"=1'-0" ON 11x17, 1/4"=1'-0" ON 22x34

SOUTH DESIGNS
P.O. Box 688
Wake Forest, NC 27588
(O) 919-556-2226
(F) 919-556-2228
www.southdesigns.com

Drawn By:	RWB
Checked By:	RWB
Date:	3-26-2021

Revision No.	Revision Date

Designer Signature

This plan is the property of South Designs, Inc. and may not be used or reproduced without the expressed written consent of South Designs, Inc. These drawings are offered to the owner/client for a conditional one time use. The conditional use is limited to the lot or property as specified herein, and only for said location.

South Designs, Inc. assumes no liability for any items constructed from these plans. Contractor or builder shall verify all dimensions and conditions prior to construction. Caution must be exercised when making changes to these drawings. If changes are made to these drawings, contact South Designs.

Client

PLAN #1764

Title:


FIRST FLOOR PLAN

Plan No.

A-1

Sheet No. Of

© COPYRIGHT 2021SOUTHERN DESIGNS, INC.

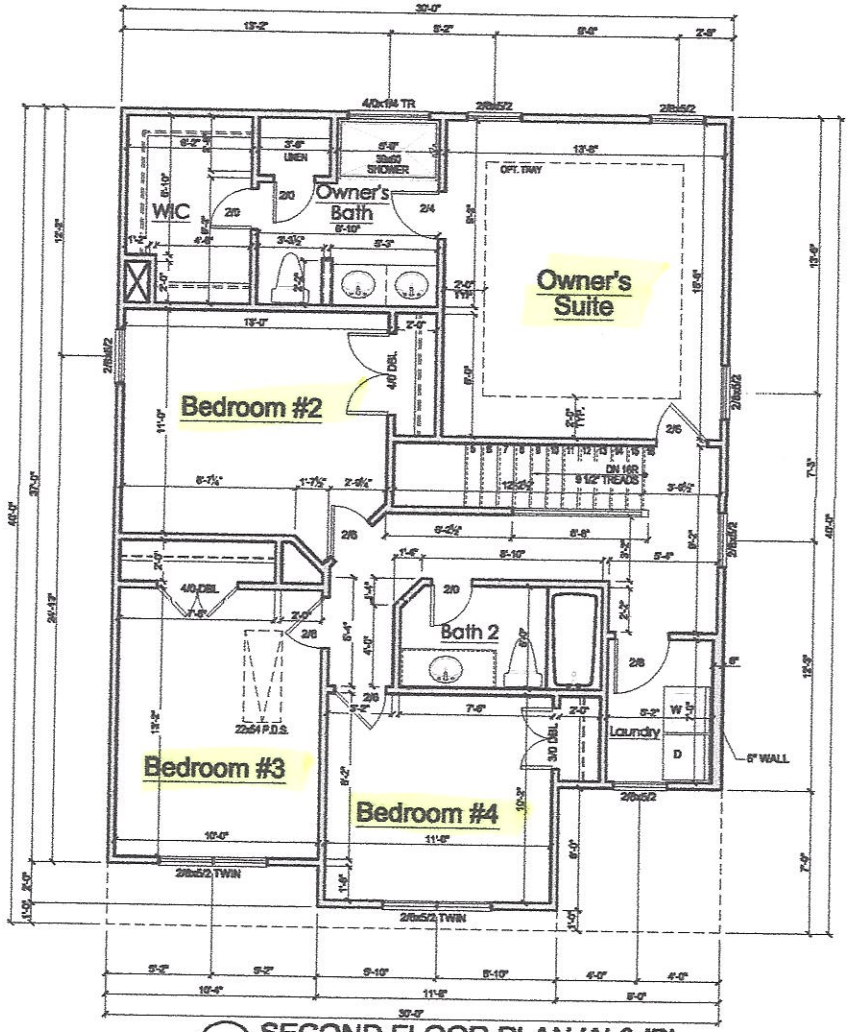

1 SECOND FLOOR PLAN 'A' & 'B'
SCALE: 1/4" = 1'-0"

GENERAL NOTES

WALLS:
ALL WALLS ARE DRAWN 4" THICK U.N.O. ANGLED WALL ARE DRAWN @45° U.N.O.

SMOKE DETECTORS:
LOCATION AND NUMBER OF DETECTORS SHALL CONFORM TO NEC.

EGRESS:
ALL BEDROOMS MUST HAVE AT LEAST ONE WINDOW WHICH CONFORMS TO R-310 OF THE N.C. BLDG. CODE. IT IS THE CONTRACTORS RESPONSIBILITY TO VERIFY CHOSEN WINDOWS MEET EGRESS REQUIREMENTS AS MANUFACTURERS VARY.

ATTIC ACCESS:
MIN. ATTIC ACCESS SHALL BE PROVIDED BY BUILDER AND LOCATED ON SITE.

WALL/CEILING HGT.
WALL AND CEILING HEIGHT NOTES ARE BASED ON NOMINAL WALL SIZE.
KNEE WALL HEIGHT LABELS FOR WALLS UNDER RAFTERS ASSUME AN EXTRA 2" FOR FURRING (IN HEATED SPACES) FOR INSULATION. THE WALL HEIGHT REFERS TO THE HGT. FROM THE FLOOR DECKING TO THE BOTTOM OF THE FURRING.

NOTE:
IF CLEAR OPENING OF THE OPERABLE PORTION OF A WINDOW IS MORE THAN 72" ABOVE GRADE, LOWEST PART OF OPENING MUST BE 24" ABOVE FLOOR UNLESS:

A. WINDOW IS FIXED UNIT
B. OPENING DOES NOT ALLOW PASSAGE 4" d SPHERE
C. WINDOW IS EQUIPPED WITH FALL PREVENTION DEVICE
D. WINDOW IS EQUIPPED WITH AN APPROVED LIMITING DEVICE

Acknowledgement Of Plans Submittal ONLY!

Date 05/20/21

Bryant C. White Date 5-21-2021

© COPYRIGHT 2021SOUTHERN DESIGNS, INC.

SOUTH DESIGNS
P.O. Box 658
Wake Forest, NC 27588
(O) 919-556-2226
(F) 919-556-2228
www.southdesigns.com

Drawn By: RWB
Checked By: RWB
Date: 3-26-2021

Revision No.	Revision Date

Designer Signature

This plan is the property of South Designs, Inc. and may not be used or reproduced without the expressed written consent of South Designs, Inc. These drawings are offered to the named client(s), conditional upon this use. The conditional use is limited to the lot or property on specified work, and only for said client.

South Designs, Inc. assumes no liability for any items constructed from these plans. Contractor or builder shall verify all dimensions and conditions prior to construction. Contractor must be provided written mailing changes to these drawings. Changes are made to these drawings, contact South Designs.

Client:

PLAN #1764

Title:

SECOND FLOOR PLAN

Plan No.

A-2

Sheet No. Of

IREDELL COUNTY · NC

IREDELL COUNTY
PO Box 788
349 North Center St.
Statesville, NC 28677

APPLICATION NUMBER
315722 Issue Date: 03/12/2021

Permit Type: ZONING

Parcel Number	Street Address	Jurisdiction
4726279911.000	183 SAMS WAY	Iredell County

Owner Information	Applicant Information
Name: MGI PROPS NC 1 LLC	Name: DON CAYTON
Address:	Address: 3501 MOUNTAIN HILL DR
	WAKE FOREST, NC 27587
Phone:	Phone:

Use Requested	Zone Code
Single Family Dwelling	R-20

Lot Acreage	F Setback	B Setback	L Setback	R Setback	Watershed	Flood Zone
0	35	35	15	15	N/A	NO

Remarks
SFD

The applicant certifies that there are no deed restrictions, contractual agreements or governmental regulations of any kind that interfere with or prohibit the use of the property or the use for which this permit is requested. The applicant further acknowledges that enforcement of deed restrictions, plat conditions and other contractual agreements will not be undertaken by Iredell County and is the sole responsibility of the affected parties.

Date: 03/12/2021

Signature of Owner/Contractor


Permit Number	315722

TOTAL FEES:	$77.25

315722

R-20 .75 AC
WS-NO
FL-NO

ZONING DISCLAIMER

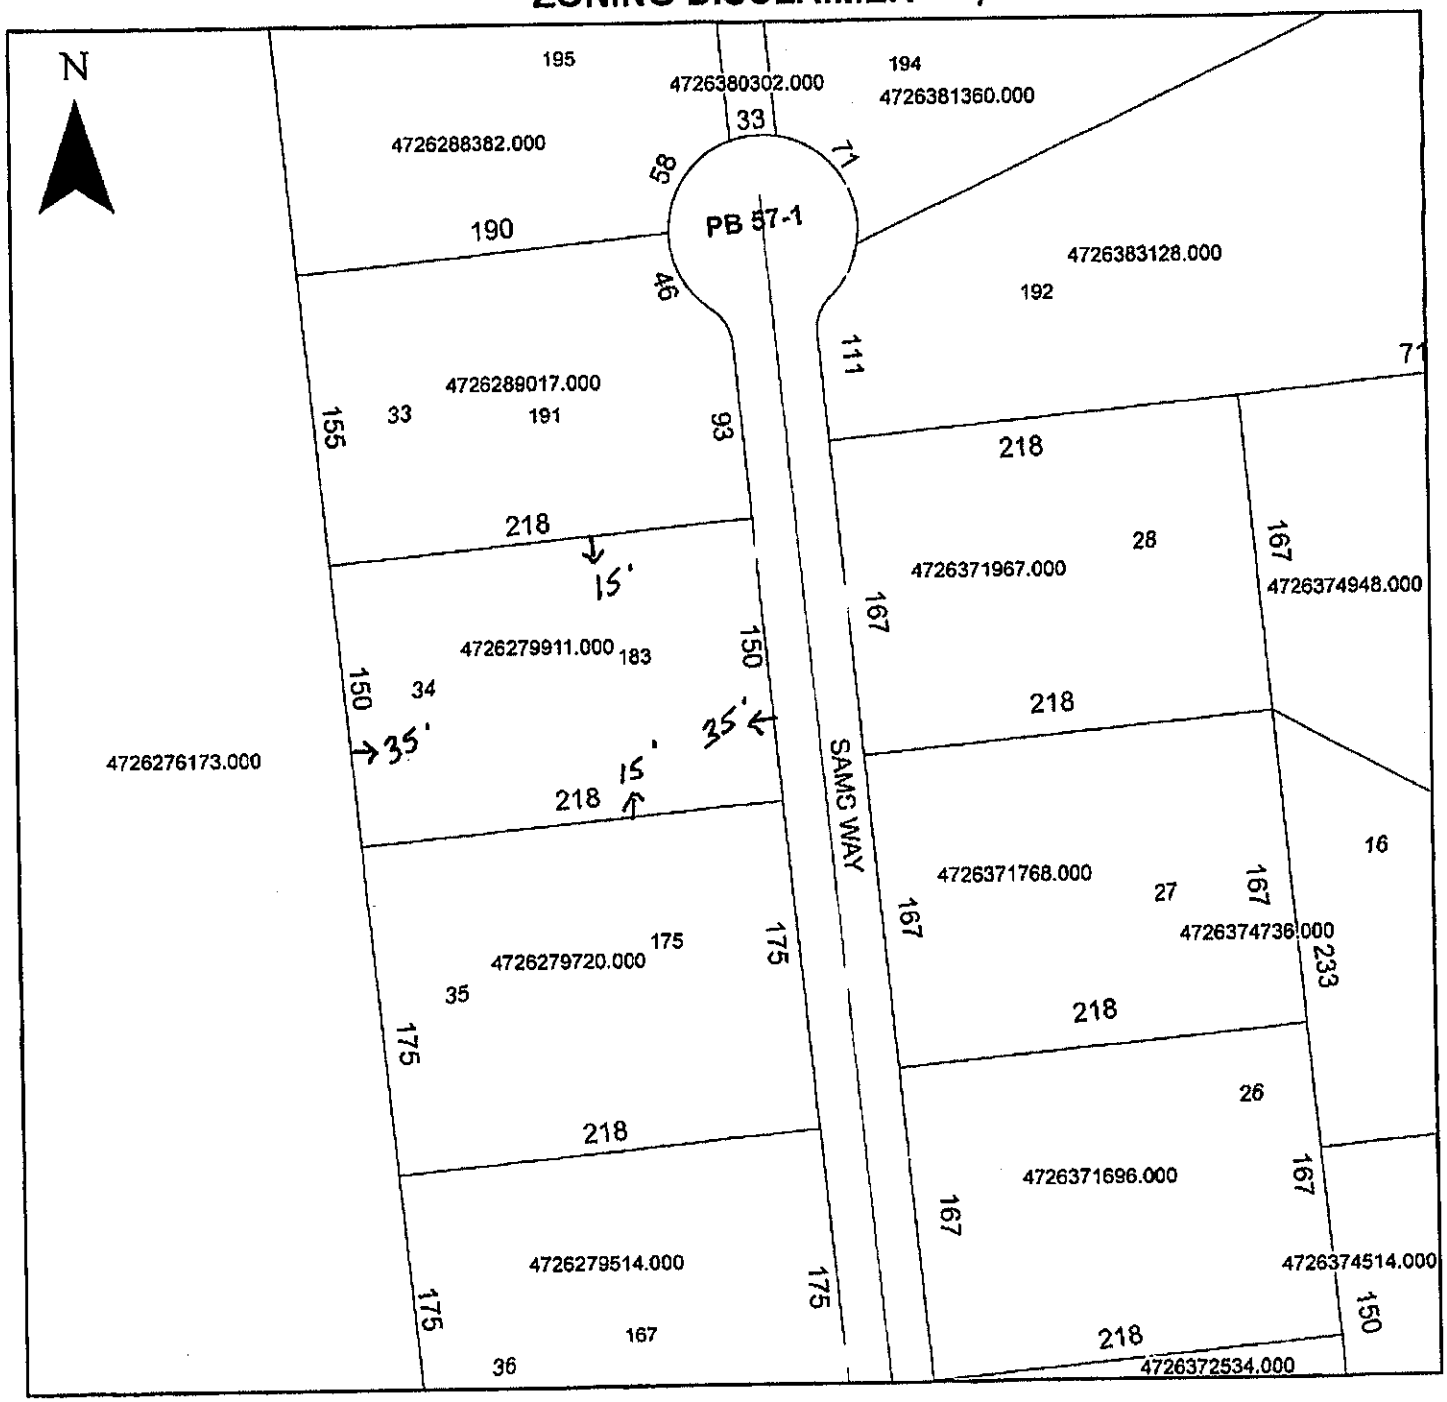

Property Address 183 Sams Way

The applicant certifies that there are no deed restrictions, contractual agreements or governmental regulations of any kind that interfere with or prohibit the use of the property or the use for which this permit is requested. Applicant further acknowledges that the enforcement of deed restrictions, plat conditions, and other contractual agreements will not be undertaken by Iredell County and is the sole responsibility of the affected parties.

Applicant

03/11/21
Date