IREDELL COUNTY HEALTH DEPARTMENT

STATESVILLE 704-878-5305 | MOORESVILLE 704-664-5281

IMPROVEMENT PERMIT / AUTHORIZATION TO CONSTRUCT / OPERATION PERMIT / EXISTING SYSTEM INSPECTION

PERMIT # 15965S PIN # ~~4702 37 7603~~ 4726-37-7603 DATE 2-1-10

OWNER or APPLICANT Gary - Jene Hawk PHONE: Business Home: 704-871-1536

OWNER or APPLICANT ADDRESS 359 Millaway RD Statesville NC 28625

LOCATION / DIRECTIONS Wilkesboro Hwy, left Millaway, left Shat Dog, Right Morgan on right

SUBDIVISION Beagle Run BLOCK / SECTION LOT # 12 LOT AREA .75 DESIGN FLOW 360 L.T.A.R. .25

Septic Tank 1000 Gallons: STB 928 Date 2-25-08

Pump Tank Gallons: P T Date

Pump Make Model Serial #

Nitrification Field No Fields No Lines 3 Linear Feet 360

Trench Width 36" Max. Trench Bottom Depth 36" Gravel Depth NA

☑ New System ☐ Repair ☐ Expansion System Type I II (III) IV V VI

System Description: 25% Graded

Repair System Description: 25% Graded

Maintenance Agreement Required ☐ YES ☑ NO

☑ GRAVITY ☐ PRESSURE

☑ Residence No. Bedrooms 3

☐ Business No. Persons

☐ Other No. Employees

☐ Slab ☑ Crawl Space

☐ Basement w/plumbing ☐ Basement w/o plumbing

Water Supply: ☐ Private ☑ Public ☐ Community


Comments / Conditions

(1"=50')

Comments / Conditions

*Install on Contour
*Maintain all setbacks

INITIAL SITE SKETCH

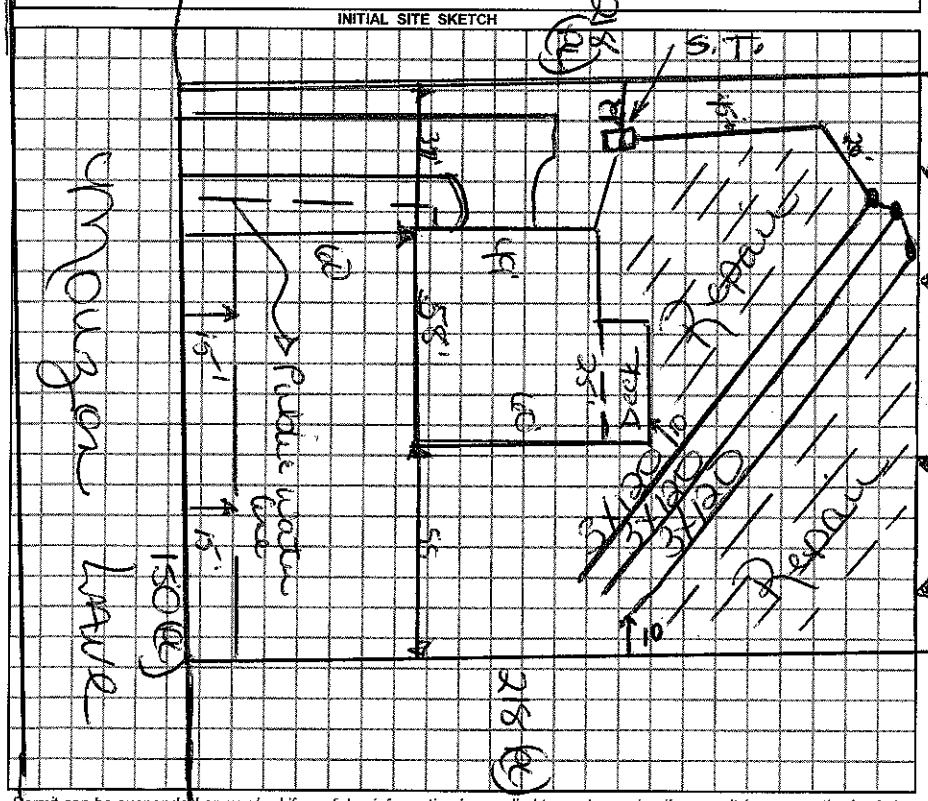

AS BUILT SKETCH

Insure tank and supply line placement are as shown for future repair.

Permit can be suspended or revoked if any false information is supplied toward securing the permit / any unauthorized changes are made to the site / any unauthorized changes are made in the installation of the system.

☐ IMPROVEMENT PERMIT w / plat valid without expiration. ☑ IMPROVEMENT PERMIT w / site plan valid for 60 mos. ☑ AUTHORIZATION TO CONSTRUCT valid for period equal to IMPROVEMENT PERMIT-not to exceed 60 mo.

Owner / Applicant Signature: Date 3-9-10

Improvement Permit by: Date 2-1-10

Authorization to Construct by: Date 2-1-10

Installed by: Madison Grading

Operation Permit by: Date: 4-16-10

Existing System Inspected by: Date:

YOU SHOULD CONTACT A LOCATOR SERVICE PRIOR TO ANY EXCAVATION.

WHITE COPY Environmental Health YELLOW COPY (Final) Owner / Applicant PINK COPY (Initial) Owner / Applicant