IREDELL COUNTY HEALTH DEPARTMENT

CI

STATESVILLE 704-878-5305 CI MOORESVILLE 704-664-5281

IMPROVEMENT PERMIT / AUTHORIZATION TO CONSTRUCT / OPERATION PERMIT / EXISTING SYSTEM INSPECTION

PERMIT# 110473 PIN# 4726-40-6445 DATE 1/9/02

OWNER OR CONTRACTOR Lou Ann Earnhardt PHONE: Business (704) 876-8702 Home —

ADDRESS 135 Big Oak Lane Statesville NC 28625

LOCATION Hwy 115 N. (L) Scott Creek, (L) Miller Farm Rd, (R) Deercroft 2nd entrance,

SUBDIVISION Deercroft BLOCK / SECTION 4 LOT 155 LOT AREA 1.283 Ac SITE CLASS. PS DESIGN FLOW 360 L.T.A.R. .25 gpd/ft²

Septic Tank: 1000 Gallons; STB 102 Date 11-19-02
Pump Tank: Gallons; PT Date
Pump Make: Model Serial No.
Nitrification Field: No Fields 1 Square Feet 1440 Linear Feet 480
No Lines 4 Trench Width 36" Max Trench Bottom Depth 30" Gravel Depth 12"

☒ New System ☐ Repair System Type: I (II) III IV V VI
System Description: Gravity, Conventional
Repair System Description: Pump, 25% Reduction
Maintenance Agreement Required: ☐ Yes ☒ No

☒ House/Mod. Home ☐ Mobile Home ☐ Business ☐ Other
No. Bedrooms 3 No. Bathrooms 3 No. Employees


☐ Slab ☒ Crawl Space ☐ Basement w/plumbing ☐ Basement wo/plumbing

Water Supply: ☐ Individual ☒ Public ☐ Community


Comments:/Conditions: (1) Install subsurface drain 42" deep to daylight (2) maintain proper setbacks

Comments:/Conditions: -Tuff Tite filter Installed -S.T. marker Installed

INITIAL SITE SKETCH

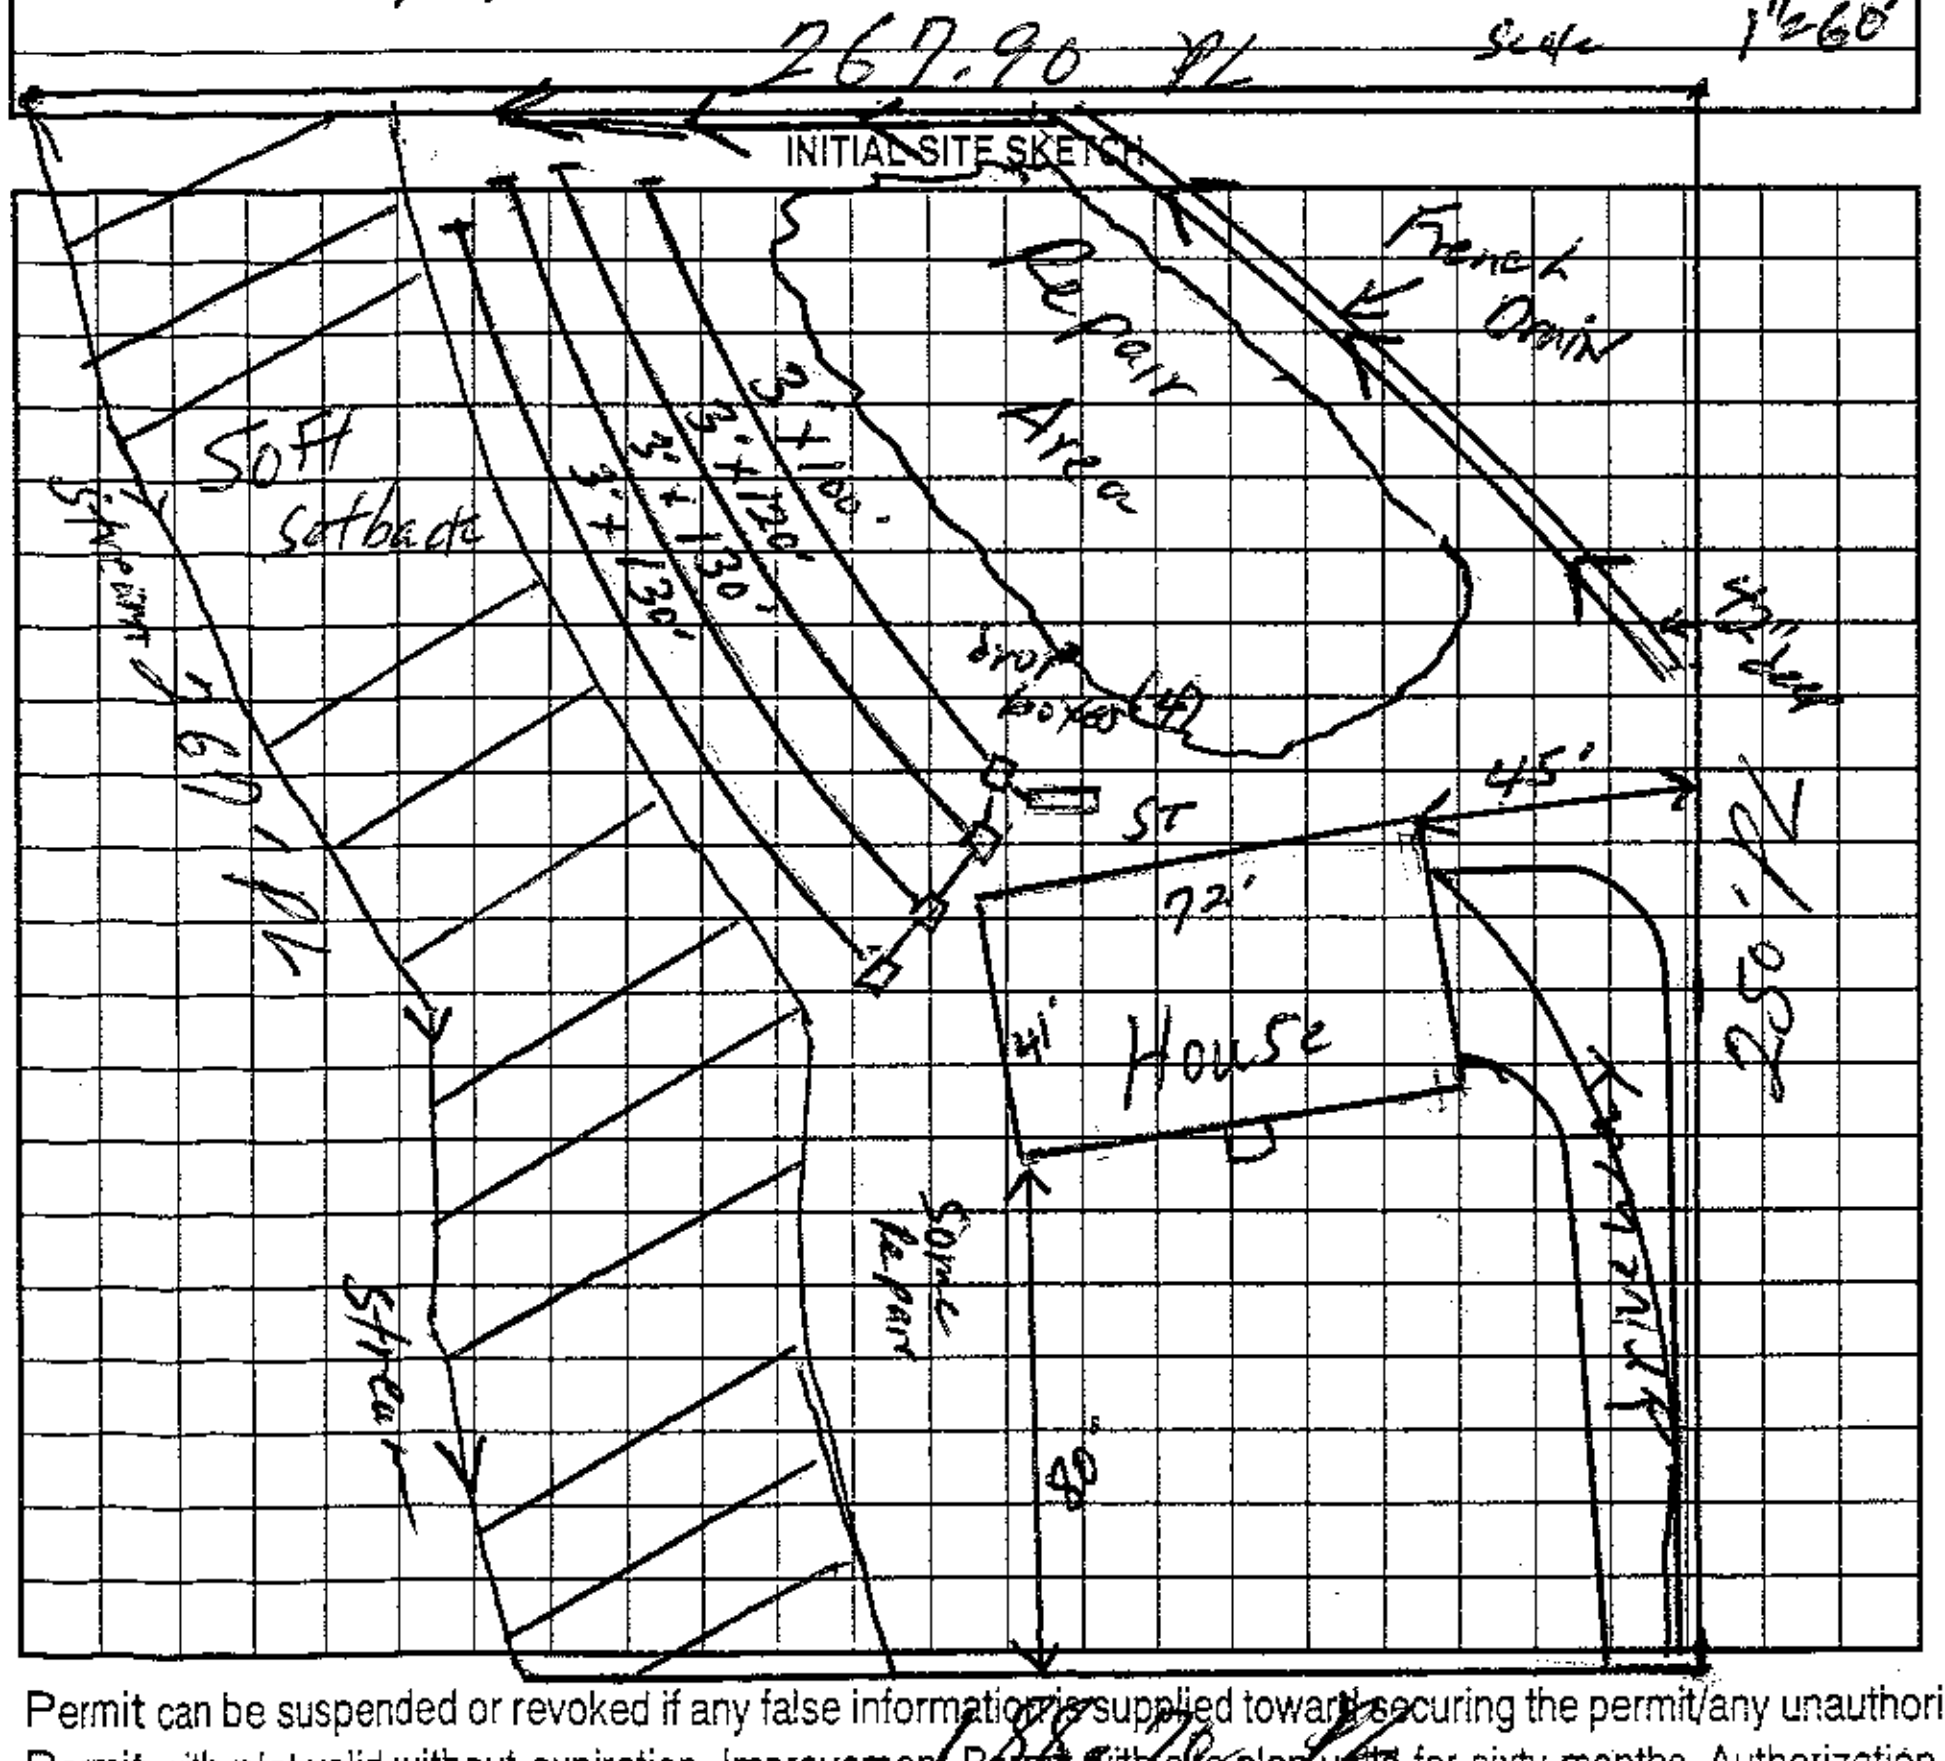

AS BUILT SKETCH

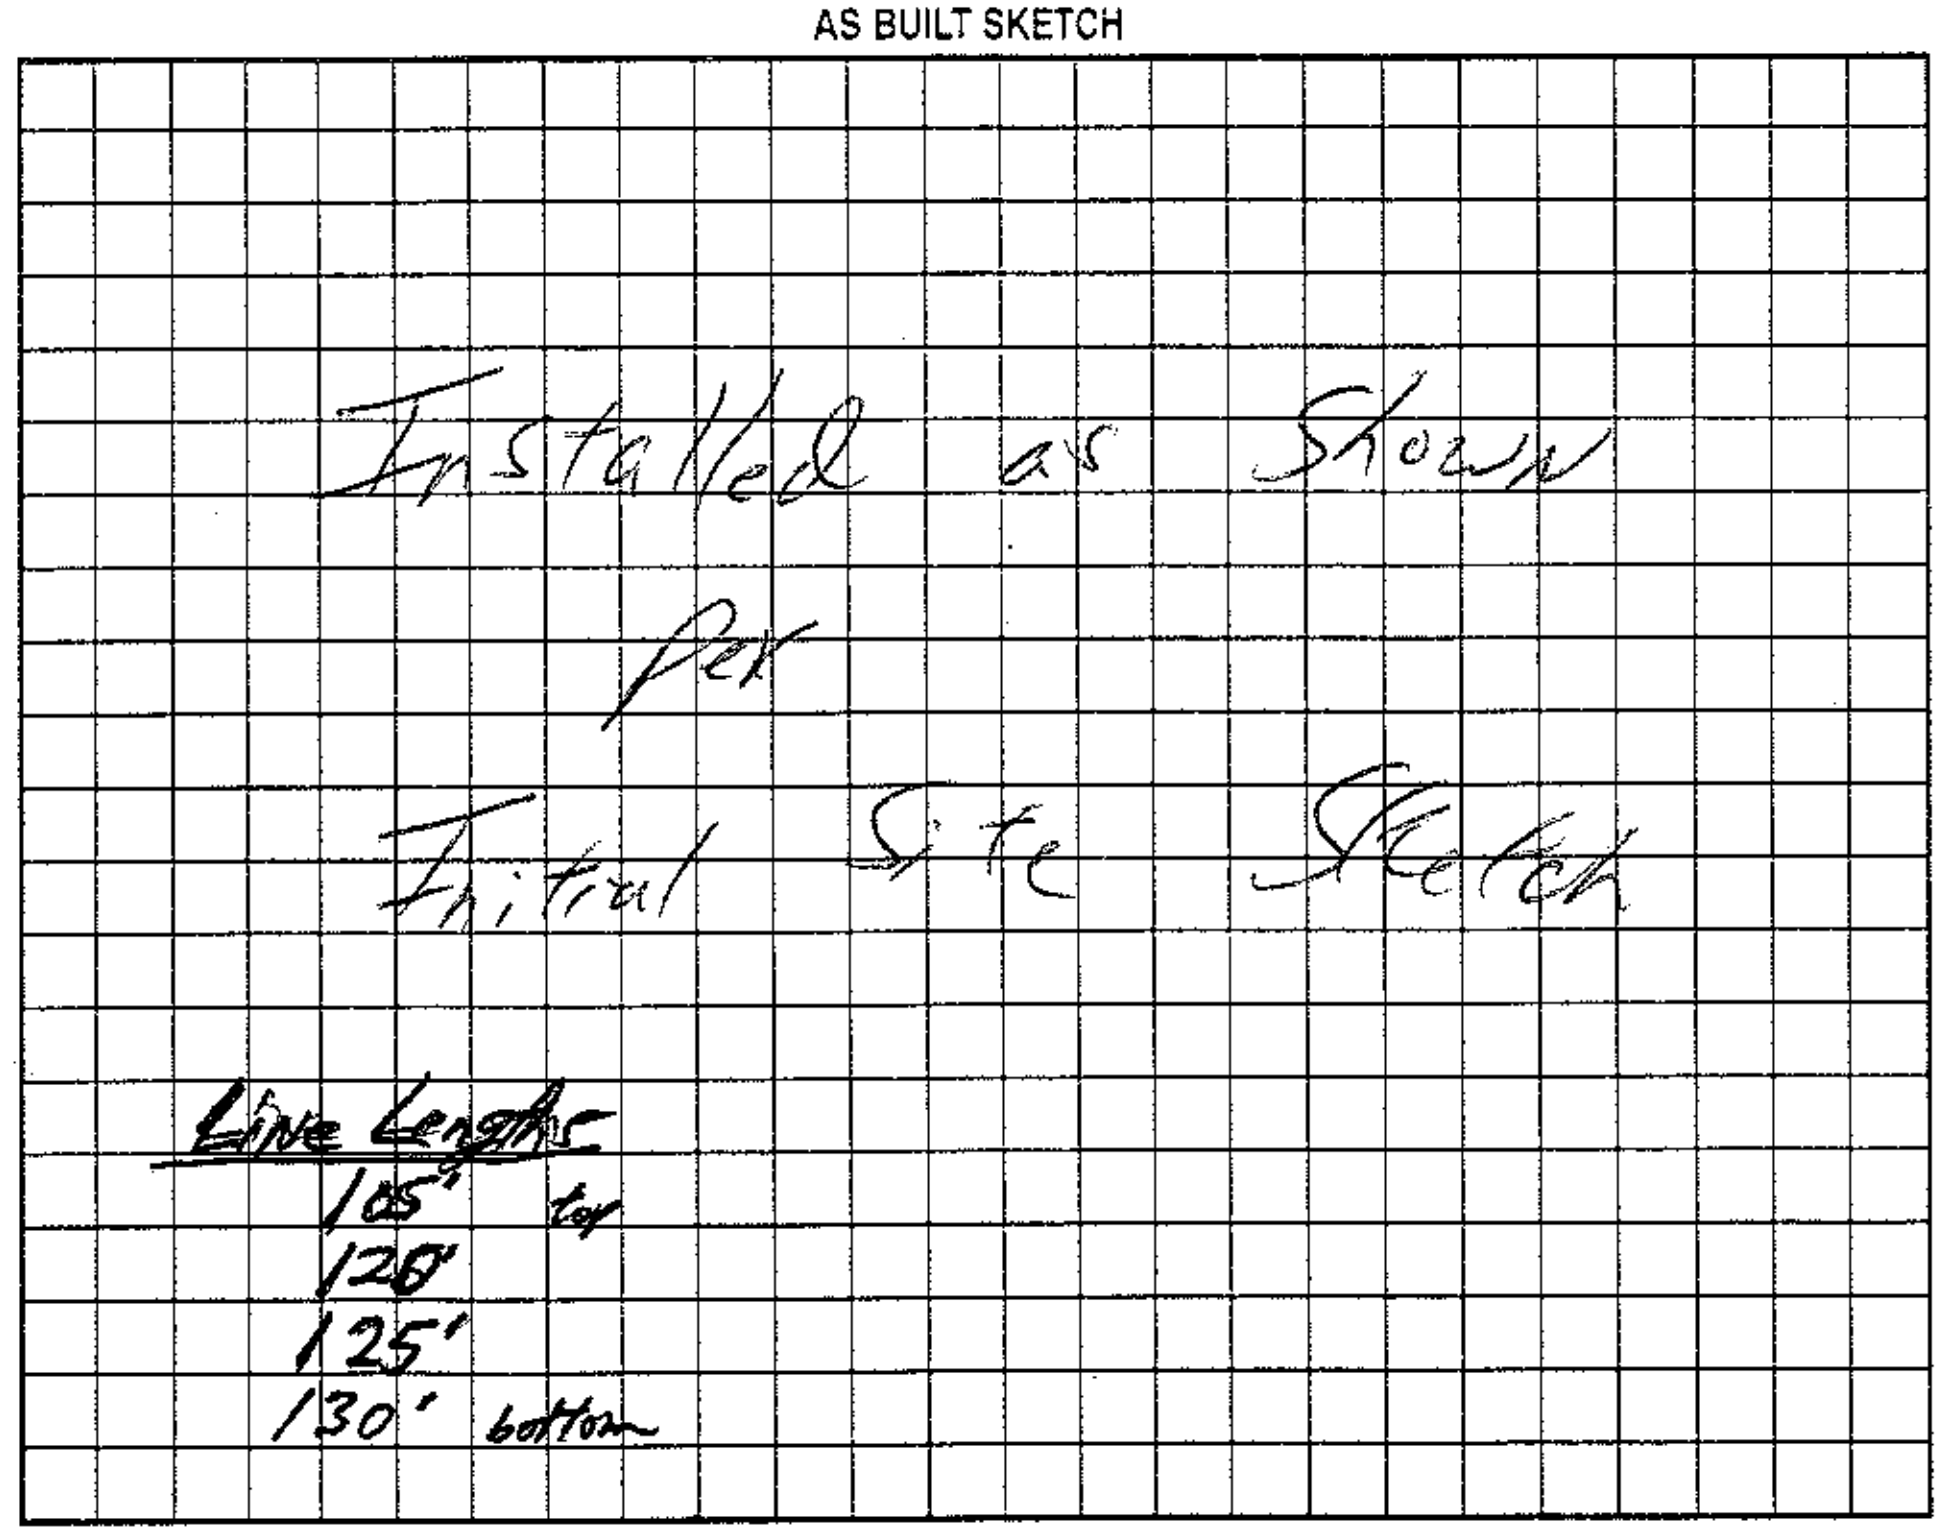

Permit can be suspended or revoked if any false information is supplied toward securing the permit/any unauthorized changes are made to the site/any unauthorized changes are made in the installation of the system. Improvement Permit with plat valid without expiration. Improvement Permit with site plan valid for sixty months. Authorization to Construct is valid for a period equal to that of Improvement Permit – not to exceed sixty months.

Signed: Lou Ann Earnhardt date 1/13/03 Installed by: David Yountz

Improvement Permit by: William O. Johnson date 1/9/03 Operation Permit by: William O. Johnson date 6/10/03

Authorization to Construct by: William O. Johnson date 1/9/03 Existing System Inspection by: date

HEALTH DEPT. COPY: WHITE OWNER COPY (FINAL): YELLOW OWNER COPY (INITIAL): PINK