1130 **IREDELL COUNTY HEALTH DEPARTMENT** @ STATESVILLE 704-878-5305 @ MOORESVILLE 704-664-5281

IMPROVEMENT PERMIT / AUTHORIZATION TO CONSTRUCT / OPERATION PERMIT / EXISTING SYSTEM INSPECTION

PERMIT # 156986 PIN # 4726-48-6687 DATE 7-1-09

OWNER or APPLICANT John C Allen PHONE: Business Home: 704-682-8775

OWNER or APPLICANT ADDRESS 115 Ridgegate Ln

LOCATION / DIRECTIONS 115 N, (L) on Scotts Creek Rd, (L) on Miller Farm Rd, (R) on Antler Ridge (L) on Red Buck Ln (R) on Ridgegate at end

SUBDIVISION Deer Croft BLOCK / SECTION 4 LOT # 162 LOT AREA .839 DESIGN FLOW 360 L.T.A.R. .25

Septic Tank 1000 Gallons: STB 794 Date 4-3-10

Pump Tank Gallons: P T Date

Pump Make Model Serial #

Nitrification Field No Fields 1 No Lines 5 Linear Feet 360

Trench Width 36" Max. Trench Bottom Depth 36 Gravel Depth n/a

☒ New System ☐ Repair ☐ Expansion System Type I (II) III IV V VI

System Description: 25% Reduction Gravity

Repair System Description: 25% Reduction Gravity

Maintenance Agreement Required ☐ YES ☒ NO

☒ GRAVITY ☐ PRESSURE


☒ Residence No. Bedrooms 3 ☐ Business No. Persons ☐ Other No. Employees ☐ Slab ☒ Crawl Space ☐ Basement w/plumbing ☐ Basement w/o plumbing

Water Supply ☐ Private ☒ Public ☐ Community


Comments / Conditions

Comments / Conditions

INITIAL SITE SKETCH

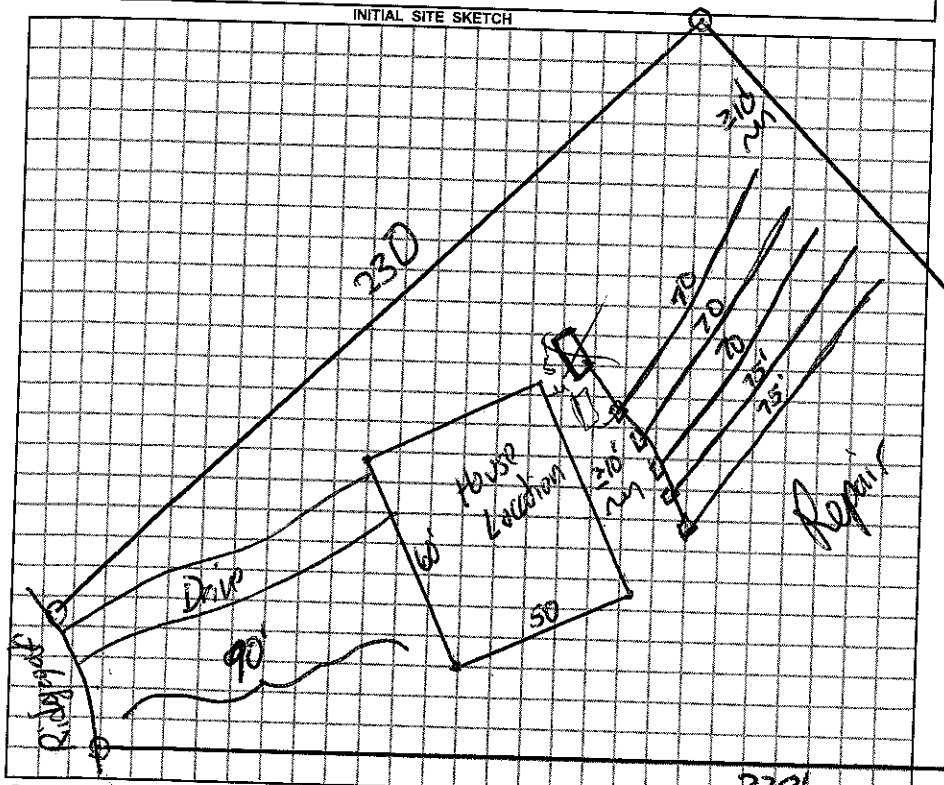

AS BUILT SKETCH

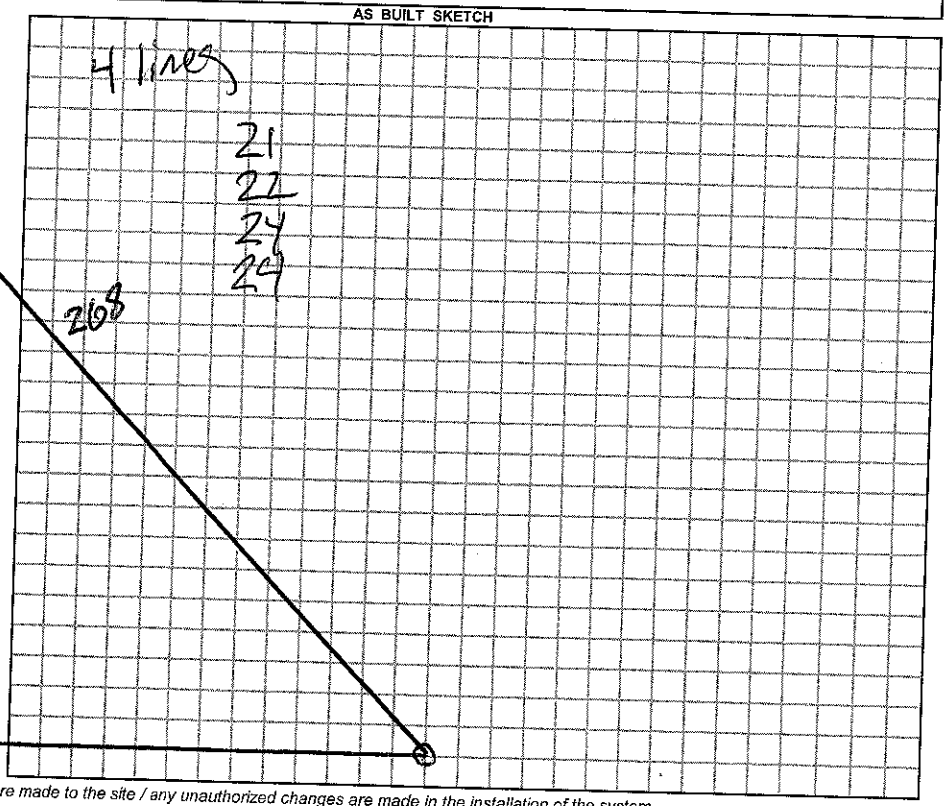

Permit can be suspended or revoked if any false information is supplied toward securing the permit / any unauthorized changes are made to the site / any unauthorized changes are made in the installation of the system.

☐ *IMPROVEMENT PERMIT w / plat valid without expiration.* ☒ *IMPROVEMENT PERMIT w / site plan valid for 60 mos.* ☒ *AUTHORIZATION TO CONSTRUCT valid for period equal to IMPROVEMENT PERMIT-not to exceed 60 mo.*

Owner / Applicant Signature John Allen Date 7-6-09

Improvement Permit by: James Date 7-1-09

Authorization to Construct by: James Date 7-1-09

YOU SHOULD CONTACT A LOCATOR SERVICE PRIOR TO ANY EXCAVATION.

Installed by: James Hubler

Operation Permit by: James Date: 8-4-10

Existing System Inspected by: Date:

WHITE COPY Environmental Health YELLOW COPY (Final) Owner / Applicant PINK COPY (Initial) Owner / Applicant