IREDELL COUNTY HEALTH DEPARTMENT

STATESVILLE 704-878-5305 MOORESVILLE 704-664-5281

IMPROVEMENT PERMIT / AUTHORIZATION TO CONSTRUCT / OPERATION PERMIT / EXISTING SYSTEM INSPECTION

PERMIT# 94317 PIN# 4726 40 8414 DATE 02/15/01

OWNER OR CONTRACTOR PETREE STYRONE BLKS PHONE: Business 873-5367 Home

ADDRESS 2639 FINES CREEK DRIVE, STATESVILLE NC 28625

LOCATION 115 N, ② SCOTTS CREEK, L MILLER FARM, R ANTLER, ① REDBUCK, ⑫ Morrison on RT

SUBDIVISION DEERCROFT BLOCK / SECTION 4 LOT 156 LOT AREA .63 SITE CLASS PS DESIGN FLOW 360 L.T.A.R. .25

Septic Tank: 1000 Gallons; STB 1012 Date 3-19-01
Pump Tank: Gallons; PT Date
Pump Make: Model Serial No.
Nitrification Field: No Fields 1 Square Feet EQ to 144D Linear Feet 240
No Lines 6 Trench Width 24" Max Trench Bottom Depth 36" Gravel Depth N/A

☒ New System ☐ Repair System Type: I, II, (III), IV, V, VI
System Description: GRAV 50% REDUCTION
Repair System Description: PUMP/Pressure low 25% RED
Maintenance Agreement Required: ☐ Yes ☒ No


☒ House/Mod. Home No. Bedrooms 3
☐ Mobile Home No. Bathrooms 2
☐ Business No. Employees
☐ Other
☐ Slab ☒ Crawl Space ☐ Basement w/plumbing ☐ Basement wo/plumbing

Water Supply: ☐ Individual ☒ Public ☐ Community


Comments/Conditions: ① USE FLOWDIVIDER TEE & 2 DISTRIBUTION BOXES WITH SPEED LEVELERS ② KEEP SYSTEM 10' off Property Lines & 5' off house ③ KEEP SYSTEM 15' ABOVE EMBANKMENT ④ KEEP H2O LINE 10' AWAY FROM SYSTEM

Comments/Conditions: SYSTEM INSTALLED WITH MARKER & POLYLOK FILTER
6-12-01 - Checked 1st 3 lines & Dist BOX & FLOW DIV. TEE

INITIAL SITE SKETCH

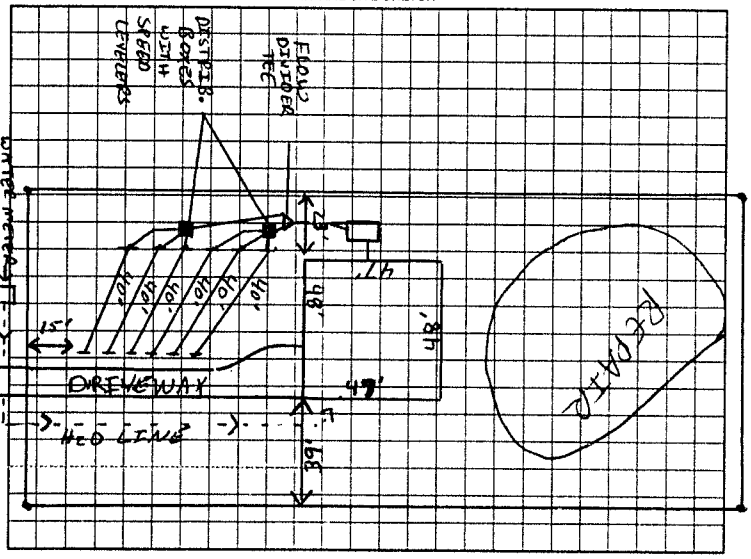

AS BUILT SKETCH

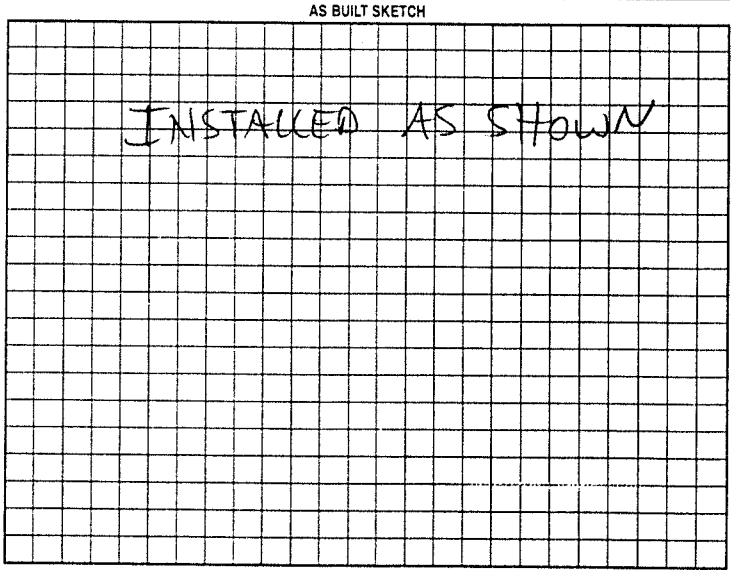

Permit can be suspended or revoked if any false information is supplied toward securing the permit/any unauthorized changes are made to the site/any unauthorized changes are made in the installation of the system. Improvement Permit with plat valid without expiration. Improvement Permit with site plan valid for sixty months. Authorization to Construct is valid for a period equal to that of Improvement Permit -- not to exceed sixty months.

Signed: date 2/15/01 Installed by: STEVE JORDAN

Improvement Permit by: date 02/15/01 Operation Permit by: date 6-13-01

Authorization to Construct by: date 02/15/01 Existing System Inspection by: date

HEALTH DEPT. COPY WHITE OWNER COPY (FINAL) YELLOW OWNER COPY (INITIAL) PINK