IREDELL COUNTY HEALTH DEPARTMENT

STATESVILLE 704-878-5305 MOORESVILLE 704-664-5281

IMPROVEMENT PERMIT / AUTHORIZATION TO CONSTRUCT / OPERATION PERMIT / EXISTING SYSTEM INSPECTION

PERMIT# 095210 PIN# 4726 3/6491

OWNER OR CONTRACTOR A. J. Building Co. PHONE: Business (704) 871-0940 Home — DATE 4/10/01

ADDRESS 149 Hunter Ridge Lane Statesville N.C. 28625

LOCATION Scotty Creek, L Miller Farm, R Antler, L Redbuck, R Ridgegate on left

SUBDIVISION Ikercraft ~~BLOCK~~ / SECTION 4 LOT 161 LOT AREA .61 Acres SITE CLASS P5 DESIGN FLOW 360 L.T.A.R. .30 gal/ft²

Septic Tank: 4000 Gallons: STB 1012 Date 2-12-01

Pump Tank: — Gallons: PT — Date —

Pump Make: — Model — Serial No. —

Nitrification Field: No Fields 1 Square Feet 1200 Linear Feet 400

No Lines 4@100' Trench Width 36" Max Trench Bottom Depth 32" Gravel Depth 12"

X New System ☐ Repair System Type: I (II) III, IV, V, VI

System Description: Gravity, Conventional

Repair System Description: Pump @ 25% Reduction

Maintenance Agreement Required: ☐ Yes X No

☐ Slab X Crawl Space ☐ Basement w/plumbing ☐ Basement wo/plumbing

X House/Mod. Home No. Bedrooms 3

☐ Mobile Home No. Bathrooms 2

☐ Business No. Employees —

☐ Other —

Water Supply: ☐ Individual X Public ☐ Community


Comments:/Conditions: ① Install lines on Contour ② Keep Lines 10' From property line

Scale 1" = 50'


Comments:/Conditions:

- Polylok filter Installed
- Septic Tank marker Installed

INITIAL SITE SKETCH

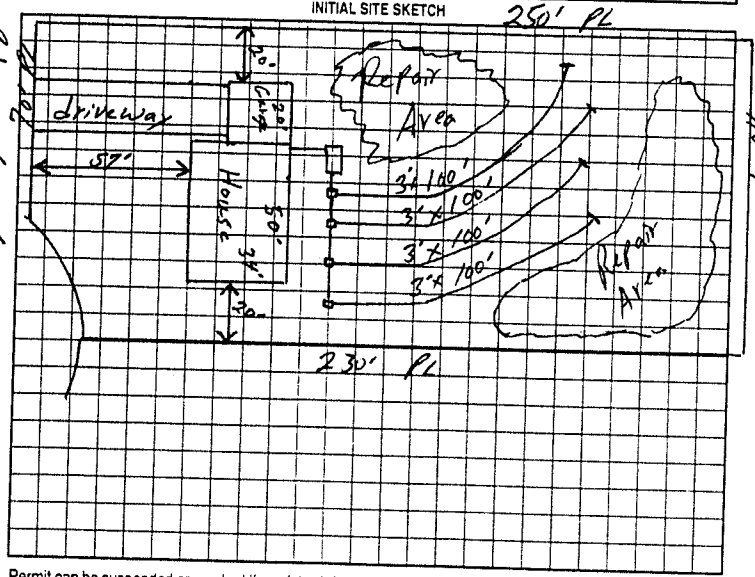

AS BUILT SKETCH

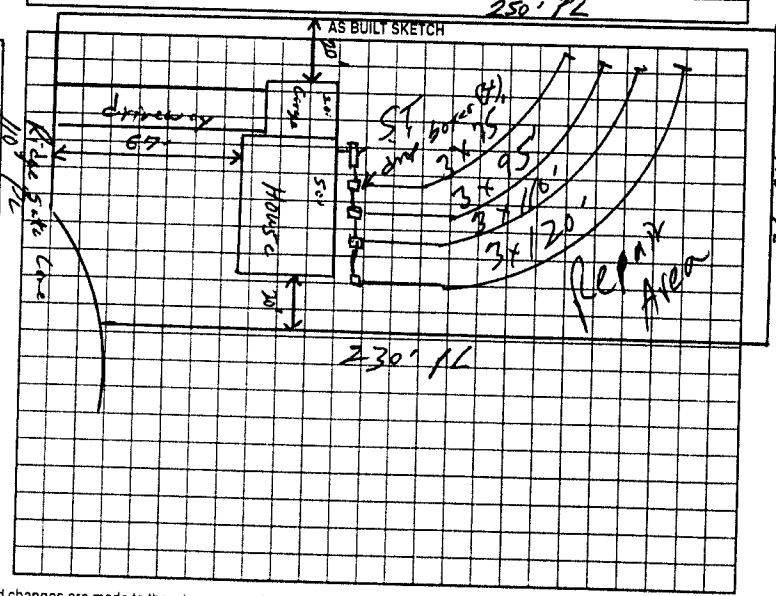

Ridgegate Lane

Permit can be suspended or revoked if any false information is supplied toward securing the permit/any unauthorized changes are made to the site; any unauthorized changes are made in the installation of the system. Improvement Permit with plat valid without expiration, Improvement Permit with site plan valid for sixty months. Authorization to Construct is valid for a period equal to that of Improvement Permit – not to exceed sixty months.

Signed: Jeffrey E. Whitcher date 4-16-01 Installed by: Steve Jordan

Improvement Permit by: William O. Johnson RSI date 4/10/01 Operation Permit by: William O. Johnson date 6/14/01

Authorization to Construct by: William O. Johnson RSI date 4/10/01 Existing System Inspection by: — date —

HEALTH DEPT. COPY WHITE OWNER COPY (FINAL) YELLOW OWNER COPY (INITIAL) PINK