IREDELL COUNTY HEALTH DEPARTMENT

Parcel # 4726 40 9009

838-0076

STATESVILLE 704-878-5305 MOORESVILLE 704-664-5281

IMPROVEMENT PERMIT / AUTHORIZATION TO CONSTRUCT / OPERATION PERMIT / EXISTING SYSTEM INSPECTION

PERMIT# 96013 PIN# 4726 31 6491 4726-40-9009 DATE 11-12-99

OWNER OR CONTRACTOR James Hitt PHONE: Business Home 878-6972

ADDRESS 146 morrison Creek Rd

LOCATION Scotts Creek To miller Farm To deercroft to morrison creek

SUBDIVISION Deercroft BLOCK / SECTION 4 LOT 153 LOT AREA 1.17 acres SITE CLASS. PS DESIGN FLOW 360 L.T.A.R. .2 gal/sq' /day

Septic Tank: 1000 Gallons; STB 1012 Date 9-12-01

Pump Tank: 1000 Gallons; PT 17 Date 2-15-01

Pump Make: Gould's Model PWE0712H Serial No. K017 4469

Nitrification Field: No Fields 1 Square Feet 600 Linear Feet 300

No Lines Trench Width 24 Max Trench Bottom Depth 36" Gravel Depth N/A

☑ New System ☐ Repair System Type: I, II, III, IV, V, VI

System Description: Low Pressure Test Panel

Repair System Description:

Maintenance Agreement Required: ☑ Yes ☐

☑ House/Mod. Home No. Bedrooms 3

☐ Mobile Home No. Bathrooms 2

☐ Business No. Employees

☐ Other

☐ Slab ☑ Crawl Space ☐ Basement w/plumbing ☐ Basement wo/plumbing

Water Supply: ☐ Individual ☑ Public ☐ Community


Comments:/Conditions:

See Attached Sheets for Drawings on P.T. & Pressure line set up which are part of This Permit


Comments:/Conditions:

A certified Subsurface System operator must be on Contract before an operations Permit can be issued

INITIAL SITE SKETCH

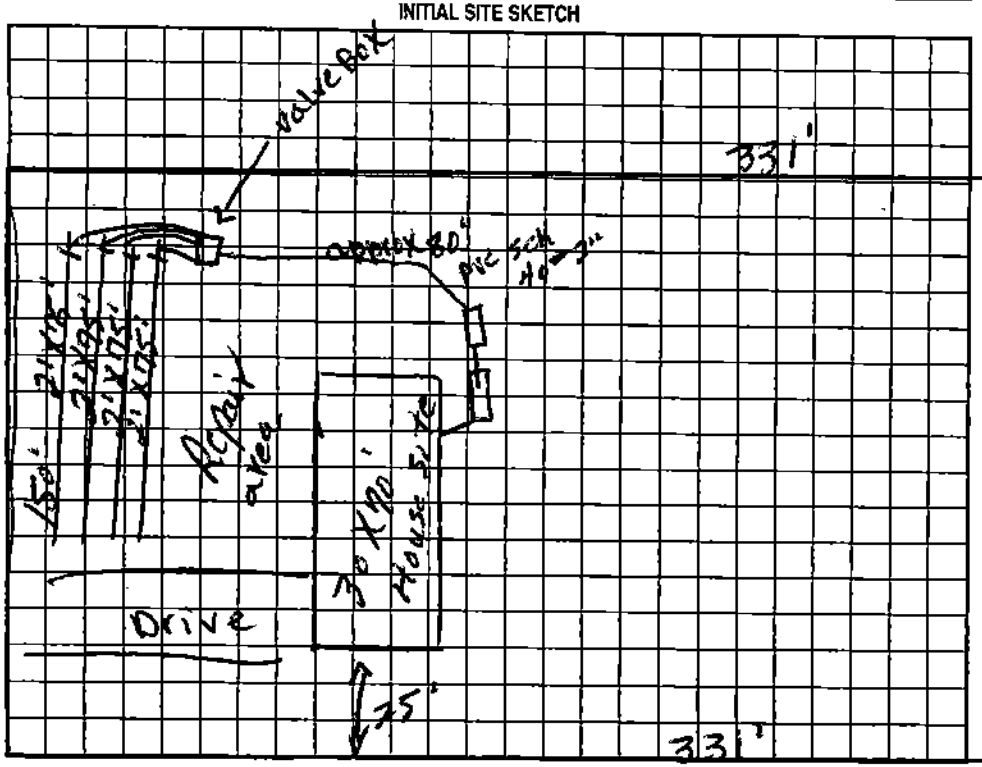

AS BUILT SKETCH

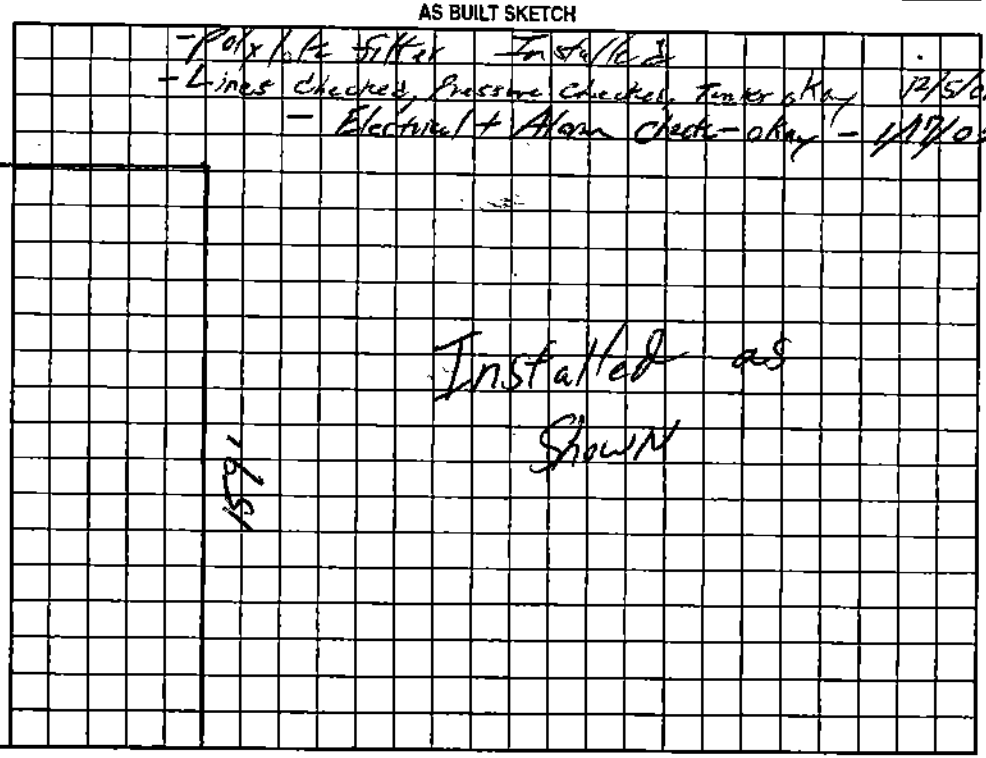

Permit can be suspended or revoked if any false information is supplied toward securing the permit/any unauthorized changes are made to the site/any unauthorized changes are made in the installation of the system. Improvement Permit with plat valid without expiration. Improvement Permit with site plan valid for sixty months. Authorization to Construct is valid for a period equal to that of Improvement Permit – not to exceed sixty months.

Signed: Shirley P. Hitt date Installed by: Mitchell Grading

Improvement Permit by: P.C. Moore date 11-12-99 Operation Permit by: William O. Johnson date 1/24/02

Authorization to Construct by: P.C. Moore date 11-12-99 Existing System Inspection by: date

HEALTH DEPT. COPY: WHITE OWNER COPY (FINAL): YELLOW OWNER COPY (INITIAL): PINK