IREDELL COUNTY HEALTH DEPARTMENT

STATESVILLE 704-878-5305 MOORESVILLE 704-664-5281

IMPROVEMENT PERMIT / AUTHORIZATION TO CONSTRUCT / OPERATION PERMIT / EXISTING SYSTEM INSPECTION

PERMIT# 083626 PIN# 4726 31 6491 (PART OF) DATE 8-30-99

OWNER OR CONTRACTOR JOHNS WELDING PHONE: Business 873-7885 Home

ADDRESS 1516 MOCKSVILLE HWY, STATESVILLE NC 28625

LOCATION NC 115 N, TL SCOTTS CREEK TL MILLER FARM TR ANTISE, TL REDBUCK, TR MORRISON CREEK, 2ND LOT ON RIGHT

SUBDIVISION DEERCROFT BLOCK / SECTION IV LOT 157 LOT AREA 0.631 ACRES SITE CLASS PS DESIGN FLOW 360 L.T.A.R. 0.25 GPD/FT²

Septic Tank: 1000 Gallons; STB 1012 Date 1-25-2000 ☑ New System ☐ Repair System Type: I II III IV V VI

Pump Tank: ____ Gallons; PT ____ Date ____ System Description: 25% REDUCTION GRAVITY

Pump Make: ____ Model ____ Serial No. ____ Repair System Description: 50% REDUCTION PUMP

Nitrification Field: No Fields 1 Square Feet 60 TO 1440 Linear Feet 360 Maintenance Agreement Required: ☐ Yes ☑ No

No Lines SIX Trench Width 36" Max Trench Bottom Depth 36" ~~STAKE~~ Depth SAND 6" ☐ Slab ☑ Crawl Space ☐ Basement w/plumbing ☐ Basement wo/plumbing

☑ House/Mod. Home No. Bedrooms 3

☐ Mobile Home No. Bathrooms 2

☐ Business No. Employees ____


☐ Other ____

Water Supply: ☐ Individual ☑ Public ☐ Community


Comments/Conditions: INSTALL 25% REDUCTION SYSTEM USING SIXTY (60) CHAMBERS OR ~~FORTY~~ FORTY-EIGHT (48) HDS, SECTIONS ON CONTOUR A

Comments Conditions SEPTIC TANK W/ RISERS INSTALLED USING "POLYLOK" FILTER

SCALE: 1" = 40' INITIAL SITE SKETCH

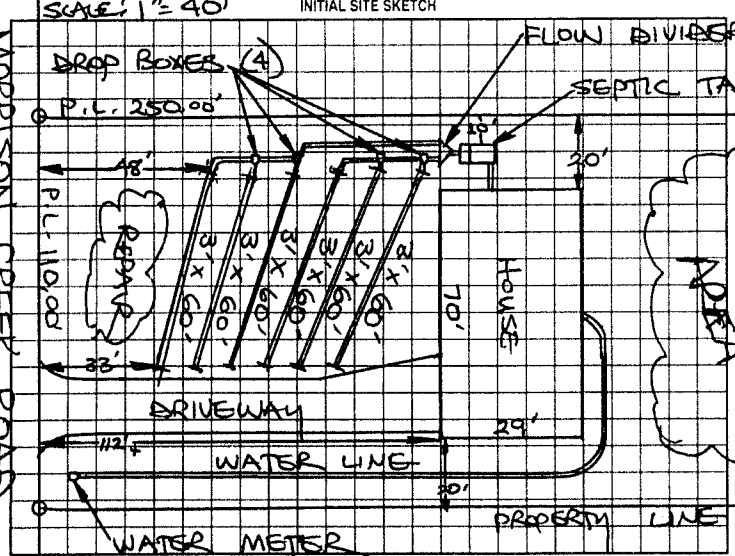

AS BUILT SKETCH

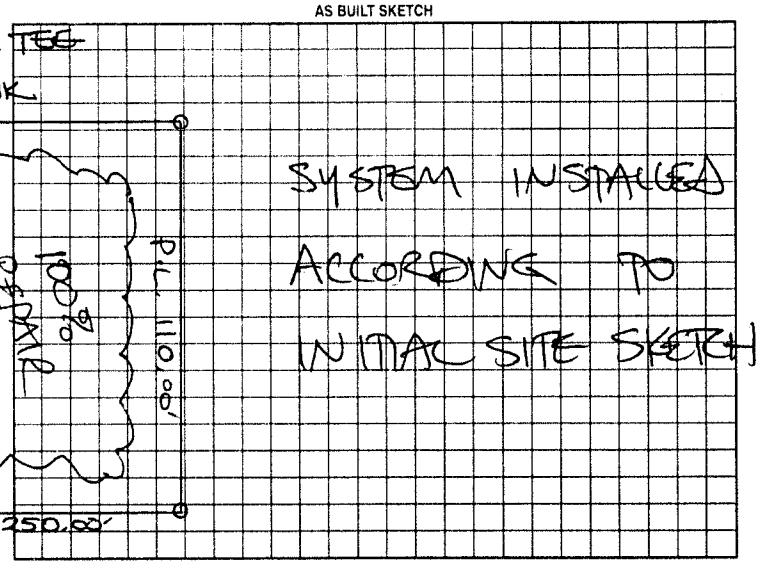

Permit can be suspended or revoked if any false information is supplied toward securing the permit/any unauthorized changes are made to the site/any unauthorized changes are made in the installation of the system. Improvement Permit with plat valid without expiration. Improvement Permit with site plan valid for sixty months. Authorization to Construct is valid for a period equal to that of Improvement Permit -- not to exceed sixty months.

Signed: ____ date ____ Installed by: STEVE JORDAN

Improvement Permit by: STEVE HEDRICK date 8-30-99 Operation Permit by: STEVE HEDRICK date 4-24-00

Authorization to Construct by: STEVE HEDRICK date 8-30-99 Existing System Inspection by: ____ date ____

HEALTH DEPT. COPY WHITE OWNER COPY (FINAL) YELLOW OWNER COPY (INITIAL) PINK