IREDELL COUNTY HEALTH DEPARTMENT

STATESVILLE 704-878-5305 MOORESVILLE 704-664-5281

IMPROVEMENT PERMIT / AUTHORIZATION TO CONSTRUCT / OPERATION PERMIT / EXISTING SYSTEM INSPECTION

PERMIT# 083301 / PIN# 4726316491 (PT) DATE 8-23-99

OWNER OR CONTRACTOR PETREE / STYRON BUILDERS PHONE: Business 873-5083 Home

ADDRESS 2639 FINES CREEK DRIVE, STATESVILLE, NC 28625

LOCATION NC 115 N TL SCOTTS CREEK RD, TL MILLER FARM RD, TR ANTLER DRIVE, LOT AT END ON LEFT

SUBDIVISION DEERCREPT BLOCK / SECTION IV LOT 171 LOT AREA 1.039 ACRES SITE CLASS PS DESIGN FLOW 360 L.T.A.R. 0.20 GPD/FT²

Septic Tank: 1000 Gallons; STB 825 Date 12-4-99

Pump Tank: Gallons; PT Date

Pump Make: Model Serial No.

Nitrification Field: No Fields 1 Square Feet 69.10 1800 Linear Feet 450+

No Lines FIVE Trench Width 36" Max Trench Bottom Depth 30"

✓ New System ☐ Repair System Type: I, II, (III), IV, V, VI

System Description: 25% REDUCTION GRAVITY

Repair System Description: 25% REDUCTION GRAV.

Maintenance Agreement Required: ☐ Yes ✓ No

~~Gravel~~ Depth SAND 6"

✓ House/Mod. Home ☐ Mobile Home ☐ Business ☐ Other

No. Bedrooms 3 No. Bathrooms 2 No. Employees


☐ Slab ✓ Crawl Space ☐ Basement w/plumbing ☐ Basement wo/plumbing

Water Supply: ☐ Individual ✓ Public ☐ Community


Comments/Conditions: ① INSTALL 25% REDUCTION SYSTEM USING SEVENTY-FIVE CHAMBERS OR FORTY-FIVE HDS SECTIONS. ② INSTALL SUBSURFACE INTERCEPT DRAINAGE DITCH BEGINNING FORTY-TWO INCHES DEEP OUT TO DAYLIGHT.

Comments/Conditions

INITIAL SITE SKETCH

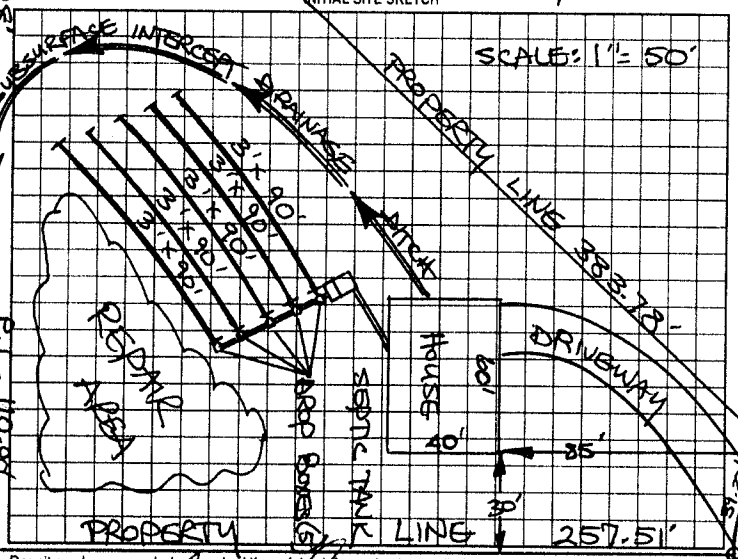

AS BUILT SKETCH

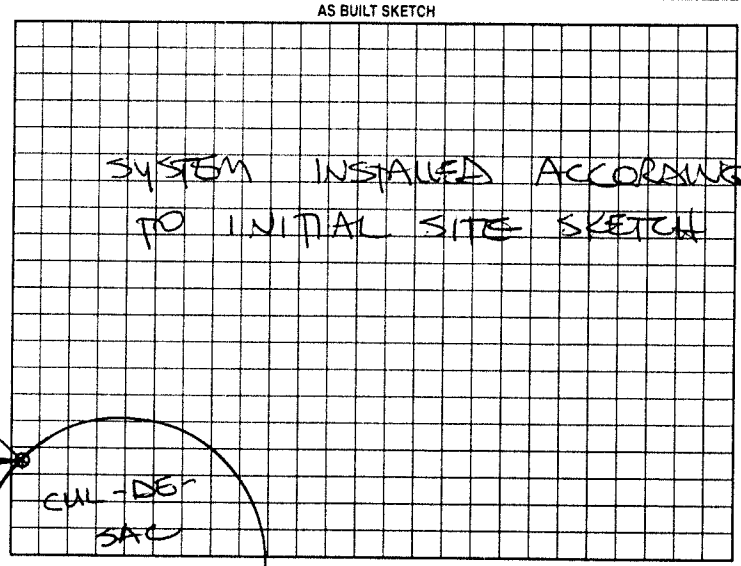

Permit can be suspended or revoked if any false information is supplied toward securing the permit/any unauthorized changes are made to the site/any unauthorized changes are made in the installation of the system. Improvement Permit with plat valid without expiration. Improvement Permit with site plan valid for sixty months. Authorization to Construct is valid for a period equal to that of Improvement Permit -- not to exceed sixty months.

Signed: _____ date 8/31/99 Installed by: C & W GRADING

Improvement Permit by: STEVE HEDRICK date 8-23-99 Operation Permit by: STEVE HEDRICK date 1-31-00

Authorization to Construct by: STEVE HEDRICK date 8-2399 Existing System Inspection by: _____ date _____

HEALTH DEPT COPY WHITE OWNER COPY (FINAL) YELLOW OWNER COPY (INITIAL) PINK

ANTLER DRIVE