IREDELL COUNTY HEALTH DEPARTMENT

STATESVILLE 704-878-5305 MOORESVILLE 704-664-5281

IMPROVEMENT PERMIT / AUTHORIZATION TO CONSTRUCT / OPERATION PERMIT / EXISTING SYSTEM INSPECTION

PERMIT# 09255 PIN# 4726 41 8836 DATE 11-1-00

OWNER OR CONTRACTOR CHRISTOPHER PARKER PHONE: Business Home 873-2914

ADDRESS 153 PINEHAVEN DRIVE STATESVILLE, NC 28677

LOCATION NC 115 N, TL SCOTTS CREEK RD, TL MILLER FARM RD, TR DOE TRAIL, AT END ON LEFT

SUBDIVISION DEERCROFT BLOCK / SECTION IV LOT 182 LOT AREA 1.269 ACRES SITE CLASS PS DESIGN FLOW 360 L.T.A.R. 0.30 GPD/FT2

Septic Tank: 1000 Gallons; STB 1012 Date 10-10-00

Pump Tank: ____ Gallons; PT ____ Date ____

Pump Make: ____ Model ____ Serial No. ____

Nitrification Field: No Fields 1 Square Feet 1200 Linear Feet 400

No Lines FOUR Trench Width 36" Max Trench Bottom Depth 36" Gravel Depth 12"

✓ New System ☐ Repair System Type: I, II, IV, V, VI

System Description: CONVENTIONAL GRAVITY

Repair System Description: 25% REDUCTION GRAVITY

Maintenance Agreement Required: ☐ Yes ✓ No

✓ House/Mod. Home No. Bedrooms 3

☐ Mobile Home No. Bathrooms 2

☐ Business No. Employees ____

☐ Other ____


☐ Slab ✓ Crawl Space ☐ Basement w/plumbing ☐ Basement wo/plumbing

Water Supply: ☐ Individual ✓ Public ☐ Community

Comments/Conditions: INSTALL SUBSURFACE INTERCEPT DRAINAGE DITCH AT LOCATION SHOWN BEGINNING 48 INCHES DEEP OUT TO DAYLIGHT

Comments/Conditions: - Poly Lok Filter Installed
- Septic Tank Risers Installed

INITIAL SITE SKETCH

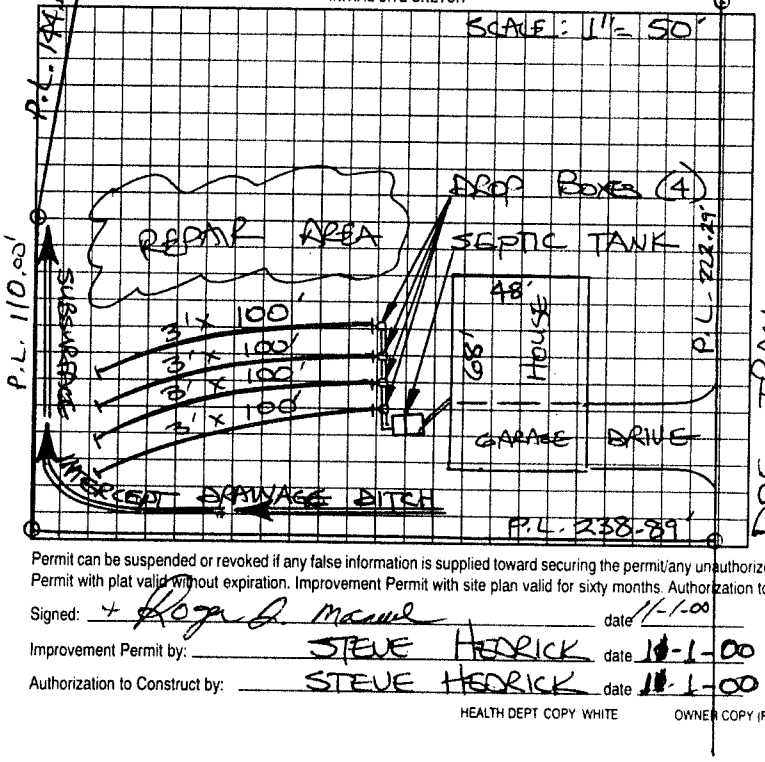

AS BUILT SKETCH

Installed as Shown per Initial Site Sketch

Permit can be suspended or revoked if any false information is supplied toward securing the permit/any unauthorized changes are made to the site/any unauthorized changes are made in the installation of the system. Improvement Permit with plat valid without expiration. Improvement Permit with site plan valid for sixty months. Authorization to Construct is valid for a period equal to that of Improvement Permit – not to exceed sixty months.

Signed: + Roger A. Maund date 11-1-00 Installed by: David Yountz

Improvement Permit by: STEVE HEDRICK date 11-1-00 Operation Permit by: William O. Johnson RII date 5/4/01

Authorization to Construct by: STEVE HEDRICK date 11-1-00 Existing System Inspection by: ____ date ____

HEALTH DEPT COPY WHITE OWNER COPY (FINAL) YELLOW OWNER COPY (INITIAL) PINK