IREDELL COUNTY HEALTH DEPARTMENT

STATESVILLE 704-878-5305 MOORESVILLE 704-664-5281

IMPROVEMENT PERMIT / AUTHORIZATION TO CONSTRUCT / OPERATION PERMIT / EXISTING SYSTEM INSPECTION

PERMIT# 84103 PIN# 4726316491 DATE 10-14-99

OWNER OR CONTRACTOR Richard Wilson Sr. PHONE: Business Home 873 9034

ADDRESS 204 Thistle Ln Statesville N.C

LOCATION Scotts Creek TL Antler TL Redbuck TR Ritzegate 2nd lot rt.

SUBDIVISION Deercroft BLOCK / SECTION 4 LOT 167 LOT AREA .7 acres SITE CLASS PS DESIGN FLOW 360 L.T.A.R. .27

Septic Tank: 1000 Gallons; STB 1012 Date 3-10-00
Pump Tank: Gallons; PT Date
Pump Make: Model Serial No.
Nitrification Field: No Fields 1 Square Feet 1350 Linear Feet 450
No Lines 4 Trench Width 36" Max Trench Bottom Depth 36" Gravel Depth 12"

☑ New System ☐ Repair System Type: I (II) III, IV, V, VI
System Description: Conv. Gravity
Repair System Description: Gravity 25% Reduct.
Maintenance Agreement Required: ☐ Yes ☑ No
☐ Slab ☑ Crawl Space ☐ Basement w/plumbing ☐ Basement wo/plumbing


☑ House/Mod. Home No. Bedrooms 3
☐ Mobile Home No. Bathrooms 2
☐ Business No. Employees
☐ Other

Water Supply: ☐ Individual ☑ Public ☐ Community


Comments/Conditions:

Comments/Conditions SEPTIC TANK W/ RISERS INSTALLED USING "POLYLOK" FILTER

INITIAL SITE SKETCH

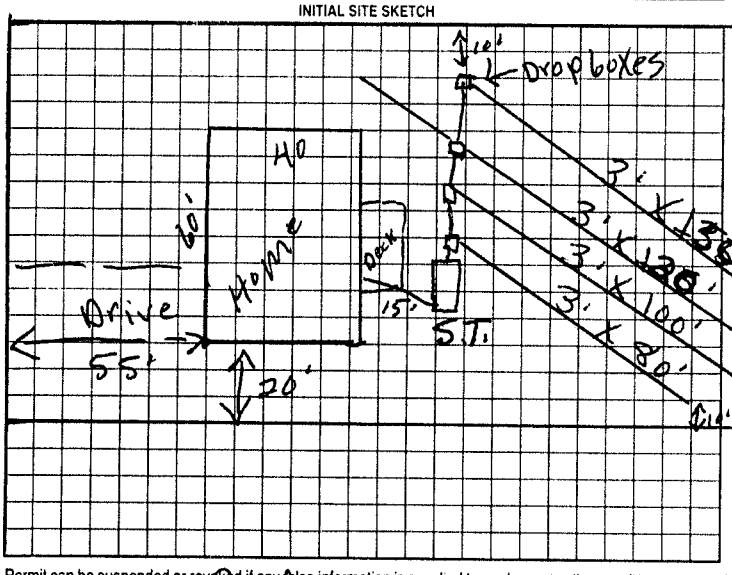

AS BUILT SKETCH

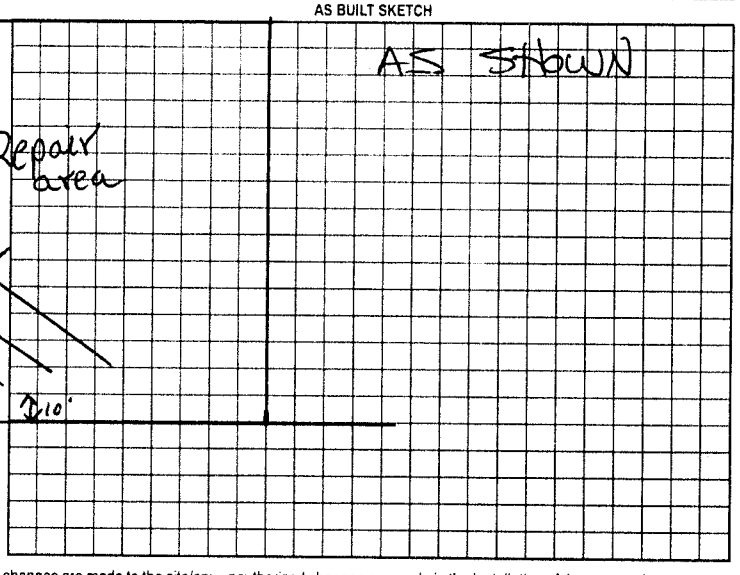

STREET

Permit can be suspended or revoked if any false information is supplied toward securing the permit/any unauthorized changes are made to the site/any unauthorized changes are made in the installation of the system. Improvement Permit with plat valid without expiration. Improvement Permit with site plan valid for sixty months. Authorization to Construct is valid for a period equal to that of Improvement Permit – not to exceed sixty months.

Signed: X. Richard W. Wilson date Installed by: A-1 BACKHOE

Improvement Permit by: P.C. Moore date 10-14-99 Operation Permit by: STEVE HERRICK date 5-8-00

Authorization to Construct by: P.C. Moore date 10-14-99 Existing System Inspection by: date

HEALTH DEPT COPY: WHITE OWNER COPY (FINAL): YELLOW OWNER COPY (INITIAL): PINK