IREDELL COUNTY HEALTH DEPARTMENT

STATESVILLE 704-878-5305 MOORESVILLE 704-664-5281

IMPROVEMENT PERMIT / AUTHORIZATION TO CONSTRUCT / OPERATION PERMIT / EXISTING SYSTEM INSPECTION

PERMIT# 083300 / PIN# 4736 31 6491 (PT) DATE 8-19-99

OWNER OR CONTRACTOR PETREE/STYRON BUILDERS PHONE: Business 873-5083 Home

ADDRESS 2639 FINES CREEK DRIVE, STATESVILLE, NC 28625

LOCATION NC115 N, TL SCOTTS CREEK RD, TL MILLER FARM ROAD, TR ANTLER DRIVE, LOT ON LEFT AT END

SUBDIVISION DEERCROFT BLOCK / SECTION IV LOT 170 LOT AREA 0.688 ACRE SITE CLASS PS DESIGN FLOW 360 L.T.A.R. 0.25 SPD/FT²

Septic Tank: 1000 Gallons; STB 1012 Date 2-29-01
Pump Tank: Gallons; PT Date
Pump Make: Model Serial No.
Nitrification Field: No. Fields 1 Square Feet 1440 Linear Feet 480
No. Lines SIX Trench Width 36" Max Trench Bottom Depth 36" Gravel Depth 12"

☑ New System ☐ Repair System Type: I (II) III IV V VI
System Description: CONVENTIONAL GRAVITY
Repair System Description: RPBPS GRAVITY/pump
Maintenance Agreement Required: ☐ Yes ☑ No


☑ House/Mod. Home No. Bedrooms 3
☐ Mobile Home No. Bathrooms 2
☐ Business No. Employees
☐ Other
☐ Slab ☑ Crawl Space ☐ Basement w/plumbing ☐ Basement wo/plumbing

Water Supply: ☐ Individual ☑ Public ☐ Community


Comments/Conditions: INSTALL SUBSURFACE INTERCEPT DRAINAGE DITCH AT LOCATION SHOWN BEGINNING 42" DEEP

Comments/Conditions SYSTEM INSTALLED AS SHOWN WITH POLYLOK @ MARKER

INITIAL SITE SKETCH

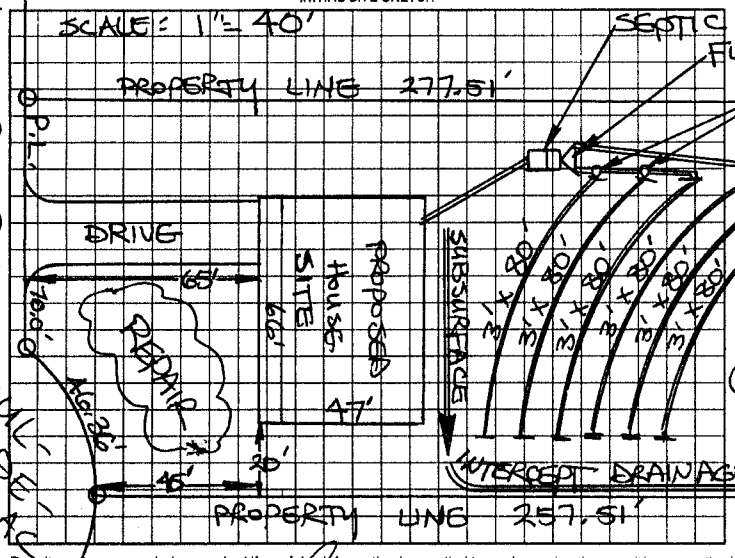

AS BUILT SKETCH

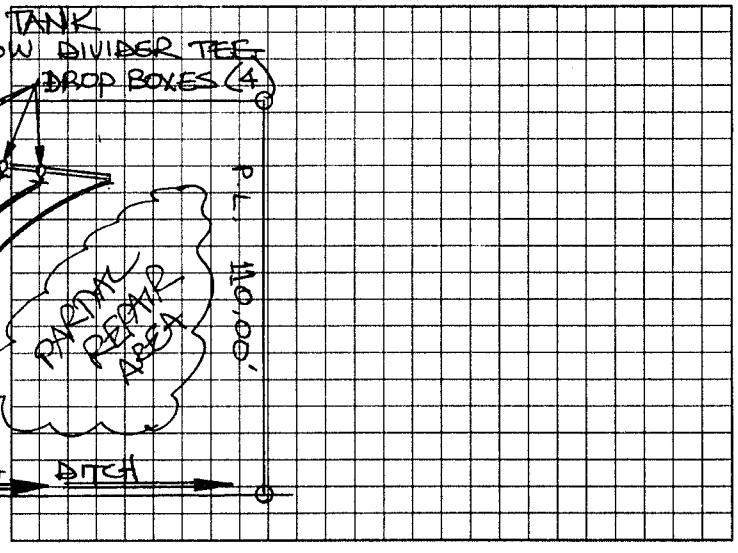

Permit can be suspended or revoked if any false information is supplied toward securing the permit/any unauthorized changes are made to the site/any unauthorized changes are made in the installation of the system. Improvement Permit with plat valid without expiration. Improvement Permit with site plan valid for sixty months. Authorization to Construct is valid for a period equal to that of Improvement Permit – not to exceed sixty months.

Signed: date 8/20/99 Installed by: STEVE JORDAN

Improvement Permit by: STEVE HEDRICK date 8-19-99 Operation Permit by: Jim Cook REI date 5-18-01

Authorization to Construct by: STEVE HEDRICK date 8-19-99 Existing System Inspection by: date

HEALTH DEPT. COPY: WHITE OWNER COPY (FINAL) YELLOW OWNER COPY (INITIAL) PINK