IREDELL COUNTY HEALTH DEPARTMENT

STATESVILLE 704-878-5305 MOORESVILLE 704-664-5281

IMPROVEMENT PERMIT / AUTHORIZATION TO CONSTRUCT / OPERATION PERMIT / EXISTING SYSTEM INSPECTION

PERMIT# 083249 PIN# 4726 31 6491 (PT) DATE 11-23-99

OWNER OR CONTRACTOR TIM HOPE PHONE: Business Home 528-0518

ADDRESS P.O. BOX 5882, STATESVILLE NC 28687

LOCATION NC 115 N, TL SCOTTS CREEK, TL MILLER FARM, TR ANTLER DRIVE, NEXT TO LAST LOT ON RIGHT

SUBDIVISION DEERCROFT BLOCK / SECTION IV LOT 176 LOT AREA 0.590 ACRE SITE CLASS PS DESIGN FLOW 360 L.T.A.R. 0.25 gpd/ft²

Septic Tank: 1000 Gallons; STB 1012 Date 4.6.00

Pump Tank: Gallons; PT Date

Pump Make: Model Serial No.

Nitrification Field: No Fields 1 Square Feet 1440 Linear Feet 480

No Lines SIX Trench Width 36" Max Trench Bottom Depth 36" Gravel Depth 12"

☑ New System ☐ Repair System Type: I (II) III IV V VI

System Description: CONVENTIONAL GRAVITY

Repair System Description: 25% REDUCTION PUMP

Maintenance Agreement Required: ☐ Yes ☑ No

☑ House/Mod. Home No. Bedrooms 3

☐ Mobile Home No. Bathrooms 2

☐ Business No. Employees

☐ Other

☐ Slab ☐ Crawl Space ☐ Basement w/plumbing ☐ Basement wo/plumbing


Water Supply: ☐ Individual ☑ Public ☐ Community

Comments:/Conditions:


TL 0.59 AC

Comments:/Conditions.

INITIAL SITE SKETCH

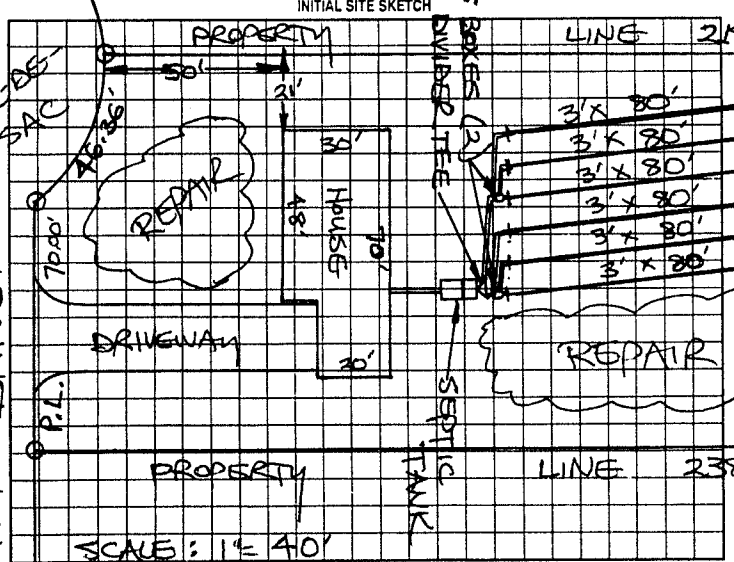

AS BUILT SKETCH

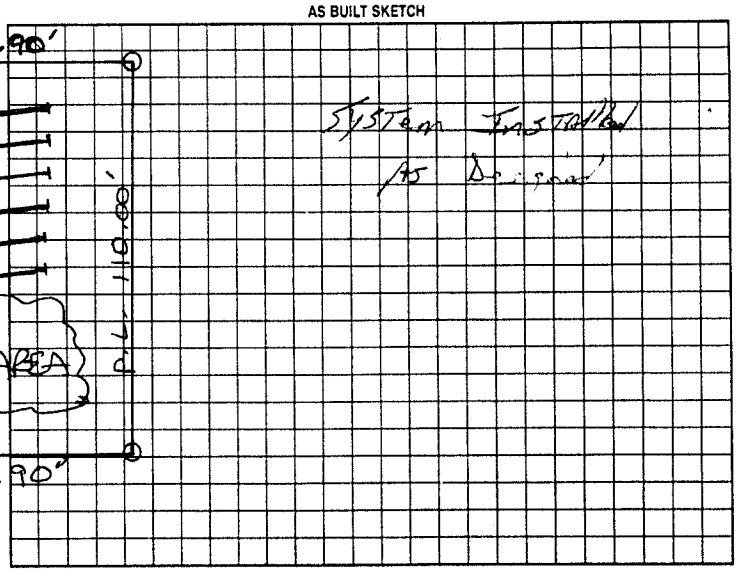

Permit can be suspended or revoked if any false information is supplied toward securing the permit/any unauthorized changes are made to the site/any unauthorized changes are made in the installation of the system. Improvement Permit with plat valid without expiration. Improvement Permit with site plan valid for sixty months. Authorization to Construct is valid for a period equal to that of Improvement Permit – not to exceed sixty months.

Signed: date 11-23-99 Installed by: Tommy Frye

Improvement Permit by: STEVE HEDRICK date 11-23-99 Operation Permit by: Jc Potter date June 29 2000

Authorization to Construct by: STEVE HEDRICK date 11-23-99 Existing System Inspection by: date

HEALTH DEPT. COPY: WHITE OWNER COPY (FINAL) YELLOW OWNER COPY (INITIAL) PINK