IREDELL COUNTY HEALTH DEPARTMENT

STATESVILLE 704-878-5305 MOORESVILLE 704-664-5281

IMPROVEMENT PERMIT / AUTHORIZATION TO CONSTRUCT / OPERATION PERMIT / EXISTING SYSTEM INSPECTION

PERMIT # 153626 PIN # 4726-47-9142 DATE 22 December 08

OWNER or APPLICANT Kirk H. Bandy PHONE: Business 704 902-1415 Home:

OWNER or APPLICANT ADDRESS 142 Wineberry Ln. Statesville, N.C.

LOCATION / DIRECTIONS Hwy 115 N TL Midway Rd. TL ½ mile onto Short Dog Dr. - TL - ENDS OF Pavement - 60 to End.

SUBDIVISION BLOCK / SECTION 1 LOT # 1 LOT AREA 8 ac. DESIGN FLOW 360 gpd L.T.A.R. 0.25 lot/ac

Septic Tank 1000 Gallons: STB 1017 Date 8-6-08

Pump Tank Gallons: P T Date

Pump Make Model Serial #

Nitrification Field No Fields 1 No Lines 4 Linear Feet 360

Trench Width 36" Max. Trench Bottom Depth 24" Gravel Depth N/A

☑ New System ☐ Repair ☐ Expansion System Type I II (III) IV V VI

System Description: 25% Reduction

Repair System Description: 25% Reduction

Maintenance Agreement Required ☐ YES ☑ NO

☑ GRAVITY ☐ PRESSURE

☑ Residence No. Bedrooms 3

☐ Business No. Persons

☐ Other No. Employees

☐ Slab ☑ Crawl Space

☐ Basement w/plumbing ☐ Basement w/o plumbing

Water Supply: ☐ Private ☑ Public ☐ Community

Comments / Conditions: Follow contour / Shallow placement of system not to exceed 24" trench depth. /

Comments / Conditions

INITIAL SITE SKETCH

Please see Attached Site Sketch.

AS BUILT SKETCH

Permit can be suspended or revoked if any false information is supplied toward securing the permit / any unauthorized changes are made to the site / any unauthorized changes are made in the installation of the system.

☐ *IMPROVEMENT PERMIT w / plat valid without expiration.* ☑ *IMPROVEMENT PERMIT w / site plan valid for 60 mos.* ☑ *AUTHORIZATION TO CONSTRUCT valid for period equal to IMPROVEMENT PERMIT-not to exceed 60 mo.*

Owner / Applicant Signature: Chad Hall Date 12/22/08

Improvement Permit by: [signature], R.S. Date 22 Dec. 08

Authorzation to Construct by: [signature], R.S. Date 22 Dec. 08

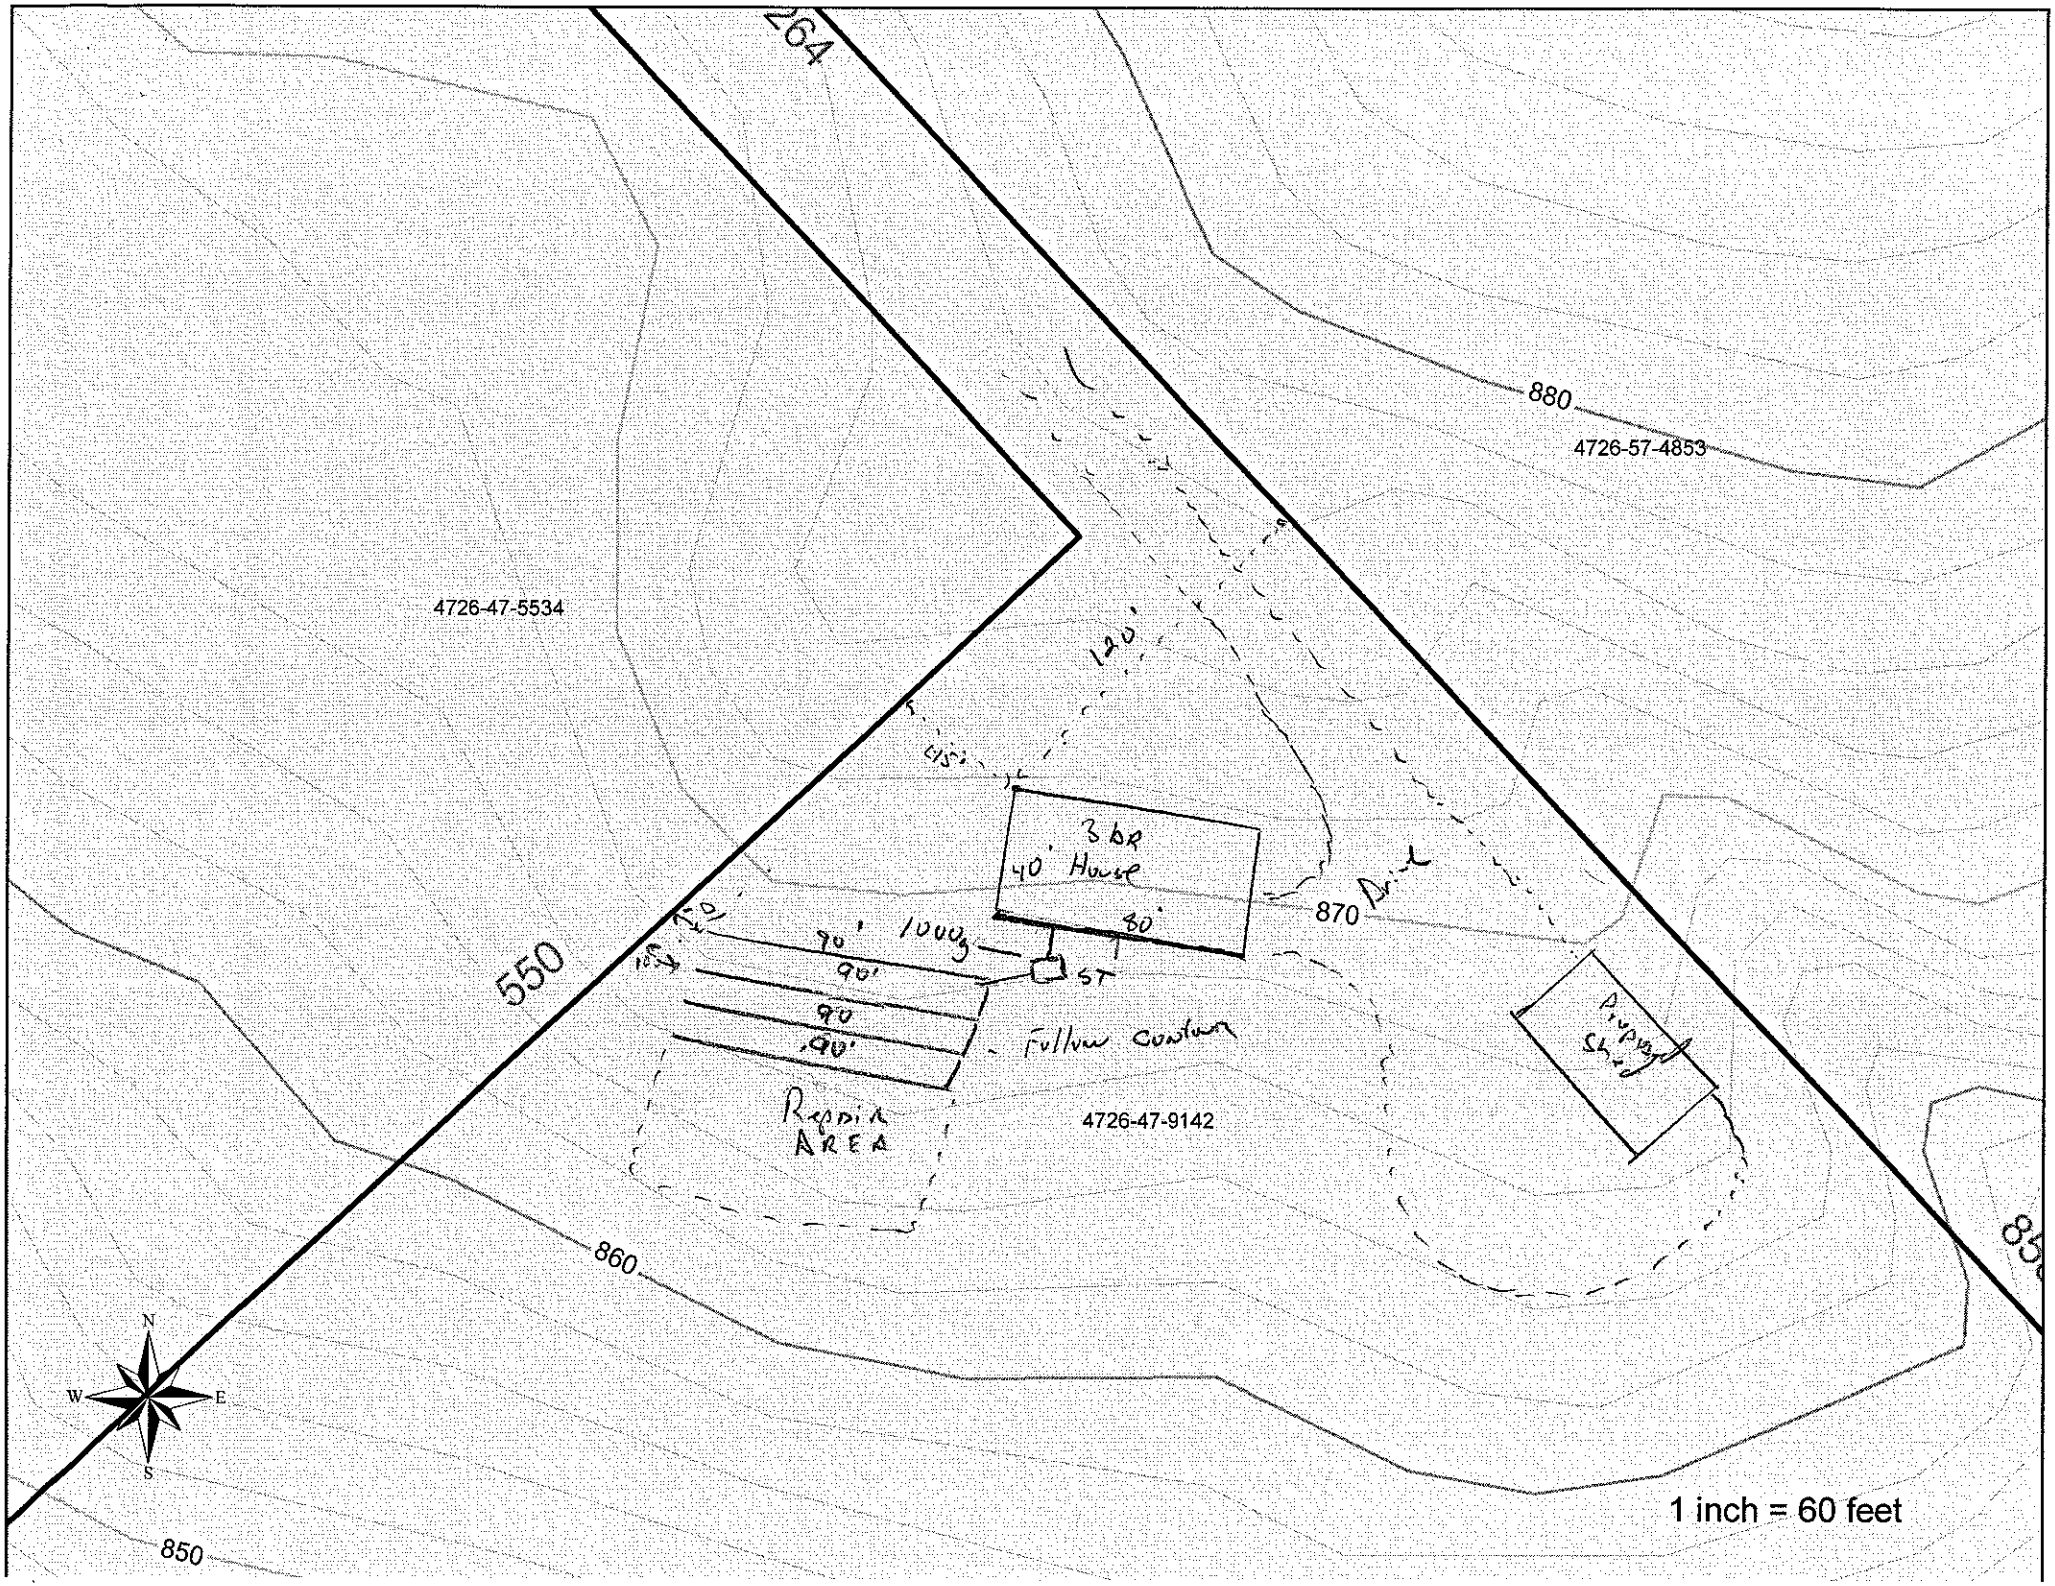
YOU SHOULD CONTACT A LOCATOR SERVICE PRIOR TO ANY EXCAVATION.

Installed by: Gunner Grading

Operation Permit by: [signature] Date: 2-9-09

Existing System Inspected by: Date:

WHITE COPY Environmental Health YELLOW COPY (Final) Owner / Applicant PINK COPY (Initial) Owner / Applicant


264
880
4726-57-4853
4726-47-5534
120'
3 BR
40' House
80'
870
550
90'
90'
90'
90'
ST
Repair Area
4726-47-9142
860
850
N
W
E
S
1 inch = 60 feet