IREDELL COUNTY HEALTH DEPARTMENT

Statesville Office (704) 878-5305 Mooresville Office (704) 660-3625 PERMIT # 234186.

SEPTIC IMPROVEMENT PERMIT / AUTHORIZATION TO CONSTRUCT / OPERATION PERMIT / EXISTING SYSTEM

PIN # 4726480192

APPLICANT/OWNER: Steve Brotherton. APPLICANT ADDRESS: 119 Summerchase Lane Mooresville NC 28117.

SITE ADDRESS: 140 Short Dog Drive Statesville NC 28625 PHONE: 704-201-3503 ALT. PHONE

SITE DIRECTIONS: Hwy 115 N to Midway Rd Left on Short Dog Drive. SAP CONTROLLED: ☐ YES ☒ NO

SUBDIVISION: Bedgle Run. SECTION: 1 LOT # 3 LOT AREA: 9.256 DESIGN FLOW: 400 L.T.A.R.: .30

Septic Tank 1000 (gal) STB 794 Date 12-15-18
Pump Tank 1000 (gal) PT 794 Date 12-18-18
Pump Make Model Serial #
Nitrification Fields 1 # Lines 4 Linear Ft 400
Trench Width 36 Trench Bottom Depth(Low side) 28 Gravel Depth ~


☐ New System ☐ Repair ☐ Expansion System Type: I II ☒ III IV V VI
System Description: 25% Reduction.
Repair System Description: 25% Reduction.
Maintenance Agreement Required: ☐ YES ☒ NO
☒ GRAVITY ☐ PRESSURE

☒ Residence No. Bedrooms 4
☐ Business No. Persons 8
☐ Other No. Employees
☐ Slab ☒ Crawl Space
☐ Basement w/plumbing ☐ Basement w/o plumbing

Water Supply: ☐ Private ☐ Public ☒ Community

Comments / Conditions: * Install Septic drainlines on the Contour of the land & Utilize Serial Distribution. Building / Shed to have Plumbing / utilize Grinder pump. 2 1,000 gallon tanks must be in series.

INITIAL SITE SKETCH

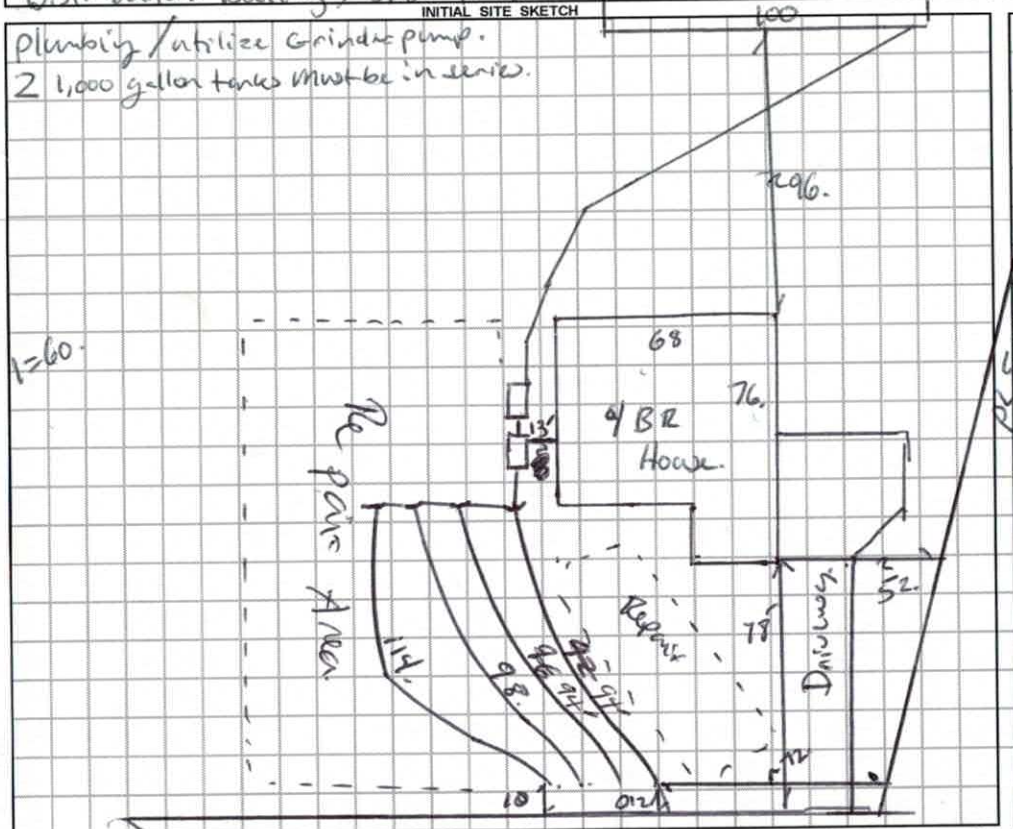

AS BUILT SKETCH

Installed as shown

Permit can be suspended or revoked if any false information is supplied toward securing the permit / any unauthorized changes are made to the site / any unauthorized changes are made in the installation of the system. **CONTACT A LOCATOR SERVICE PRIOR TO ANY EXCAVATION**

☐ **IMPROVEMENT PERMIT** *with plat valid without expiration.* ☒ **IMPROVEMENT PERMIT** *with site plan valid for 60 mos.* ☒ **AUTHORIZATION TO CONSTRUCT** *valid for period equal to IMPROVEMENT PERMIT--not to exceed 60 mo.*

Owner / Applicant Signature: Rachel Brotherton Date: 4/13/18 Installed by: FJ

IMPROVEMENT PERMIT by: Benjamin A. Bolkins Date: 4/10/2018 OPERATION PERMIT by: Kayla Wilson Date: 1-22-19

AUTHORIZATION TO CONSTRUCT by: Benjamin A. Bolkins Date: 4/10/2018 Existing System Inspected by: Date:

FOR SEPTIC FINAL INSPECTION: CALL 704-664-3703 between 8am-9am the day the inspection is needed. Be sure to speak with an inpsector to confirm your inspection time.

DEPARTMENT OF HEALTH AND HUMAN SERVICES
DIVISION OF PUBLIC HEALTH, ENVIRONMENTAL HEALTH SECTION
ON-SITE WATER PROTECTION BRANCH

Sheet 1 of 1
PROPERTY ID #: 47264920 17

SOIL/SITE EVALUATION
***for* ON-SITE WASTEWATER SYSTEM**
(Complete all fields in full)

APPLICATION DATE 3/16/2018.
DATE EVALUATED: 4/1/2018.
PROPOSED FACILITY: 4BR Home
PROPOSED DESIGN FLOW (.1949): 480.
PROPERTY SIZE: 9 Acres
PROPERTY RECORDED: Yes.
WATER SUPPLY: ☐ Private ☑ Public ☐ Well ☐ Spring ☐ Other
EVALUATION METHOD: ☐ Auger Boring ☐ Pit ☐ Cut
TYPE OF WASTEWATER: ☑ Sewage ☐ Industrial Process ☐ Mixed

PROFILE #	.1940 LANDSCAPE POSITION/ SLOPE %	HORIZON DEPTH (IN.)	SOIL MORPHOLOGY (.1941) .1941 STRUCTURE/ TEXTURE	SOIL MORPHOLOGY (.1941) .1941 CONSISTENCE/ MINERALOGY	OTHER PROFILE FACTORS .1942 SOIL WETNESS/ COLOR	.1943 SOIL DEPTH	.1956 SAPRO CLASS	.1944 RESTR HORIZ	PROFILE CLASS & LTAR
1	10-12%	0-7	scl sbk	ss sp fr sbk	2.5Y 4/6	49		Some Lith mottles.	PS .3.
		7-32	c sbk	ss sp fm					
		32-48	cl. wsbk	ss sp fr					
2	10-12%	0-3	scl sbk	ss sp fr sbk	2.5Y 4/6.	52		Lith. Some Mica	PS .3.
		3-21	c sbk	ss sp fm					
		21-52	cl wsbk	ss sp fr					
3	10-12%	0-5	scl sbk	ss sp fr sbk	2.5Y 4/6	49		Lith Some Mica	PS .3.
		5-35	c sbk	ss sp fm					
		35-49	cl wsbk	ss sp fr					
4	10-12%	0-7	scl sbk	ss sp fr sbk	2.5Y 4/6	50		Lith Mica	PS .3.
		7-29	c sbk	ss sp fm					
		29-50	cl wsbk	ss sp fr					

DESCRIPTION	INITIAL SYSTEM	REPAIR SYSTEM
Available Space (.1945)	400	400
System Type(s)	III 25%	III 25%
Site LTAR	.30	.30.

OTHER FACTORS (.1946):
SITE CLASSIFICATION (.1948): PS
EVALUATED BY: B. Hines
OTHER(S) PRESENT:

COMMENTS: Ground proposed Garage
92 96 98.

LEGEND

use the following standard abbreviations

LANDSCAPE POSITION	GROUP	SOIL TEXTURE	CONVENTIONAL .1955 LTAR*	LPP .1957 LTAR*	MINERALOGY/ CONSISTENCE	STRUCTURE
CC (Concave Slope) CV (Convex Slope) D (Drainage Way) DS (Debris Slump) FP (Flood Plain) FS (Foot Slope) H (Head Slope) L (Linear Slope) N (Nose Slope) R (Ridge) S (Shoulder Slope) T (Terrace)	I	S (Sand) LS (Loamy Sand)	1.2 - 0.8	0.6 - 0.4	SEXP (Slightly Expansive) EXP (Expansive)	G (Single Grain) M (Massive) CR (Crumb) GR (Granular) SBK (Subangular Blocky) ABK (Angular Blocky) PL (Platy) PR (Prismatic)
	II	SL (Sandy Loam) L (Loam)	0.8 - 0.6	0.4 - 0.3		
	III	Si (Silt) SiCL (Silty Clay Loam) CL (Clay Loam) SCL (Sandy Clay Loam) SiL (Silt Loam)	0.6 - 0.3	0.3 - 0.15		
	IV	SC (Sandy Clay) SiC (Silty Clay) C (Clay)	0.4 - 0.1	0.2 - 0.05		
		O (Organic)	None	None		

MOIST	WET
VFR (Very Friable)	NS (Non-sticky)
FR (Friable)	SS (Slightly Sticky)
FI (Firm)	S (Sticky)
VFI (Very Firm v. Very Sticky)	VS (Very Sticky)
EFI (Extremely Firm)	NP (Non-plastic)
	SP (Slightly Plastic)
	P (Plastic)
	VP (Very Plastic)

*Adjust LTAR due to depth, consistence, structure, soil wetness, landscape, position, wastewater flow and quality.


NOTES

HORIZON DEPTH	In inches below natural soil surface
DEPTH OF FILL	In inches from land surface
RESTRICTIVE HORIZON	Thickness and depth from land surface
SAPROLITE	S(suitable) or U(unsuitable)
SOIL WETNESS	Inches from land surface to free water or inches from land surface to soil colors with chroma 2 or less - record Munsell color chip designation
CLASSIFICATION	S (Suitable), PS (Provisionally Suitable), or U (Unsuitable)

Evaluation of saprolite shall be by pits.

Long-term Acceptance Rate (LTAR): gal/day/ft²

Show profile locations and other site features (dimensions, reference or benchmark, and North).

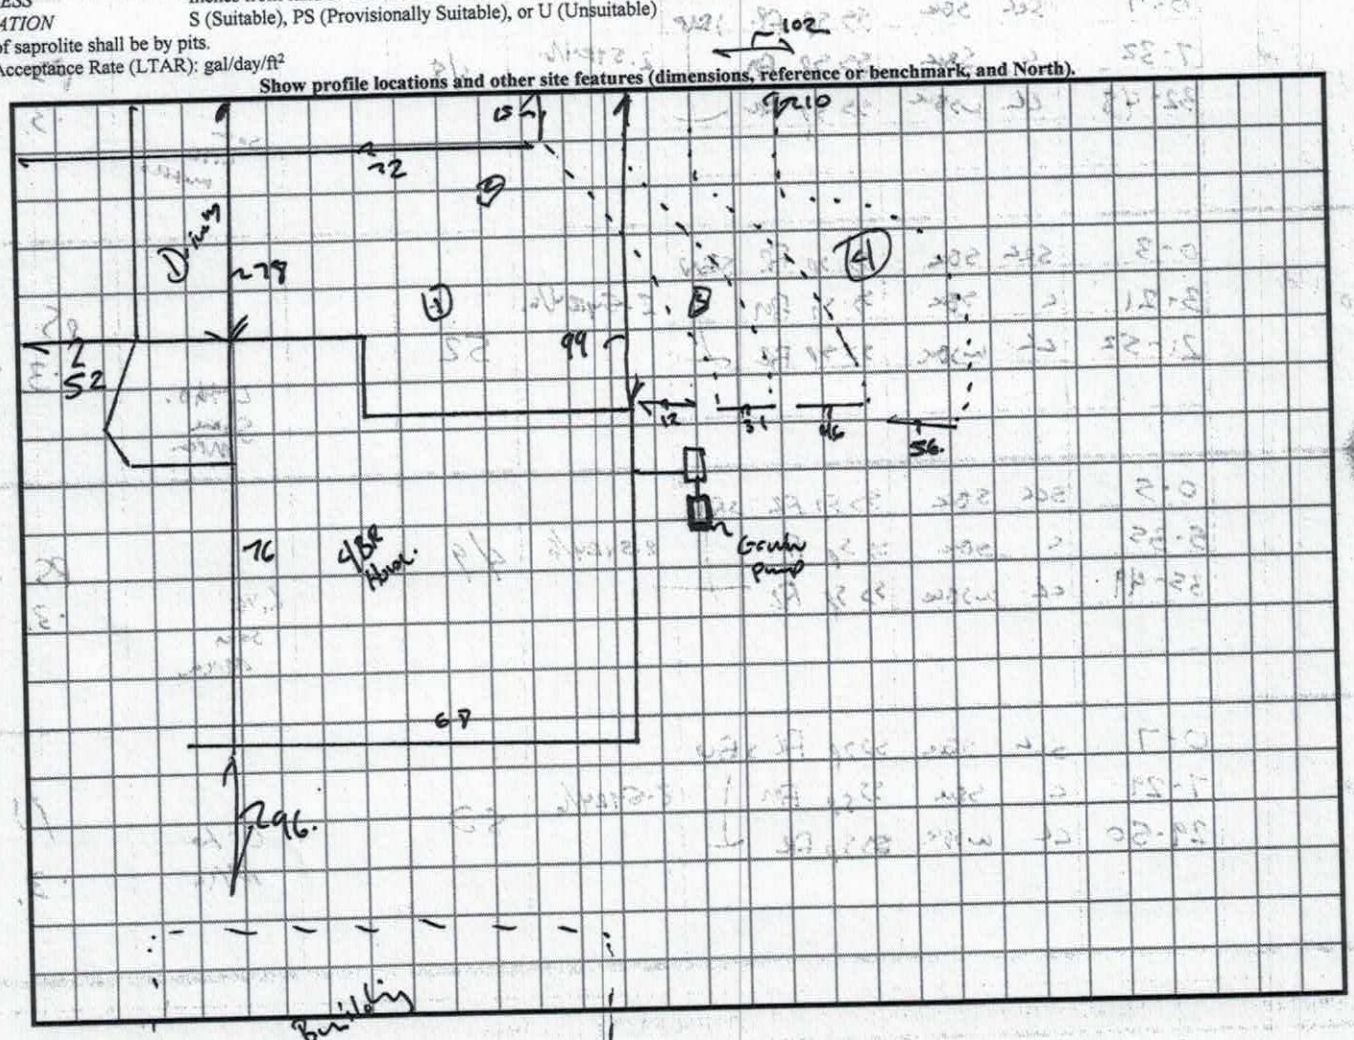

IREDELL COUNTY DEPARTMENT of ENVIRONMENTAL HEALTH

APPLICATION FORM

Application For: ( ) New Well Permit ( ) Well Repair Permit ( ) Well Abandonment
(✓) Septic Improvement Permit (✓) Authorization to Construct ( ) Existing System Inspection ( ) Septic System Repair

THE ABOVE PERMIT DOCUMENTS WILL BECOME INVALID IF INFORMATION PROVIDED ON THIS APPLICATION IS FALSIFIED OR CHANGED, OR IF THE SITE IS ALTERED. THE IMPROVEMENT PERMIT IS VALID FOR EITHER 60 MONTHS OR WITHOUT EXPIRATION DEPENDING UPON DOCUMENTATION SUBMITTED. APPLICATION WITH SITE PLAN 60 MONTHS, APPLICATION WITH COMPLETE, SCALED PLAT WITHOUT EXPIRATION. SEE 15A NCAC 18A .1937(f) FOR DETAILS.

Page 2: *Site Plan Worksheet* form MUST accompany this application

The following optional attachments may also be submitted: ( ) Survey Plat, scaled no more than 1 inch = 60 feet
Place an (X) beside whichever is submitted if applicable ( ) Custom Site Plan, scaled no more than 1 inch = 60 feet

Applicant Information: (PRINT CLEARLY)

Applicant Name: Steve Bratherton Address: 119 Summerchase Ln, Mooresville Zip: 28117
Applicant Email: _____ Phone: 704-201-3503 Alt. Phone: _____
Owner Name: Steve Bratherton Address: _____ Zip: _____
Owner Email: _____ Phone: _____ Alt. Phone: _____

Property Information:

Street Address: 140 Short Dog Drive
Subdivision Name: Beagle Run Section/Phase: 1 Lot Number: 3
Driving Directions: Hwy 115 N to Midway Rd left on Short Dog Drive

Site Development Information: *(check or complete ALL that apply* 3/5/18 SAN

(✓) New Single Family Residence
( ) New Multi-Family Residence
(✓) Accessory Building
( ) Bedroom(s) Addition
( ) Repair to failing septic system ___ Tank ___ Drain lines Describe Problem: _____
Non-Residential Site Development: Type of Business: _____
Square Footage of Building: 2150 Max. Number of Employees: ____ Max. Number of Seats/Beds/Other: 1 Bath

Maximum Number of Bedrooms: 3 4
Maximum Number of Occupants: 2
( ) Swimming Pool
( ) Other Addition/Structure: _____

CHECK FOUNDATION TYPE
(✓) Crawl Space Foundation
( ) Concrete Slab Foundation
( ) Basement with Plumbing
( ) Basement without Plumbing

Water Supply: ( ) Replacement Well – Reason: _____
( ) Multi-connection Well Number of Houses: _____ Number of Persons: _____
( ) New Well ( ) Existing Well (✓) Community Well ( ) City Water ( ) Other Public Water

Desired Septic System Type: *(you may rank in order of preference)* Year existing system installed: _____
(✓) No Preference ( ) Alternative ( ) Conventional ( ) Innovative ( ) Modified Conventional ( ) Other: _____

Please answer the following to the best of your ability:
( ) Yes (✓) No Does the site contain any jurisdictional wetlands?
( ) Yes (✓) No Is any non-domestic sewage (i.e. industrial) to be generated?
( ) Yes (✓) No Is the site subject to approval by any other public agency?

I have read this application and certify that the information provided herein is true, complete, and correct. Authorized county and state officials are granted right of entry to conduct necessary inspections to determine compliance with applicable laws and rules. I understand that I am solely responsible for the proper identification and labeling of all property lines and corners and making the site accessible so that a complete site evaluation can be performed.

Signature: _____ 3/16/18
Property owner or owner's legal representative signature (SIGNATURE REQUIRED) DATE

DOCUMENTATION TO AUTHORIZE AN OWNER'S LEGAL REPRESENTATIVE

Applications for permits require the "signature of the owner or owner's legal representative" (15A NCAC 18A .1937). If the owner does not sign the application himself or herself, they can submit any one of the following documents to designate their legal representative:

Power of Attorney; Real Estate Contract; Estate executor; Bankruptcy trustee; Court ordered guardianship

In the absence of the above documentation, the property owner may provide the local health department with documentation that designates a legal representative. A property owner may:

Complete this form to document his or her legal representative, or provide his or her own form that contains the information in this form.

If there are multiple property owners, then all property owners must sign the form that designates a legal representative.

By signing a form that designates a legal representative for purposes of 15A NCAC 18A .1937, the property owner authorizes that representative to act on their behalf in matters pertaining to the application and permitting process, including signing or receiving any application, document or permit. The owner retains full responsibility to meet all permit conditions specified by the local health department.

I, Steve Brotherton, am the legal owner(s) of the property located at 140 Short Dog Dr., identified as PIN (Parcel Identification Number) 4726480192.000, located in Iredell County, North Carolina.

I do hereby authorize (**print legal representative/company name**) _____, _____, to act as an agent on my behalf in applying for/signing/obtaining any of the documents described below.

- Application for Improvement Permit (IP) / Authorization to Construct (AC)
- Improvement Permit (IP) / Authorization to Construct (AC)
- Application for soil-site evaluation (new/repair)
- Application/permit for private drinking water well/well abandonment
- Application for Compliance Inspection

I agree to abide by all decisions and/or conditions between the legal representative acting on my behalf and the Iredell County Department of Public Health, Environmental Health Division.

Steve Brotherton 3/12/24

Signature of Owner(s) Date Signature of Witness Date

Please return this signed form to the appropriate office:


Mooresville - Environmental Health
ronda.hart@co.iredell.nc.us
Fax: 704-662-3239
610 E. Center Avenue, Mooresville, NC 28115

Statesville - Environmental Health
adrienne.shea@co.iredell.nc.us
Fax: 704-871-3483
349 N. Center Street, Statesville, NC 28677

IREDELL COUNTY DEPARTMENT of ENVIRONMENTAL HEALTH

SITE PLAN WORKSHEET

SEE THE "SAMPLE SITE PLAN" BELOW. *INCOMPLETE SITE PLANS WILL BE RETURNED TO YOU FOR COMPLETION AND MAY RESULT IN A DELAY IN THE ISSUANCE OF YOUR SEPTIC SYSTEM OR WELL PERMIT!!!*

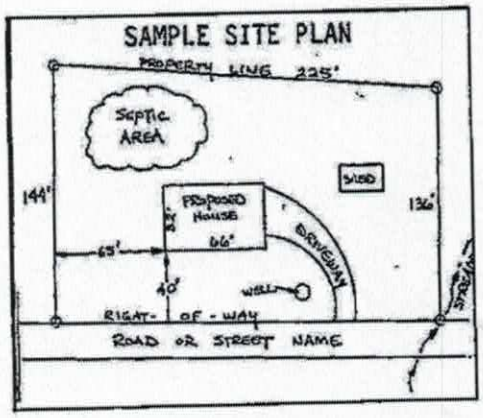

Place an (X) beside each item as you complete the site plan:


- (✓) Property Line measurements are clearly identified
- (✓) All proposed structures are indicated
- (✓) Front and side setbacks from property line
- (✓) Preferred driveway location
- ( ) Preferred well location
- (✓) Preferred septic system location
- ( ) North arrow, or other sufficient indicator of direction

Circle N/A on the following if appropriate:

Location of septic systems and wells within 100' of your property	N/A
Location of easements and rights of ways on your property	N/A
Location of any designated wetlands on the property	N/A

USE THIS SPACE TO DRAW YOUR SITE PLAN

Show: proposed house or business footprint, wells, water lines, patios, pools and decks, and any other item that will occupy space on the site

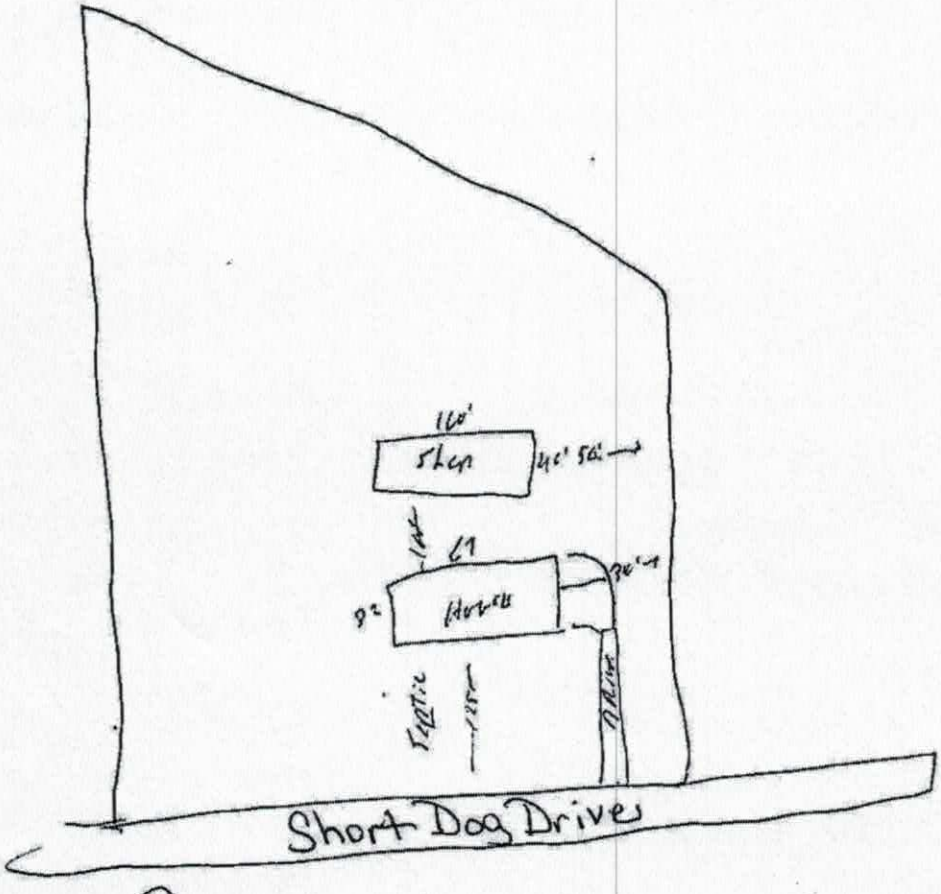


Signature: _____

Property owner or owner's legal representative signature (SIGNATURE REQUIRED)

3/6/24

DATE

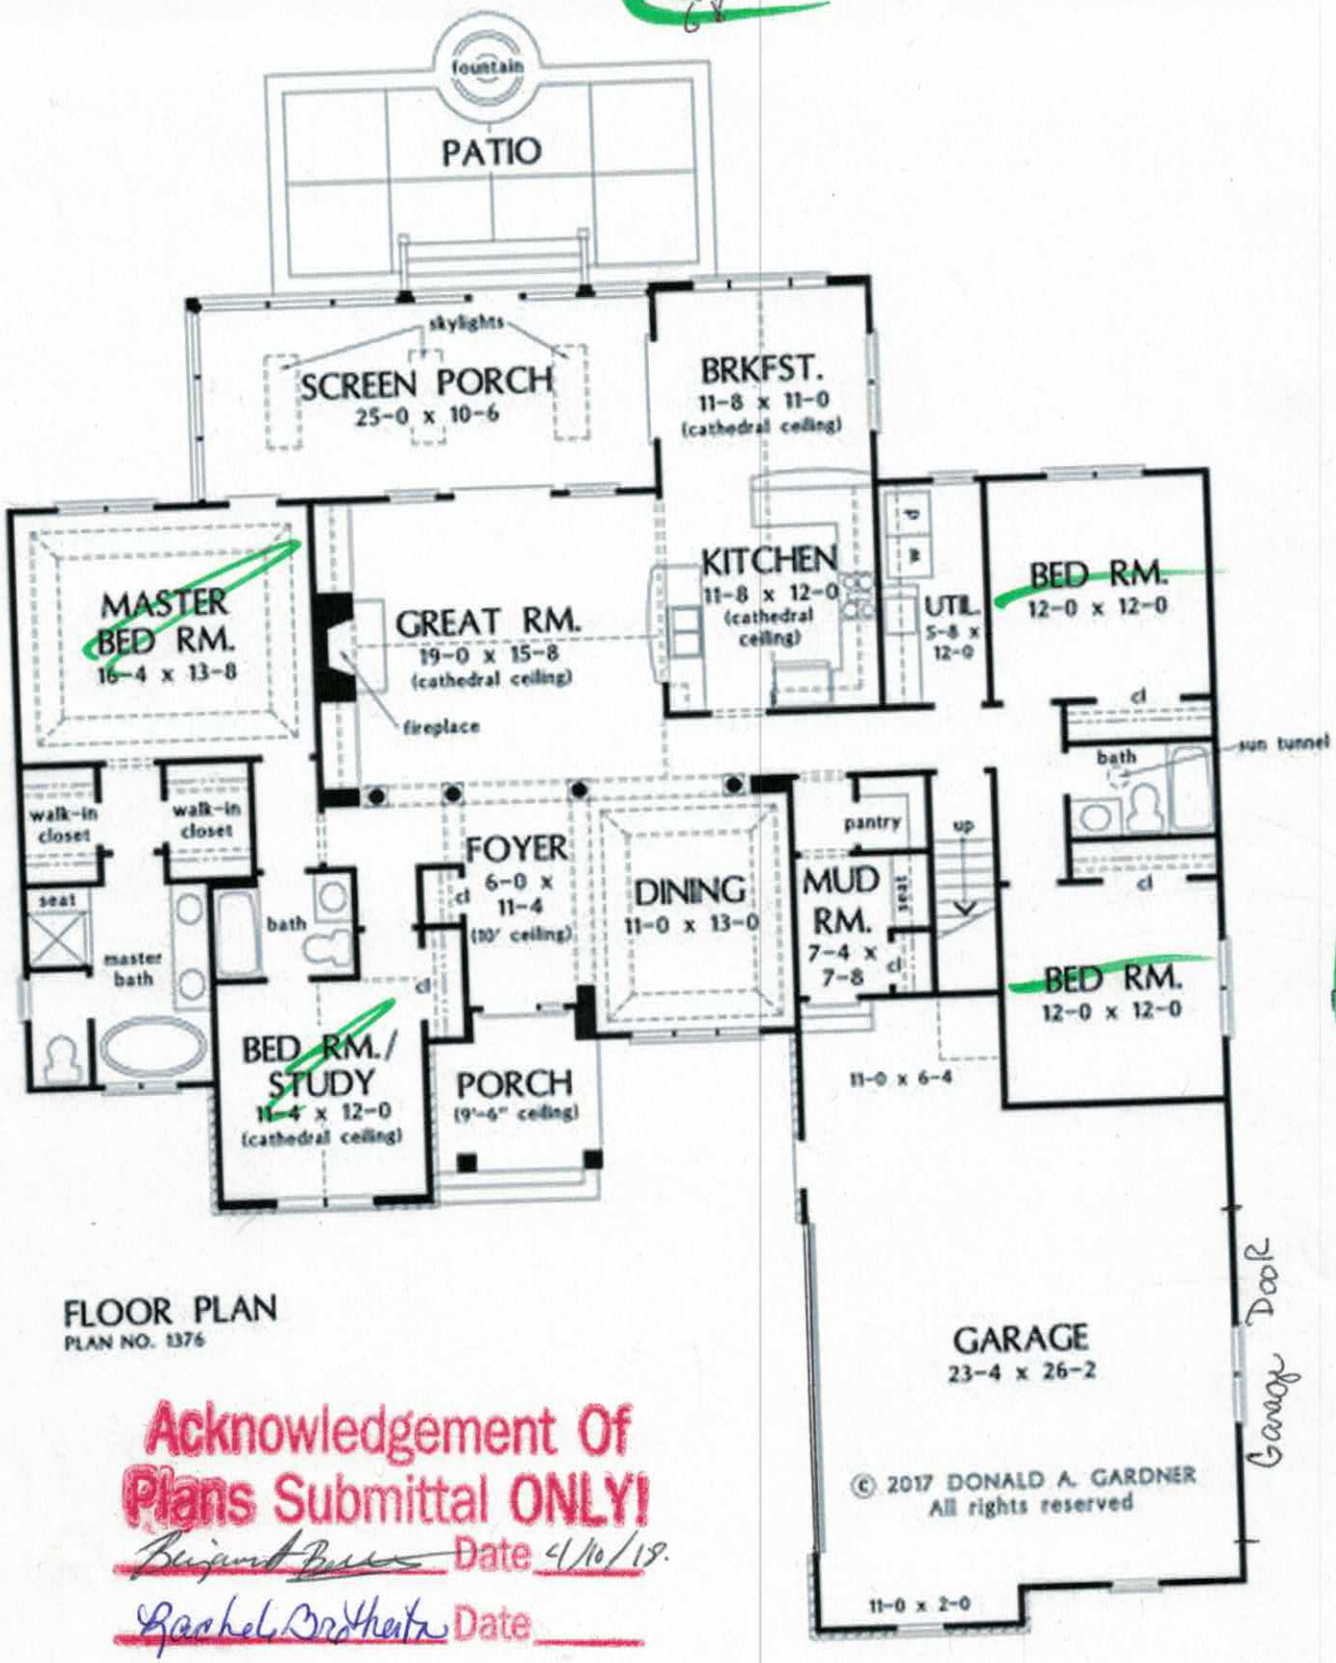

FLOOR PLAN
PLAN NO. 1376

Acknowledgement Of Plans Submittal ONLY!

Benjamin Bass Date 4/10/18.

Rachel Brotherton Date

140 Short Dog Drive

IREDELL COUNTY

PO Box 788
349 North Center St.
Statesville, NC 28677

APPLICATION NUMBER
234186
Issue Date: 03/16/2018

ZONING PERMIT

Open Space

Parcel Number	Street Address	Jurisdiction
4726480192.000	140 SHORT DOG DRIVE, STATESVILLE, NC 28625	IREDELL COUNTY

Owner Information	Applicant Information
Owner: BROTHERTON STEVEN DALE+RACHELE O	Applicant: BROTHERTON STEVEN DALE
Address: 142 IREDELL CO, NC 28625	Address: 119 SUMMERCHASE LANE STATESVILLE, NC 28115
Phone:	Phone:

Use Requested	Zone Code
SFD	

Lot Acreage	F Setback	B Setback	L Setback	R Setback	Watershed	Flood Zone
8.250	35.00	35.00	15.00	15.00	NOT	X

Remarks:


The applicant certifies that there are no deed restrictions, contractual agreements or governmental regulations of any kind that interfere with or prohibit the use of the property or the use for which this permit is requested. The applicant further acknowledges that enforcement of deed restrictions, plat conditions and other contractual agreements will not be undertaken by Iredell County and is the sole responsibility of the affected parties.

Applicant: _____ Date: _____

Permit Number	132285	TOTAL FEES:	$ 77.25

234186
Home

ZONING DISCLAIMER

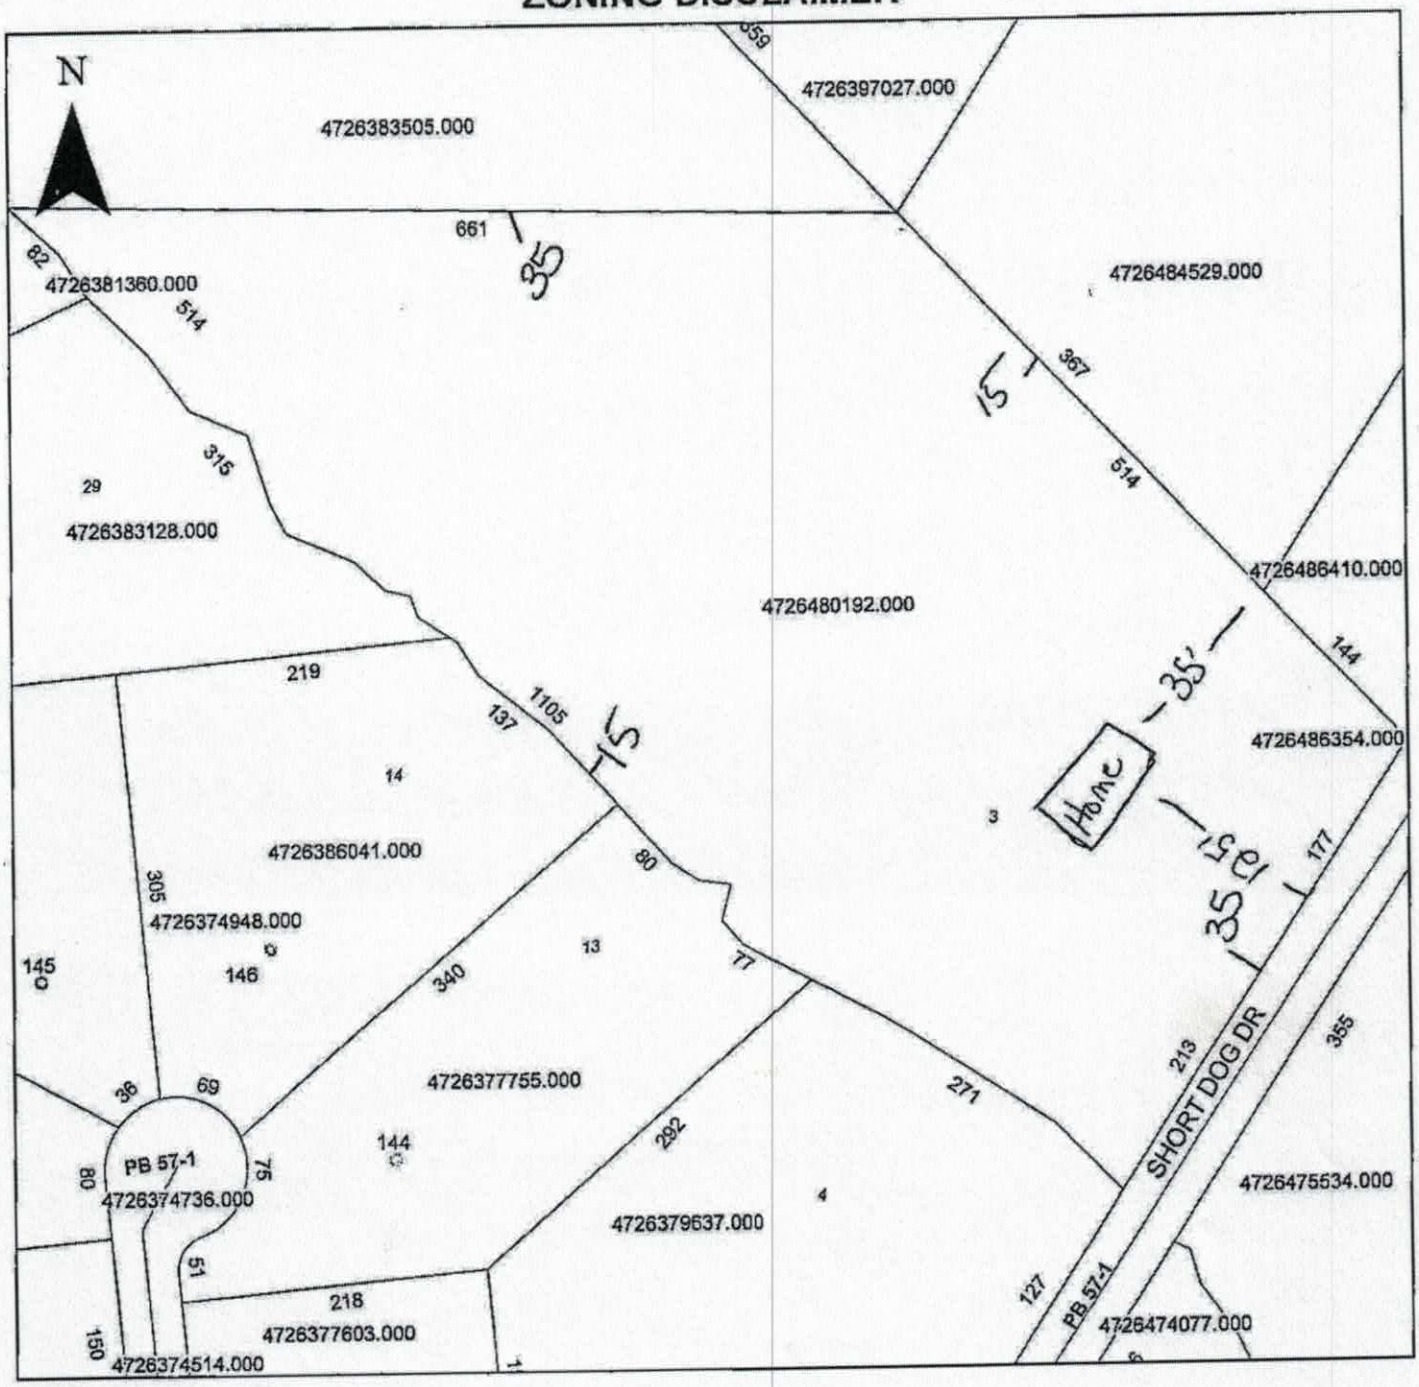

Property Address 140 Short Dog

The applicant certifies that there are no deed restrictions, contractual agreements or governmental regulations of any kind that interfere with or prohibit the use of the property or the use for which this permit is requested. Applicant further acknowledges that the enforcement of deed restrictions, plat conditions, and other contractual agreements will not be undertaken by Iredell County and is the sole responsibility of the affected parties.

X _____
Applicant

X 3/16/18
Date