IREDELL COUNTY HEALTH DEPARTMENT

STATESVILLE 704-878-5305 MOORESVILLE 704-664-5281

IMPROVEMENT PERMIT / AUTHORIZATION TO CONSTRUCT / OPERATION PERMIT / EXISTING SYSTEM INSPECTION

PERMIT# 86097 PIN# 4726316491 P.T. DATE 11-12-99

OWNER OR CONTRACTOR Ricky Upright PHONE: Business 8762961 Home

ADDRESS 106 Creedmore Dr. Statesville, N.C.

LOCATION Scotts Creek TL Miller Farm TR Antler TL Redbuck at corner

SUBDIVISION Deercrest BLOCK / SECTION 4 LOT 159 LOT AREA .62 acres SITE CLASS PS DESIGN FLOW 360 L.T.A.R. .25 gal/sq ft/day

Septic Tank: 1000 Gallons; STB 1007 Date 11-8-99
Pump Tank: Gallons; PT Date
Pump Make: Model Serial No.
Nitrification Field: No Fields 1 Square Feet 1500 Linear Feet 500
No Lines 5 Trench Width 36" Max Trench Bottom Depth 36" Gravel Depth ~~24~~ 12"

☑ New System ☐ Repair System Type: I (II) III, IV, V, VI
System Description: Conv. Gravity
Repair System Description: 25% Reduction
Maintenance Agreement Required: ☐ Yes ☑ No

☑ House/Mod. Home No. Bedrooms 3
☐ Mobile Home No. Bathrooms 2
☐ Business No. Employees
☐ Other


☐ Slab ☑ Crawl Space ☐ Basement w/plumbing ☐ Basement wo/plumbing

Water Supply: ☐ Individual ☑ Public ☐ Community


Comments:/Conditions: 230' Redbuck

Comments:/Conditions:

INITIAL SITE SKETCH

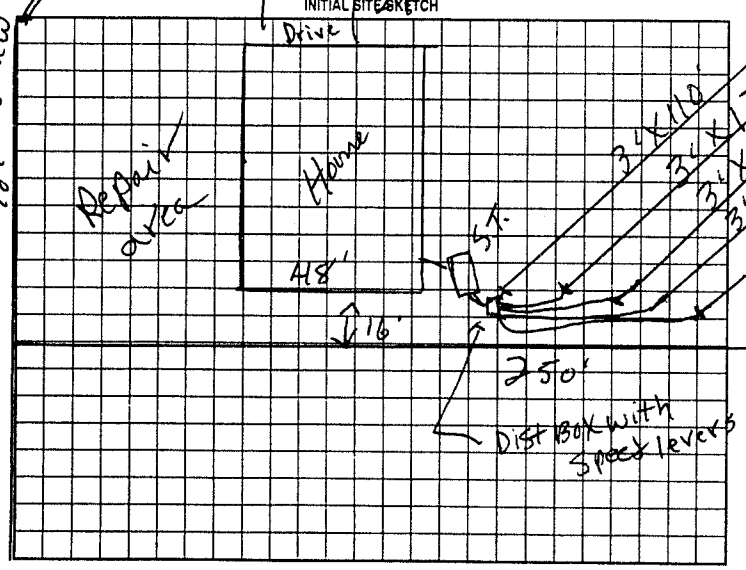

AS BUILT SKETCH

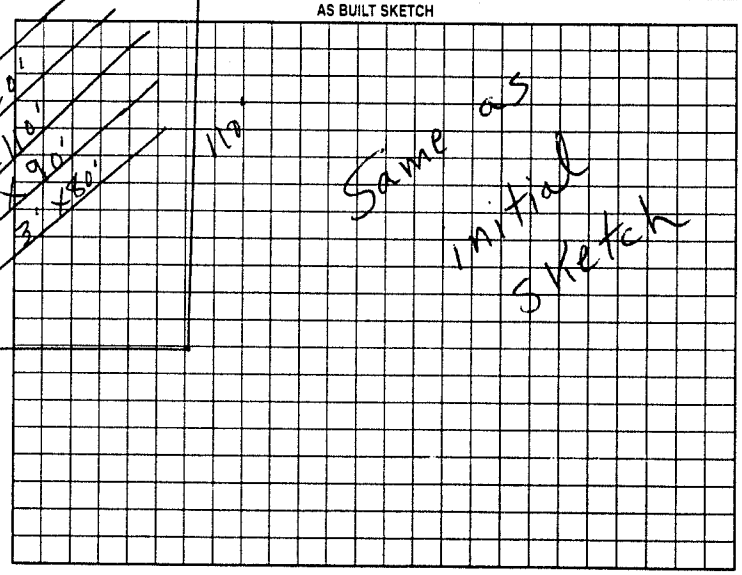

Permit can be suspended or revoked if any false information is supplied toward securing the permit/any unauthorized changes are made to the site/any unauthorized changes are made in the installation of the system. Improvement Permit with plat valid without expiration. Improvement Permit with site plan valid for sixty months. Authorization to Construct is valid for a period equal to that of Improvement Permit – not to exceed sixty months.

Signed: [signature] date

Improvement Permit by: P. C. Moore date 11-12-99

Authorization to Construct by: P. C. Moore date 11-12-99

Installed by: James Hutler

Operation Permit by: P. C. Moore date 12-16-99

Existing System Inspection by: date

HEALTH DEPT. COPY: WHITE OWNER COPY (FINAL): YELLOW OWNER COPY (INITIAL): PINK