IREDELL COUNTY HEALTH DEPARTMENT

STATESVILLE 704-878-5305 MOORESVILLE 704-664-5281

IMPROVEMENT PERMIT / AUTHORIZATION TO CONSTRUCT / OPERATION PERMIT / EXISTING SYSTEM INSPECTION

PERMIT# 087398 PIN# 4726 31 6491 (PART) DATE 1-27-00

OWNER OR CONTRACTOR A.J. BUILDING CO. PHONE: Business 871-0940 Home

ADDRESS 147 HUNTER RIDGE LANE, STATESVILLE, NC 28625

LOCATION ENTER DEERCROFT ON ANTLER DRIVE, TL REDBUCK LANE, TR RIDGEGATE ROAD, 1ST LOT ON (R)

SUBDIVISION DEERCROFT BLOCK / SECTION IV LOT 168 LOT AREA 0.699 ACRE SITE CLASS PS DESIGN FLOW 360 L.T.A.R. 0.25 GPD/FT²

Septic Tank: 1000 Gallons; STB 10/2 Date 6-6-00
Pump Tank: ____ Gallons; PT ____ Date ____
Pump Make: ____ Model ____ Serial No. ____
Nitrification Field: No Fields 1 Square Feet 1440 Linear Feet 480
No Lines SIX Trench Width 36" Max Trench Bottom Depth 36" Gravel Depth 12"

☑ New System ☐ Repair System Type: I (II) III. IV. V. VI
System Description: CONVENTIONAL GRAVITY
Repair System Description: 25% REDUCTION PUMP
Maintenance Agreement Required: ☐ Yes ☑ No
☐ Slab ☑ Crawl Space ☐ Basement w/plumbing ☐ Basement wo/plumbing


☑ House/Mod. Home No. Bedrooms 3
☐ Mobile Home No. Bathrooms 2
☐ Business No. Employees ____
☐ Other ____

Water Supply: ☐ Individual ☑ Public ☐ Community


Comments:/Conditions: USE ONE FLOW DIVIDER TEE TO ACHIEVE EQUAL DISTRIBUTION INTO TWO SETS OF DROP BOXES FEEDING THREE LINES EACH AS SHOWN.

Comments:/Conditions: SEPTIC TANK WITH RISERS AND MARKER INSTALLED USING "POLYLOK" FILTER

INITIAL SITE SKETCH

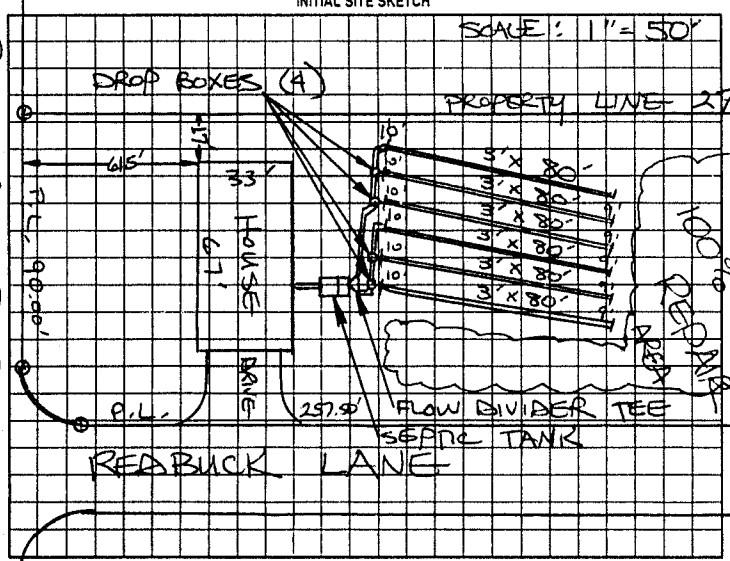

AS BUILT SKETCH

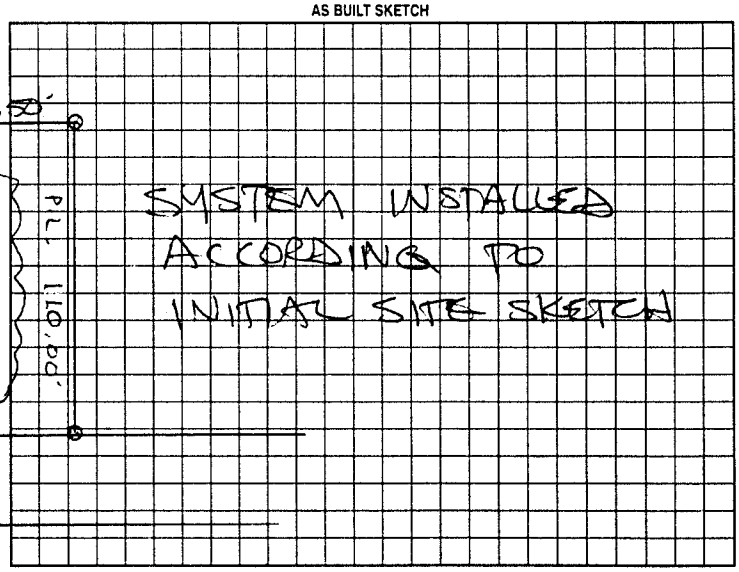

Permit can be suspended or revoked if any false information is supplied toward securing the permit/any unauthorized changes are made to the site/any unauthorized changes are made in the installation of the system. Improvement Permit with plat valid without expiration. Improvement Permit with site plan valid for sixty months. Authorization to Construct is valid for a period equal to that of Improvement Permit – not to exceed sixty months.

Signed: Jeffrey E. Whitehurst date 1-28-00 Installed by: STEVE JORDAN

Improvement Permit by: STEVE HEDRICK date 1-27-00 Operation Permit by: STEVE HEDRICK date 8-23-00

Authorization to Construct by: STEVE HEDRICK date 1-27-00 Existing System Inspection by: ____ date ____

HEALTH DEPT. COPY: WHITE OWNER COPY (FINAL): YELLOW OWNER COPY (INITIAL): PINK