IREDELL COUNTY HEALTH DEPARTMENT

THIS PERMIT VOIDS PREVIOUS ISSUED 7/21/94 FOR PO# 18769

STATESVILLE 704-878-5305 MOORESVILLE 704-664-5281

IMPROVEMENT PERMIT / CERTIFICATE OF COMPLETION / OPERATION PERMIT / EXISTING SYSTEM INSPECTION

PROPERTY DESCRIPTION NO. 070246 DATE 11-14-97 TAX MAP NO. 4726502088 Watershed: ☐ Yes ☒ No

OWNER OR CONTRACTOR JODIE STACY PHONE: Business Home 838-1699

ADDRESS 762 MOCKSVILLE HWY, STATESVILLE, NC 28625

LOCATION NC 115 N, TL SCOTTS CREEK, TL MILLER FARM, TR ANTLER, TL RED BUCK, TL MORRISON CREEK, 1ST LOT ON (R)

SUBDIVISION DEERCROFT BLOCK / SECTION III LOT 151 LOT AREA 2.5015 ACRES SITE CLASS. PS DESIGN FLOW 360 L.T.A.R. 0.20 GPD/FT²

Septic Tank: 1000 Gallons; STB 1012 Date 2-26-98

Pump Tank: _____ Gallons; PT _____ Date _____

Pump Make: _____ Model _____ Serial No. _____

Nitrification Field: No Fields 1 Square Feet 1800 Linear Feet 600

No Lines FIVE Trench Width 36" Max Trench Bottom Depth 24" Gravel Depth 12"

☒ New System ☐ Repair System Type: I, II, III, IV, V, VI

System Description: CONVENTIONAL GRAVITY

Repair System Description: LPP - SHALLOW

Maintenance Agreement Required: ☐ Yes ☒ No

☒ House/Mod. Home ☐ Mobile Home ☐ Business ☐ Other

No. Bedrooms 3 No. Bathrooms 2 No. Employees ____


☐ Slab ☒ Crawl Space ☐ Basement w/plumbing ☐ Basement wo/plumbing

Water Supply: ☐ Individual ☐ Community ☒ Public

Comments: ① CONSTRUCT SUBSURFACE INTERCEPT DRAINAGE DITCH AT LOCATION SHOWN BEGINNING 42" DEEP ② SCOUR TRENCH SIDEWALLS WHERE SMEARING OCCURS ③ INSTALL TRENCHES ON CONTOUR, NO DEEPER THAN 24"

Comments:

INITIAL SITE SKETCH

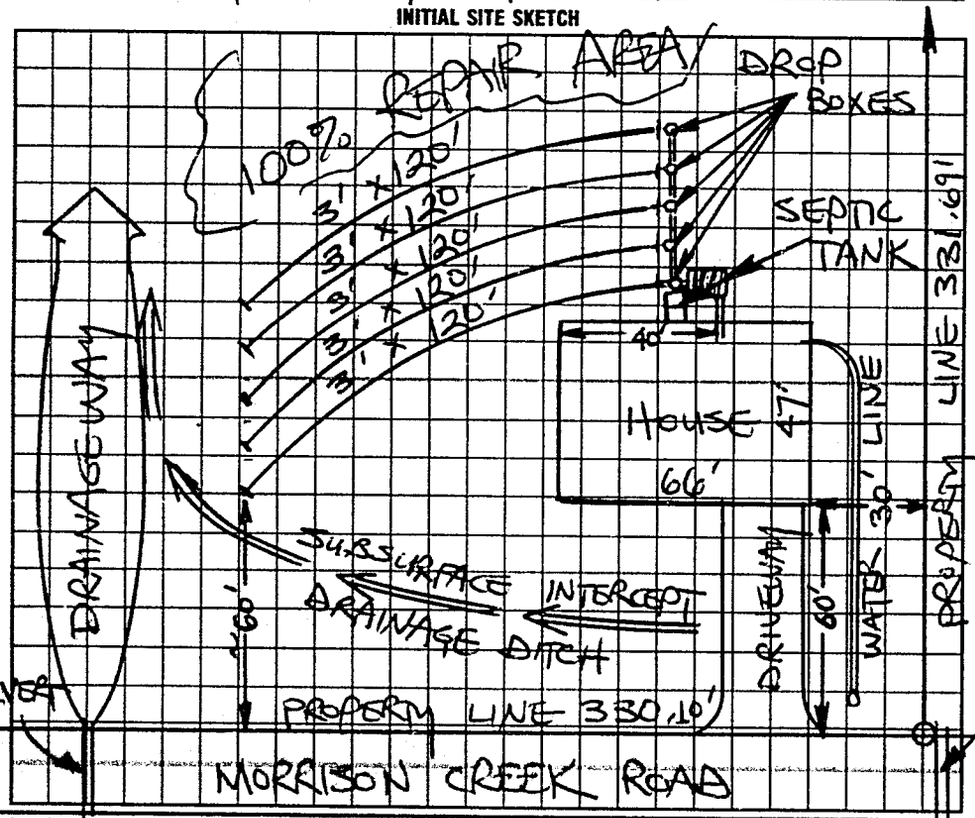

AS BUILT SKETCH

LINES INSTALLED INTO CONTOUR - FILL DIRT BROUGHT IN TO MAINTAIN MINIMUM 6" COVER

SYSTEM INSTALLED ACCORDING TO INITIAL SITE SKETCH

I understand that this permit can be suspended or revoked if any false information is supplied toward securing the permit, any unauthorized changes are made to the site/any unauthorized changes are made in the installation of the system. Improvement Permit is valid for 60 months from date of issuance. AUTHORIZATION TO CONSTRUCT IS VALID FOR 60 MONTHS FROM DATE OF ISSUANCE.

Signed: X William E. Stacy

Improvement Permit by: STEVE HEDRICK date 11-14-97

AUTH. TO CONST

Existing System Inspection by: STEVE HEDRICK date 11-14-97

Installed by: JOHNSON'S COMPLETE LANDSCAPING & YARD CARE (copy)

~~Certificate of Completion by:~~ _____ date _____

Operation Permit by: STEVE HEDRICK date 5-22-98

HEALTH DEPT. COPY: WHITE INSPECTION COPY (FINAL): GREEN OWNER COPY (FINAL): YELLOW INSPECTION COPY (INITIAL): PINK OWNER COPY (INITIAL): GOLD