IREDELL COUNTY HEALTH DEPARTMENT

STATESVILLE 704-878-5305 CI MOORESVILLE 704-664-5281

IMPROVEMENT PERMIT / AUTHORIZATION TO CONSTRUCT / OPERATION PERMIT / EXISTING SYSTEM INSPECTION

PERMIT# 105257 PIN# 4726-50-3628 DATE 3/21/02

OWNER OR CONTRACTOR Scott Rankin PHONE: Business (704) 872-4123 Home

ADDRESS 110 Ridge View Rd. Statesville, N.C. 28625

LOCATION 115 N. @ Scotts Creek Rd. @ Miller Farm Rd. @ Andy @ Red Buck @ Ridgeview

SUBDIVISION Deer Croft BLOCK / SECTION III LOT 132 LOT AREA .63 Ac. SITE CLASS P5 DESIGN FLOW 480 L.T.A.R. .30 gpd/ft²

Septic Tank: 1,000 Gallons; STB 1012 Date 11-1-95

Pump Tank: Gallons; PT Date

Pump Make: Model Serial No.

Nitrification Field: No Fields 1 Square Feet 400 Linear Feet 135

No Lines 2 Trench Width 36" Max Trench Bottom Depth 30" Gravel Depth 12"

☐ New System ☒ Repair System Type: I ⓘ III IV V VI

System Description: Conventional Gravity

Repair System Description: ~~Add 2 Lines~~ 500 gal. Rx. Tank Pump

Maintenance Agreement Required: ☐ Yes ☒ No

☒ House/Mod. Home No. Bedrooms 4

☐ Mobile Home No. Bathrooms 3

☐ Business No. Employees

☐ Other

☐ Slab ☒ Crawl Space ☐ Basement w/plumbing ☐ Basement wo/plumbing


Water Supply: ☐ Individual ☒ Public ☐ Community

Comments/Conditions: ① Keep new addition 5 Ft From Septic Tank ② Add two(2) Drop boxes + 2 lines (1 @ 80' + 1 @ 55') on Contour to existing system.


Comments/Conditions:

1" = 40'

INITIAL SITE SKETCH

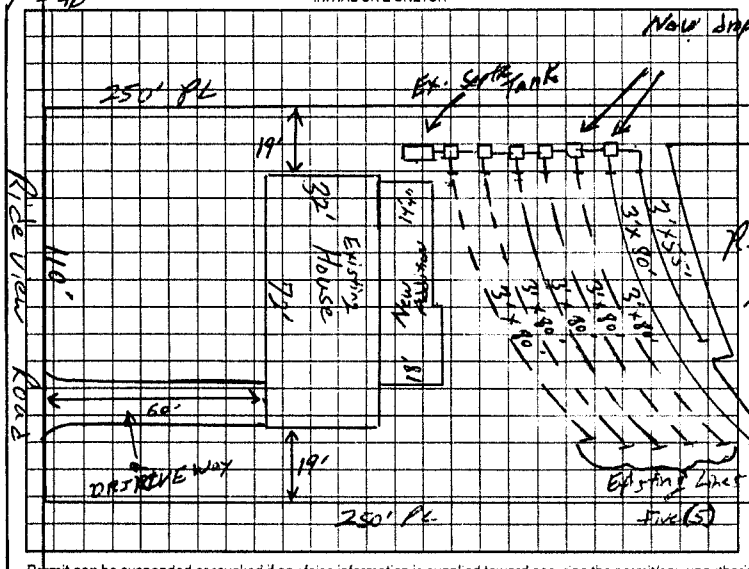

AS BUILT SKETCH

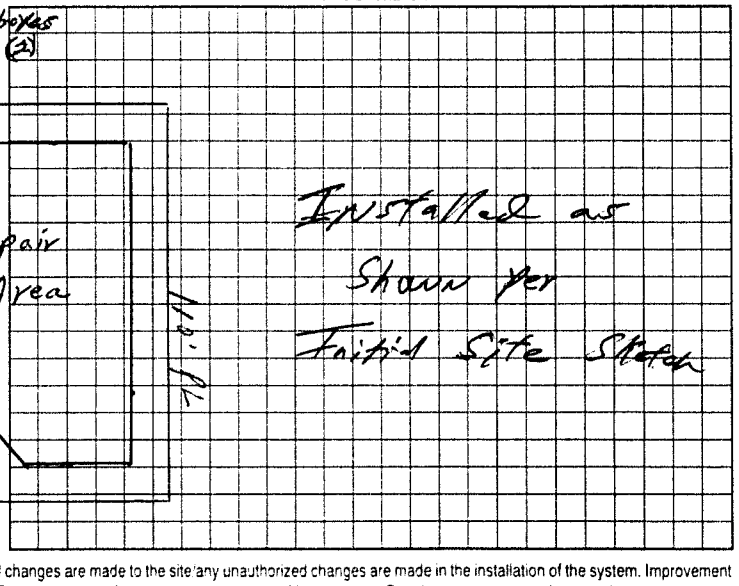

Permit can be suspended or revoked if any false information is supplied toward securing the permit/any unauthorized changes are made to the site/any unauthorized changes are made in the installation of the system. Improvement Permit with plat valid without expiration. Improvement Permit with site plan valid for sixty months. Authorization to Construct is valid for a period equal to that of Improvement Permit - not to exceed sixty months.

Signed: Scott Rankin date 3/21/02 Installed by: David Younts

Improvement Permit by: William O. Johnson date 3/21/02 Operation Permit by: William O. Johnson date 9/10/02

Authorization to Construct by: William O. Johnson date 3/21/02 Existing System Inspection by: date

HEALTH DEPT COPY: WHITE OWNER COPY (FINAL) YELLOW OWNER COPY (INITIAL) PINK