IREDELL COUNTY HEALTH DEPARTMENT

STATESVILLE 704-878-5305 MOORESVILLE 704-664-5281

IMPROVEMENT PERMIT / CERTIFICATE OF COMPLETION / OPERATION PERMIT / EXISTING SYSTEM INSPECTION

PROPERTY DESCRIPTION NO. 23248 DATE 2-29-96 TAX MAP NO. 9A-9-A-114 Watershed: ☐ Yes ☒ No

OWNER OR CONTRACTOR STEPHEN N. SMOOT PHONE: Business Home 873-0205

ADDRESS 144 ANTLER DRIVE STATESVILLE NC 28677

LOCATION NC115N TL SCOTTS CREEK, TL MILLER FARM, TR ANTLER, TL REDBUCK, TL RIDGEVIEW, 2ND LOT ON LEFT

SUBDIVISION DEERCROFT BLOCK / SECTION III LOT 114 LOT AREA 0.68 ACRE SITE CLASS. PS DESIGN FLOW 360 L.T.A.R. 0.30 GPD/FT²

Septic Tank: 1000 Gallons; STB 1012 Date 6-2-96

Pump Tank: Gallons; PT Date

Pump Make: Model Serial No.

Nitrification Field: No Fields 1 Square Feet 1200 Linear Feet 400

No Lines 4 Trench Width 36" Max Trench Bottom Depth 18-36 Gravel Depth 12"

☒ New System ☐ Repair System Type: I, II, III, IV, V, VI

System Description: CONVENTIONAL GRAVITY

Repair System Description: CONVENTIONAL GRAVITY

Maintenance Agreement Required: ☐ Yes ☒ No

☒ House/Mod. Home No. Bedrooms 3

☐ Mobile Home No. Bathrooms 2

☐ Business No. Employees

☐ Other


☐ Slab ☒ Crawl Space ☐ Basement w/plumbing ☐ Basement wo/plumbing

Water Supply: ☐ Individual ☐ Community ☒ Public


Comments: ① USE THREE FLOW DIVIDER TEES TO ACHIEVE EQUAL DISTRIBUTION INTO EACH OF FOUR 100' LINES. ② INSTALL LINES ON CONTOUR NO DEEPER THAN 36", 9' APART ON CENTERS.

Comments:

INITIAL SITE SKETCH

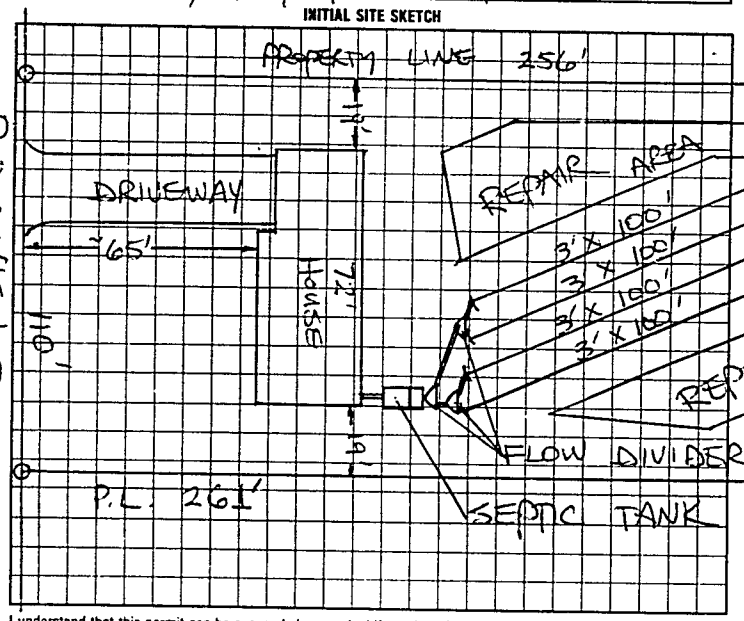

AS BUILT SKETCH

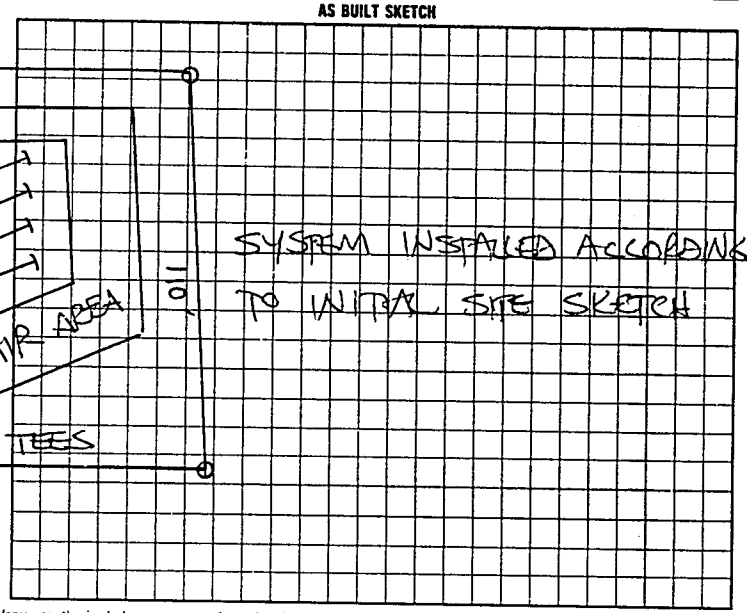

I understand that this permit can be suspended or revoked if any false information is supplied toward securing the permit/any unauthorized changes are made to the site/any unauthorized changes are made in the installation of the system. AUTHORIZATION TO CONSTRUCT IS VALID FIVE (5) YEARS FROM DATE OF ISSUANCE. IMPROVEMENT PERMIT HAS NO EXPIRATION DATE.

Signed: X/Stephen N. Smoot

Improvement Permit by: STEVE HEDRICK date 2-29-96

AUTHORIZATION TO CONSTRUCT

Existing System Inspection by: STEVE HEDRICK date 2-29-96

Installed by: DAVID YOUNTZ

~~Certificate of Completion by:~~ date

Operation Permit by STEVE HEDRICK date 8-29-96

HEALTH DEPT COPY WHITE | INSPECTION COPY (FINAL) GREEN | OWNER COPY (FINAL) YELLOW | INSPECTION COPY (INITIAL) PINK | OWNER COPY (INITIAL) GOLD