58684

IREDELL COUNTY HEALTH DEPARTMENT

STATESVILLE 704-878-5305 MOORESVILLE 704-664-5281

IMPROVEMENT PERMIT / CERTIFICATE OF COMPLETION / OPERATION PERMIT / EXISTING SYSTEM INSPECTION

PROPERTY DESCRIPTION NO. 22304 DATE 10-25-95 TAX MAP NO. 9A-9-A-136 Watershed: ☐ Yes ☑ No

OWNER OR CONTRACTOR LARRY MUNDAY BUILDERS PHONE: Business 835-2779 Home 872-6017

ADDRESS 673 SHILOH ROAD STATESVILLE, NC 28677

LOCATION NC 115 N TL SCOTTS CRK, TL MILLER FM, TR ANTLER, TL RED BUCK, TL MORRISON CREEK, 3RD ON (L)

SUBDIVISION DEERCROFT BLOCK / SECTION III LOT 136 LOT AREA 110 X 250' SITE CLASS. P3 DESIGN FLOW 360 L.T.A.R. 0.25 GPD/FT

Septic Tank: 1000 Gallons; STB 1012 Date 2-26-96

Pump Tank: _____ Gallons; PT _____ Date _____

Pump Make: _____ Model _____ Serial No. _____

Nitrification Field: No Fields 1 Square Feet 1440 Linear Feet 450

No Lines 5 Trench Width 36" Max Trench Bottom Depth 18-23" Gravel Depth 12"

☑ New System ☐ Repair System Type: I, II, III, IV, V, VI

System Description: CONVENTIONAL GRAVITY

Repair System Description: PUMP TO CHAMBERS

Maintenance Agreement Required: ☐ Yes ☑ No

☑ House/Mod. Home No. Bedrooms 3

☐ Mobile Home No. Bathrooms 2

☐ Business No. Employees _____

☐ Other _____


☐ Slab ☑ Crawl Space ☐ Basement w/plumbing ☐ Basement wo/plumbing

Water Supply: ☐ Individual ☐ Community ☑ Public

Comments: (1) KEEP SYSTEM MINIMUM 5' FROM HOUSE, 10' FROM PROPERTY LINE, 10' FROM WATER LINE (2) INSTALL LINES ON CONTOUR NO DEEPER THAN 28" 9' MINIMUM APART O.C.

Comments:

INITIAL SITE SKETCH

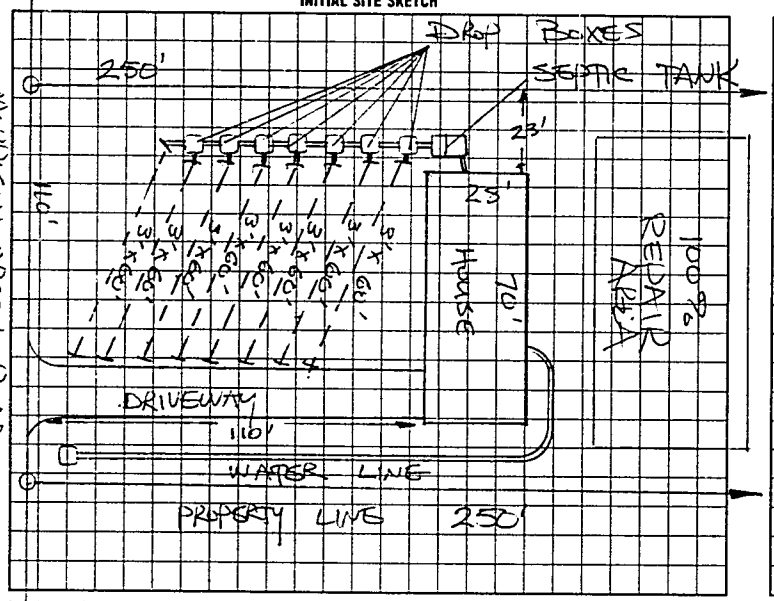

AS BUILT SKETCH

SYSTEM INSTALLED ACCORDING TO INITIAL SITE SKETCH

I understand that this permit can be suspended or revoked if any false information is supplied toward securing the permit/any unauthorized changes are made to the site/any unauthorized changes are made in the installation of the system.

AUTHORIZATION TO CONSTRUCT IS VALID FIVE (5) YEARS FROM DATE OF ISSUANCE. IMPROVEMENT PERMIT HAS NO EXPIRATION DATE.

Signed: Larry Munday

Improvement Permit by: STEVE HEDRICK date 10/25/95

~~Existing System Inspection~~ AUTHORIZATION TO CONSTRUCT by: STEVE HEDRICK date 10/25/95

Installed by: JAMES HUBLER

~~Certificate of Completion by:~~ _____ date _____

Operation Permit by: STEVE HEDRICK date 4-9-96

HEALTH DEPT COPY WHITE INSPECTION COPY (FINAL) GREEN OWNER COPY (FINAL) YELLOW INSPECTION COPY (INITIAL) PINK OWNER COPY (INITIAL) GOLD

729100