IREDELL COUNTY HEALTH DEPARTMENT

THIS PERMIT VOIDS PREVIOUS ISSUED 7/22/94

STATESVILLE 704-878-5305 MOORESVILLE 704-664-5281

IMPROVEMENT PERMIT / AUTHORIZATION TO CONSTRUCT / OPERATION PERMIT / EXISTING SYSTEM INSPECTION

PERMIT# 084456 PIN# 4726 50 5017 DATE 11-5-99

OWNER OR CONTRACTOR JOHN DARDEN BLDG. CO. PHONE: Business 663-7738 Home

ADDRESS 421 WESTCHESTER ROAD, STATESVILLE, NC 28625

LOCATION NC 115 N, TL SCOTTS CREEK, TL MILLER FARM, TR ANTLER, TL RED BUCK, TL MORRISON CREEK, 2ND LOT ON RIGHT

SUBDIVISION DEERCROFT BLOCK / SECTION III LOT 150 LOT AREA ~110x329' SITE CLASS PS DESIGN FLOW 360 L.T.A.R. 0.25 GAD/FT²

Septic Tank: 1000 Gallons; STB 1012 Date 11-2-00
Pump Tank: _____ Gallons; PT _____ Date _____
Pump Make: _____ Model _____ Serial No. _____
Nitrification Field: No Fields 1 Square Feet Eq. to 1440 Linear Feet 360+
No Lines SIX Trench Width 36" Max Trench Bottom Depth 36" ~~Gravel~~ Depth SAND 6"

☑ New System ☐ Repair System Type: I II (III) IV V VI
System Description: 25% REDUCTION SYSTEM
Repair System Description: LOW PRESSURE PIPE
Maintenance Agreement Required: ☐ Yes ☑ No
☐ Slab ☑ Crawl Space ☐ Basement w/plumbing ☐ Basement wo/plumbing

☑ House/Mod. Home No. Bedrooms 3
☐ Mobile Home No. Bathrooms 2
☐ Business No. Employees
☐ Other


Water Supply: ☐ Individual ☑ Public ☐ Community

Comments/Conditions: INSTALL 25% REDUCTION SYSTEM USING SIXTY (60) CHAMBERS IN SIX LINES AS SHOWN BELOW AS SHALLOW AS POSSIBLE (CHAMBERS AT OWNER'S REQUEST)


Comments/Conditions: SEPTIC TANK WITH MARKER INSTALLED USING "POLYLOK" FILTER

SCALE: 1"=30'

INITIAL SITE SKETCH

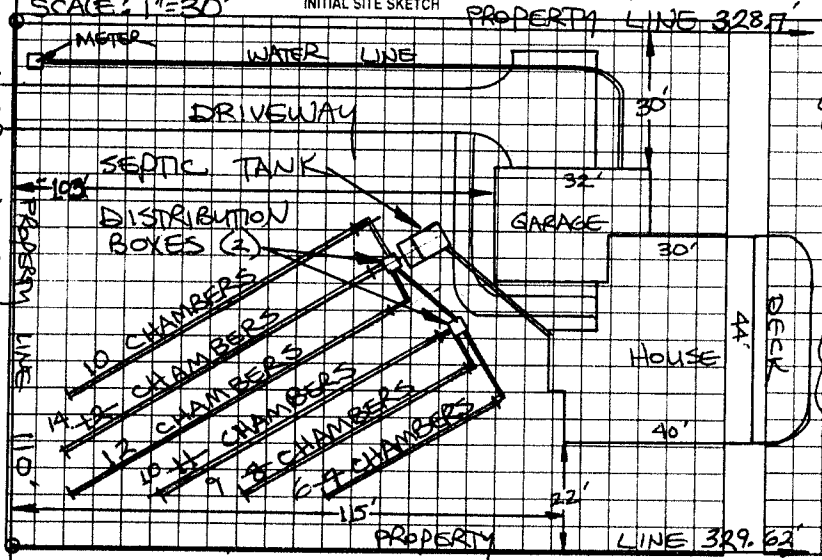

AS BUILT SKETCH

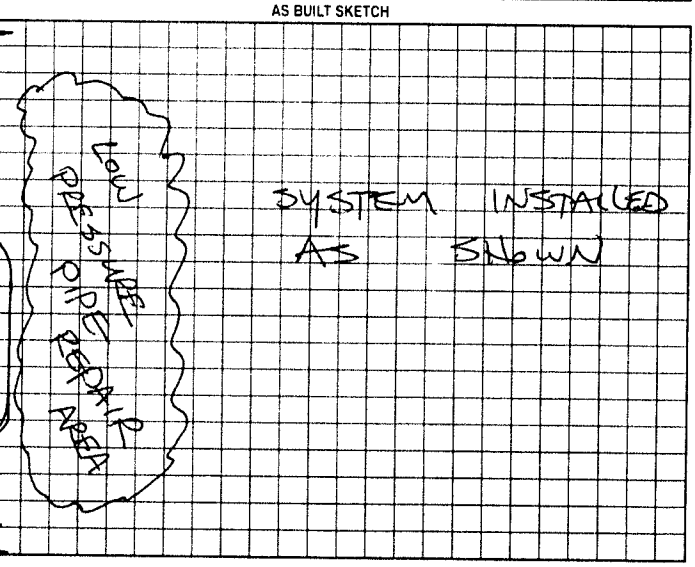

Permit can be suspended or revoked if any false information is supplied toward securing the permit/any unauthorized changes are made to the site/any unauthorized changes are made in the installation of the system. Improvement Permit with plat valid without expiration. Improvement Permit with site plan valid for sixty months. Authorization to Construct is valid for a period equal to that of Improvement Permit – not to exceed sixty months.

Signed: JC Darden date 11-10-99 Installed by: TOMMY FRYE

Improvement Permit by: STEVE HEDRICK date 11-5-99 Operation Permit by: STEVE HEDRICK date 2-1-01

Authorization to Construct by: STEVE HEDRICK date 11-5-99 Existing System Inspection by: _____ date _____

HEALTH DEPT COPY: WHITE OWNER COPY (FINAL) YELLOW OWNER COPY (INITIAL) PINK