59814

IREDELL COUNTY HEALTH DEPARTMENT

THIS PERMIT VOIDS PREVIOUS ISSUED TO GARLAND CONSTRUCTION ON 10-30-95

STATESVILLE 704-878-5305 MOORESVILLE 704-664-5281

IMPROVEMENT PERMIT / CERTIFICATE OF COMPLETION / OPERATION PERMIT / EXISTING SYSTEM INSPECTION

PROPERTY DESCRIPTION NO 22276 DATE 2-29-96 TAX MAP NO 9A-9-A-130 Watershed: Yes ✓No

OWNER OR CONTRACTOR W & W SALES PHONE: Business Home 873-3388

ADDRESS P.O. BOX 5792 STATESVILLE NC 28687

LOCATION NC 115 N, TL SCOTTS CREEK, TL MILLER FARM, TR ANTLER, TL RED BUCK, TL RIDGEVIEW, 4TH LOT ON RIGHT

SUBDIVISION DEERCROFT BLOCK / SECTION III LOT 130 LOT AREA 110' X 250' SITE CLASS PS DESIGN FLOW 360 LTAR 0.25 GPD/FT²

Septic Tank 1000 Gallons: STB 1012 Date 4-26-96
Pump Tank ____ Gallons: PT ____ Date ____
Pump Make ____ Model ____ Serial No ____
Nitrification Field: No Fields 1 Square Feet 1440 Linear Feet 480
No Lines 6 Trench Width 36" Max Trench Bottom Depth 18-30" Gravel Depth 12"

✓New System Repair System Type I II III IV V
System Description: CONVENTIONAL GRAVITY
Repair System Description: CHAMBERED GRAVITY
Maintenance Agreement Required Yes No


✓House/Mod Home No Bedrooms 3
Mobile Home No Bathrooms 2
Business No Employees ____
Other ____
Slab ✓Crawl Space Basement w/plumbing Basement wo/plumbing

Water Supply: Individual, Community, ✓Public

Comments: ① INSTALL SUBSURFACE INTERCEPT DRAINAGE DITCH AS SHOWN BEGINNING 4.2" DEEP AT LOCATION SHOWN & CONTINUING OUT TO DAYLIGHT ② KEEP SYSTEM MINIMUM 10' FROM DRAINAGE DITCH & 10' FROM PROPERTY LINE.

Comments: REALLY GOOD JOB!

INITIAL SITE SKETCH

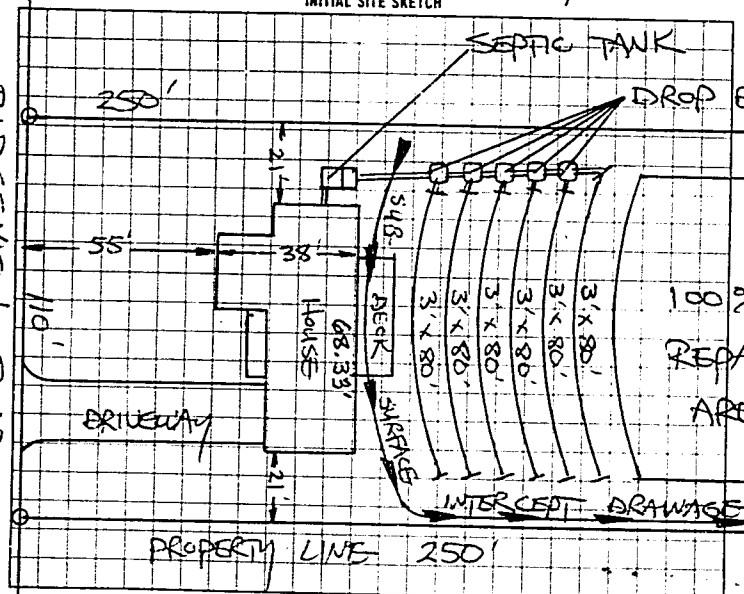

AS BUILT SKETCH

SYSTEM INSTALLED ACCORDING TO INITAL SITE SKETCH

I understand that this permit can be suspended or revoked if any false information is supplied toward securing the permit, any unauthorized changes are made to the site/any unauthorized changes are made in the installation of the system. AUTHORIZATION TO CONSTRUCT IS VALID FIVE (5) YEARS FROM DATE OF ISSUANCE. IMPROVEMENT PERMIT HAS NO EXPIRATION DATE

Signed Bonnie Wilson

Improvement Permit by STEVE HEDRICK date 2-29-96

~~AUTHORIZATION TO CONSTRUCT~~ Existing System Inspection by STEVE HEDRICK date 2-29-96

Installed by TOMMY FRYE date ____

~~Certificate of Completion by~~ STEVE HEDRICK date 7-9-96

Operation Permit by ____ date ____

HEALTH DEPT COPY WHITE | INSPECTION COPY (FINAL) GREEN | OWNER COPY (FINAL) YELLOW | INSPECTION COPY (INITIAL) PINK | OWNER COPY (INITIAL) GOLD

199200