IREDELL COUNTY HEALTH DEPARTMENT

56985 or 58380 10:30

STATESVILLE 704-878-5305 MOORESVILLE 704-664-5281

IMPROVEMENT PERMIT / CERTIFICATE OF COMPLETION / OPERATION PERMIT / EXISTING SYSTEM INSPECTION


OWNER OR CONTRACTOR W+W Sales Inc PHONE: Business 873-3388 Home

ADDRESS PO BOX 5792 Statesville 28687

LOCATION NC 115 TL Scotts Creek TL Miller Fm TR Antler TL Redbuck TL Ridgeview 4th on left

SUBDIVISION Deercrest BLOCK / SECTION LOT 116 LOT AREA 110' X 272' SITE CLASS. PS DESIGN FLOW 360 L.T.A.R. .33

Septic Tank: 1000 Gallons; STB 1013 Date 11/4/95

Pump Tank: Gallons; PT Date

Pump Make: Model Serial No.

Nitrification Field: No Fields 1 Square Feet 810 Linear Feet 270

No Lines 3 Trench Width 36" Max Trench Bottom Depth 36" Gravel Depth N/A

☑ New System ☐ Repair System Type: I, II, III, IV, V, VI

System Description: Gravity/Chambered Gravelless

Repair System Description: Pump to ll ll

Maintenance Agreement Required: ☐ Yes ☑ No

☐ Slab ☑ Crawl Space ☐ Basement w/plumbing ☐ Basement wo/plumbing

☑ House/Mod. Home No. Bedrooms 3

☐ Mobile Home No. Bathrooms 2

☐ Business No. Employees

☐ Other

Water Supply: ☐ Individual ☐ Community ☑ Public


Comments:

Line amount Equal to 360'
Conventional Line


Comments:

Soil test leave Earthen Dam

INITIAL SITE SKETCH

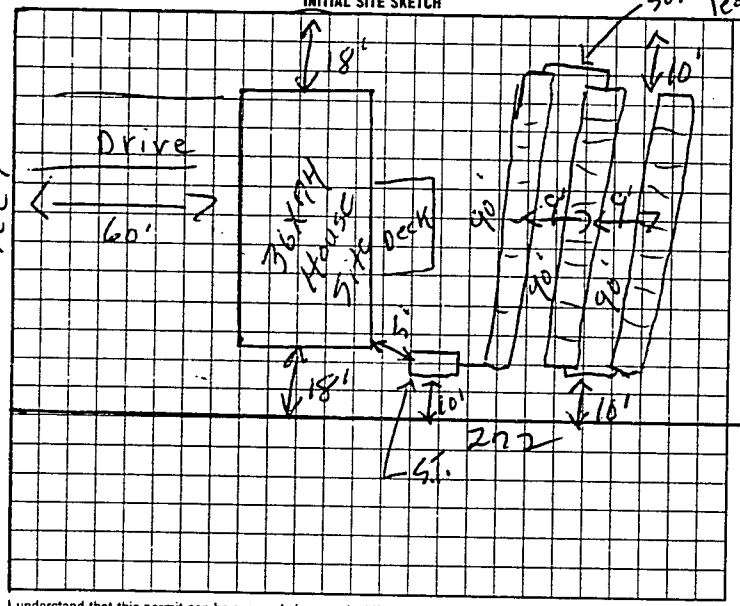

AS BUILT SKETCH

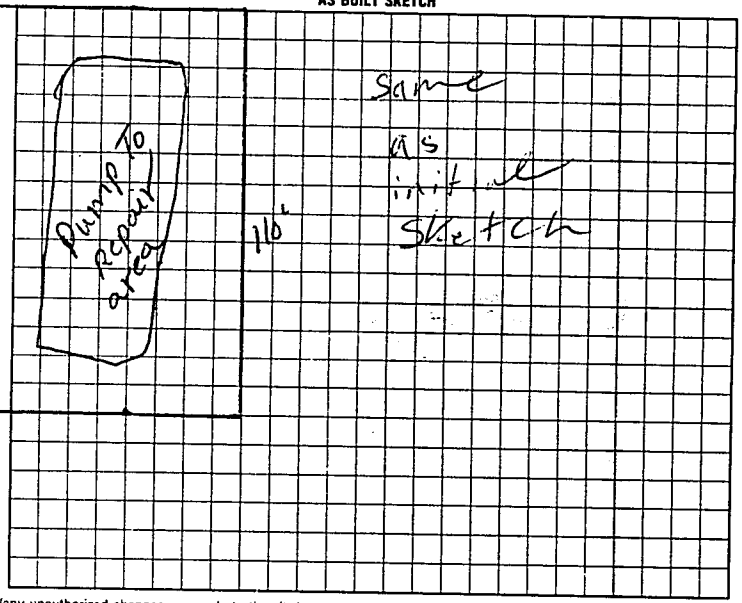

I understand that this permit can be suspended or revoked if any false information is supplied toward securing the permit/any unauthorized changes are made to the site/any unauthorized changes are made in the installation of the system.

Signed: X Ben Wilson

Improvement Permit by: J.C. Moore date 10-25-95

Authorization to Construct by: J.C. Moore date 10-25-95

Installed by: Tommy Cothren J.C. Moore

Certificate of Completion by: date

Operation Permit by: Bidy Freeman date 2/16/96

TO CONTRACTOR DEPT. COPY WHITE INSPECTION COPY (FINAL) GREEN OWNER COPY (FINAL) YELLOW INSPECTION COPY (INITIAL) PINK OWNER COPY (INITIAL) GOLD

Authorization to Const. Expires 6 mos from date of issue

6 2 9 2 0 0