56985 or 58380 10:30

IREDELL COUNTY HEALTH DEPARTMENT

STATESVILLE 704-878-5305 MOORESVILLE 704-664-5281

IMPROVEMENT PERMIT / CERTIFICATE OF COMPLETION / OPERATION PERMIT / EXISTING SYSTEM INSPECTIO

PROPERTY DESCRIPTION NO. 22345 DATE 10-25-95 TAX MAP NO. 9A-7-A-116 Watershed: ☐ Yes

OWNER OR CONTRACTOR W + W Sales Inc PHONE: Business 873-3388 Home

ADDRESS PO Box 5792 Statesville 28687

LOCATION NC 115 TL Scot's Creek TL Miller Fm TR Antler TL Redbuck TL Ridgeview ...

SUBDIVISION Deercroft LOT 116 LOT AREA 110' X 272' SITE CLASS. PS DESIGN FLOW 360 L.T.A.R. .33

Septic Tank 1000 Date 11/1/95

Pump Tank Date

Pump Make

Nitrification Field No. 1 810 270

No Lines 3 36 36

☑ New System ☐ Repair System Type: I, II, (III), IV, V, VI

System Description: Gravel/Chambered/Gravelless

Repair System Description: Pump TK

Maintenance Agreement Required: ☐ Yes ☑ No

Gravel Depth N/A ☐ Slab ☑ Crawl Space ☐ Basement w/plumbing ☐ Basement wo/plumbing

☑ House/Mod. Home No. Bedrooms 3

☐ Mobile Home No. Bathrooms 2

☐ Business No. Employees

☐ Other


Water Supply: ☐ Individual ☐ Community ☑ Public

Comments: Line amount Equal to 360' Conventional Line

Comments:

INITIAL SITE SKETCH

AS BUILT SKETCH

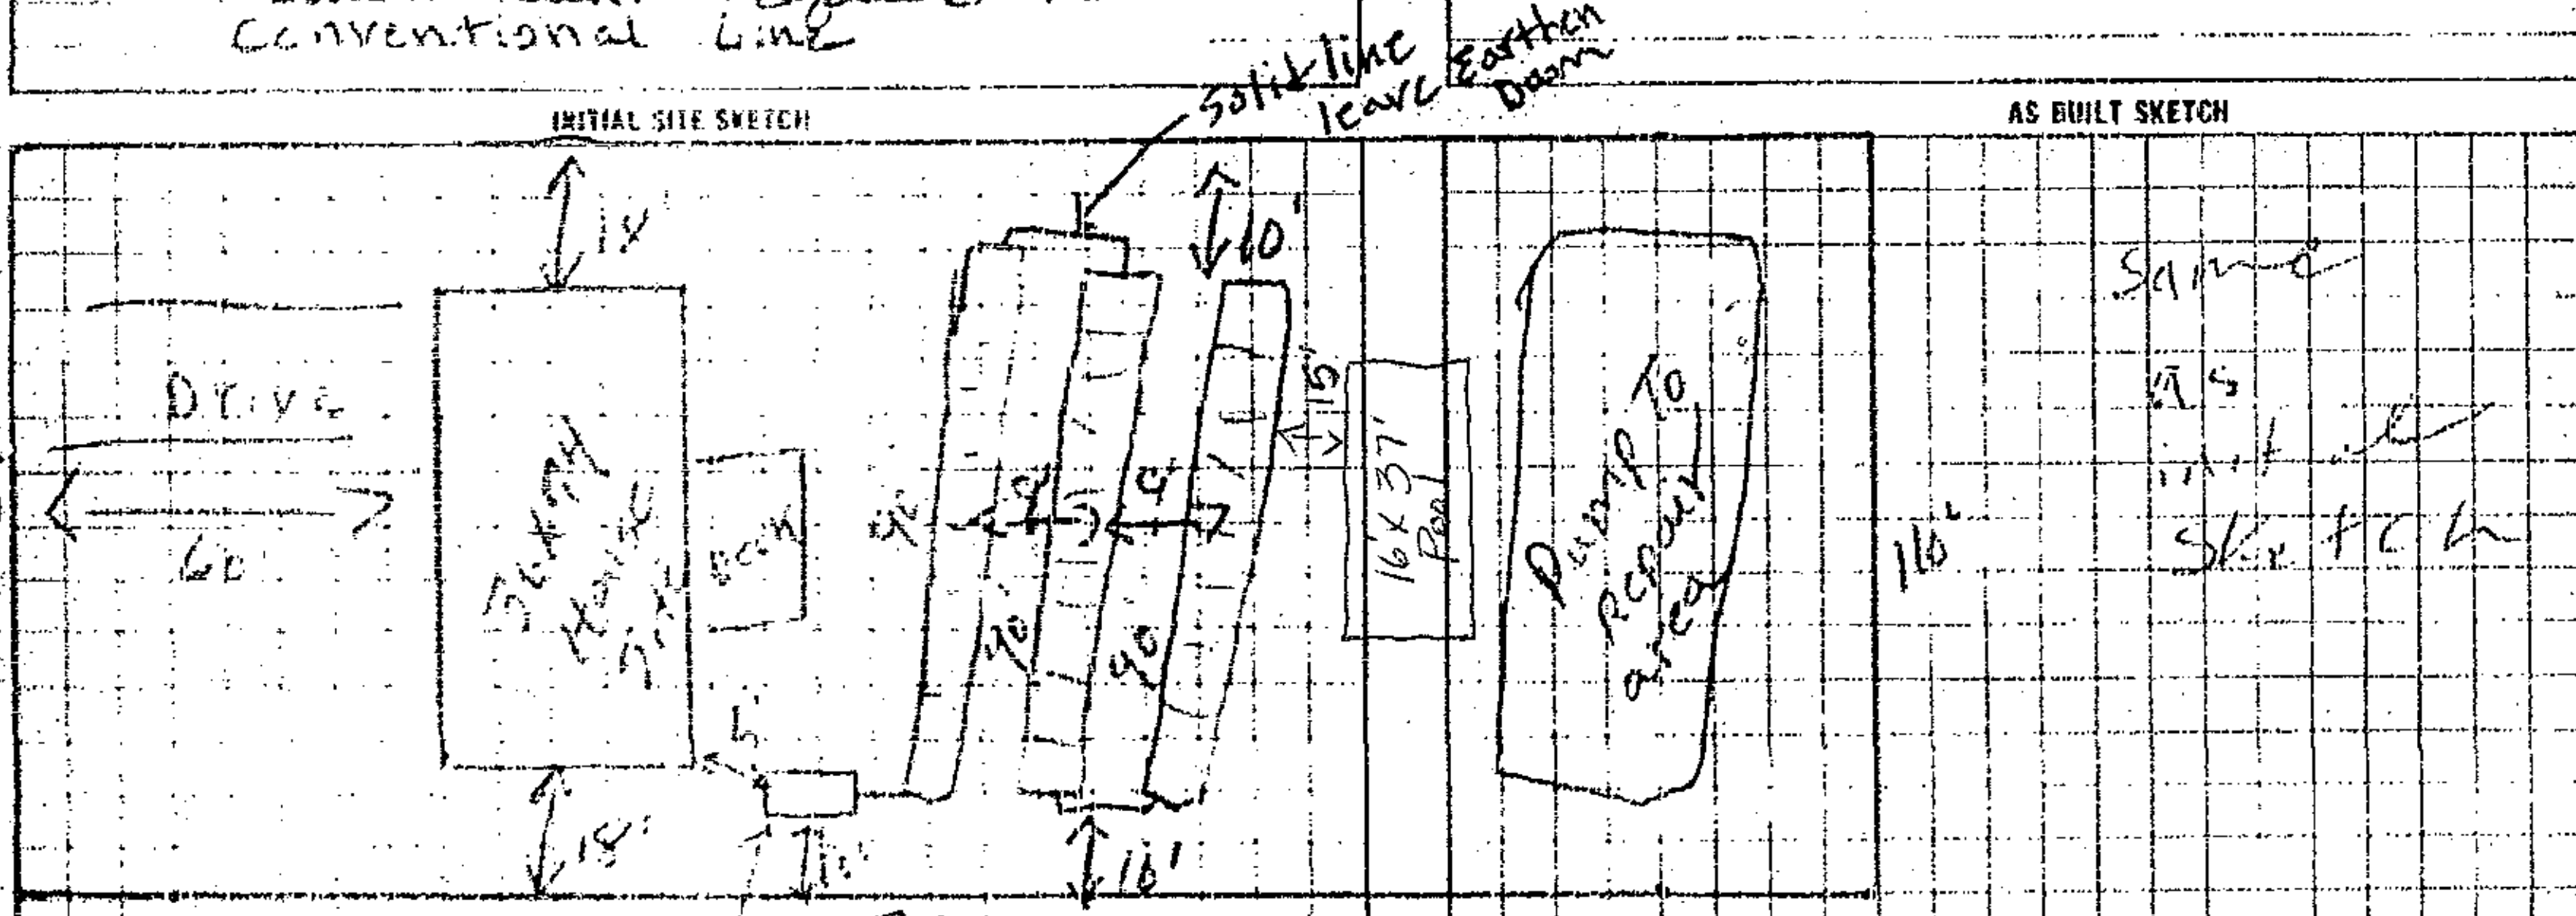

The proposed pool addition does not appear to impact the existing septic system.

**NOTE:

Date: 18 MAY 10 R.S.

ICHD-Environmental Health Division

I understand that this permit can be suspended or revoked if ... information supplied toward securing the permit/any unauthorized changes are made to the site/any unauthorized changes are made in the installation of the system

Signed X

Installed by Tommy ... J. C. Moore

Improvement Permit by J. C. Moore date 10-25-95

Certificate of Completion by: date

Authorization ~~Existing System Inspection~~ J. C. Moore date 10-25-95

Operation Permit by: date 2/16/9.

TO C ... COPY WHITE ... OWNER COPY (FINAL) YELLOW INSPECTION COPY (INITIAL) PINK OWNER COPY (INITIAL) GOL...

Authorization to const. Expires 6 mos from date of issue

JAN. 2, 1989 6:24