55961

IREDELL COUNTY HEALTH DEPARTMENT

STATESVILLE 704-878-5305 MOORESVILLE 704-664-5281

IMPROVEMENT PERMIT / CERTIFICATE OF COMPLETION / OPERATION PERMIT / EXISTING SYSTEM INSPECTION

PROPERTY DESCRIPTION NO. 21150 DATE 5/17/95 TAX MAP NO. 9A-9-A-138 Watershed: ☐ Yes ☒ No

OWNER OR CONTRACTOR G & G BUILDERS PHONE: Business Home 871-7195

ADDRESS 184 SERENITY DR, MOCKSVILLE, NC 27028

LOCATION NC115N, TL SCOTTS CREEK, TL MILLER FARM, TR ANTLER, TL RED BUCK, TL MORRISON CREEK, 5TH LOT ON LEFT

SUBDIVISION DEERCROFT BLOCK / SECTION III LOT 138 LOT AREA 110 x 250' SITE CLASS P3 DESIGN FLOW 360 L.T.A.R. 0.25 GPD/SF

Septic Tank: 1000 Gallons; STB 1012 Date 4-29-95

Pump Tank: ____ Gallons; PT ____ Date ____

Pump Make: ____ Model ____ Serial No. 360

Nitrification Field: No Fields 1 Square Feet 1440 Linear Feet 480

No Lines 8 6 Trench Width 36" Max Trench Bottom Depth 18-36" Gravel Depth N/A

☑ New System ☐ Repair System Type: I, ☐ II, IV, V, VI

System Description: CONVENTIONAL GRAVITY

Repair System Description: CONV. PUMP

Maintenance Agreement Required: ☐ Yes ☑ No

☐ House/Mod. Home No. Bedrooms 3

☐ Mobile Home No. Bathrooms 2

☐ Business No. Employees ____

☐ Other ____


☐ Slab ☑ Crawl Space ☐ Basement w/plumbing ☐ Basement wo/plumbing

Water Supply: ☐ Individual ☐ Community ☑ Public


Comments:

Comments: SYSTEM CHANGED TO TYPE II CHAMBERS (360 L.F. — 60 CHAMBERS) AT OWNER'S REQUEST.

INITIAL SITE SKETCH

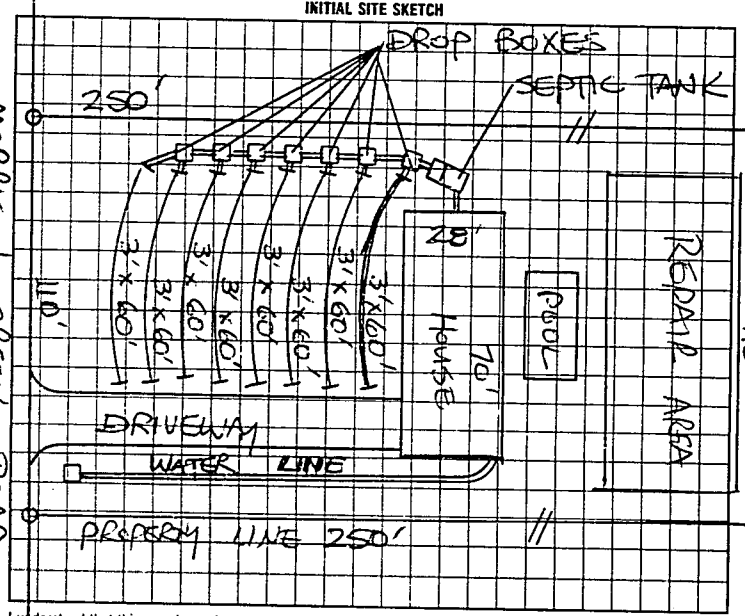

AS BUILT SKETCH

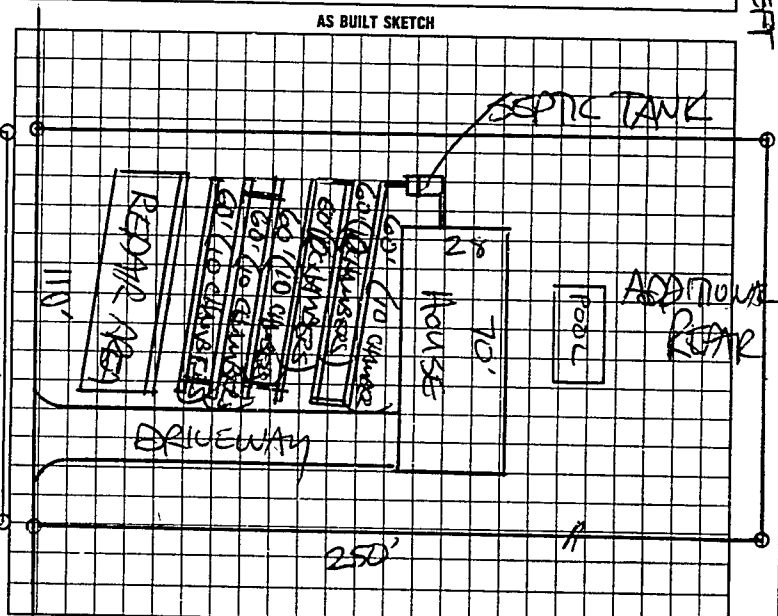

I understand that this permit can be suspended or revoked if any false information is supplied toward securing the permit/any unauthorized changes are made to the site/any unauthorized changes are made in the installation of the system. Improvement Permit is valid for 60 months from date of issuance.

Signed: Mike Gunter

Improvement Permit by: STEVE HEDRICK date 5/17/95

Existing System Inspection by: ____ date ____

Installed by: DAVID YOUNTZ

Certificate of Completion by: STEVE HEDRICK date 8-9-95

Operation Permit by: ____ date ____

HEALTH DEPT. COPY: WHITE INSPECTION COPY (FINAL): GREEN OWNER COPY (FINAL): YELLOW INSPECTION COPY (INITIAL): PINK OWNER COPY (INITIAL): GOLD

L 8 2 0 0 0