54573

IREDELL COUNTY HEALTH DEPARTMENT

STATESVILLE 704-878-5305 MOORESVILLE 704-664-5281

IMPROVEMENT PERMIT / CERTIFICATE OF COMPLETION / OPERATION PERMIT / EXISTING SYSTEM INSPECTION

PROPERTY DESCRIPTION NO. 20338 DATE 2/20/95 TAX MAP NO. 9A-9-A-129 Watershed: ☐ Yes ☐ No

OWNER OR CONTRACTOR JEFFREY W. MOORE PHONE: Business _____ Home 873-0978

ADDRESS 217 SAIN ROAD STATESVILLE NC 28677

LOCATION NC 115, TL SCOTTS CREEK, TL MILLER FARM TR ANTLER, TL RED BUCK, TL RIDGEVIEW, LOT (R)

SUBDIVISION DEERCROFT BLOCK / SECTION III LOT 129 LOT AREA 110X'250' SITE CLASS. PS DESIGN FLOW 360 L.T.A.R. 0.3 GPD/FT²

Septic Tank: 1000 Gallons; STB 794 Date 3/1/95

Pump Tank: _____ Gallons; PT _____ Date _____

Pump Make: _____ Model _____ Serial No. _____

Nitrification Field: No Fields 1 Square Feet 1200 Linear Feet 400

No Lines 5 Trench Width 36" Max Trench Bottom Depth 36 Gravel Depth 12"

☑ New System ☐ Repair System Type: I, II, III, IV, V, VI

System Description: CONV. GRAVITY

Repair System Description: CONV. GRAVITY

Maintenance Agreement Required: ☐ Yes ☑ No

☐ Slab ☑ Crawl Space ☐ Basement w/plumbing ☐ Basement wo/plumbing

☑ House/Mod. Home No. Bedrooms 3

☐ Mobile Home No. Bathrooms 2

☐ Business No. Employees _____


☐ Other _____

Water Supply: ☐ Individual ☐ Community ☑ Public


Comments:

Comments:

INITIAL SITE SKETCH

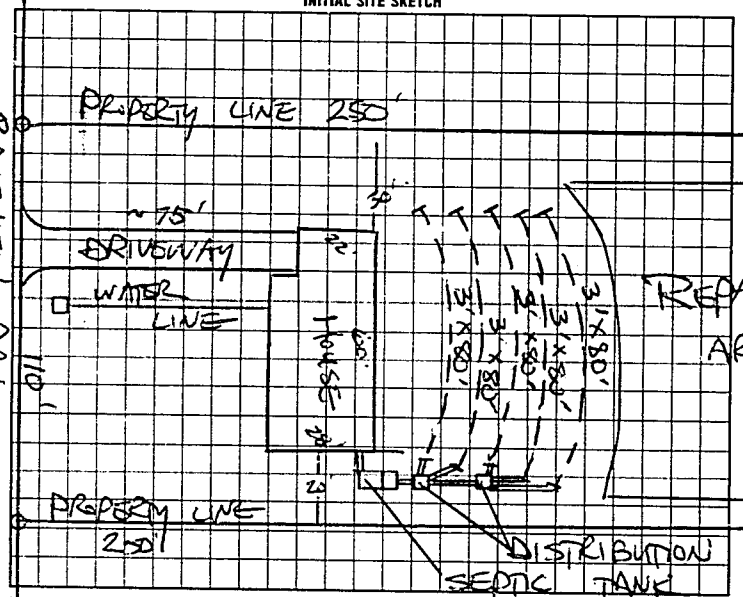

AS BUILT SKETCH

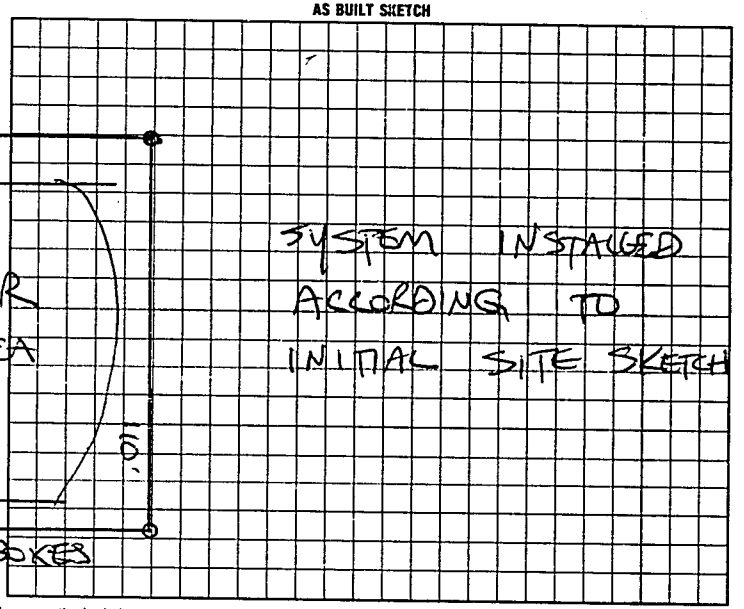

RIDGEVIEW DRIVE

I understand that this permit can be suspended or revoked if any false information is supplied toward securing the permit/any unauthorized changes are made to the site/any unauthorized changes are made in the installation of the system. Improvement Permit is valid for 60 months from date of issuance

Signed. X Tim Summers

Improvement Permit by: STEVE HEDRICK date 2/20/95

Existing System Inspection by: _____ date _____

Installed by: JAMES HUDLER

Certificate of Completion by: STEVE HEDRICK date 5/15/95

Operation Permit by: _____ date _____

HEALTH DEPT COPY WHITE INSPECTION COPY (FINAL) GREEN OWNER COPY (FINAL) YELLOW INSPECTION COPY (INITIAL) PINK OWNER COPY (INITIAL) GOLD