C1

IREDELL COUNTY HEALTH DEPARTMENT

STATESVILLE 704-878-5305 MOORESVILLE 704-664-5281

IMPROVEMENT PERMIT / AUTHORIZATION TO CONSTRUCT / OPERATION PERMIT / EXISTING SYSTEM INSPECTION

PERMIT# 145650 PIN# 4726-50-7036 DATE 17 October 07

OWNER OR APPLICANT R. Wood Construction, Inc. PHONE: Business (704) 924-8635 Home

ADDRESS 111 Knollcrest Lane Statesville, N.C.

LOCATION Scotts Creek Rd. Th Miller Farm Rd TR Nutter - End of Road - Th / TL Morrison Creek Rd. / site on Rt.

SUBDIVISION Deercroft BLOCK / SECTION 3 LOT 148 LOT AREA SITE CLASS. DESIGN FLOW L.T.A.R.

Septic Tank: 1000 g Gallons: STB 325-1000 Date 17-18-07

Pump Tank: 1000 g Gallons: PT 302 Date 11-19-07

Pump Make: Zoeller Model m152 Serial No.

Nitrification Field: No Fields 1 Square Feet = 1200 Linear Feet 300'

No Lines 4 Trench Width 36" Max Trench Bottom Depth 36" Gravel Depth

☑ New System ☐ Repair ☐ Expansion System Type: I II III IV V VI

System Description: 25% Reduction System

Repair System Description: 50% Reduction

Maintenance Agreement Required ☐ Yes ☑ No

☑ House/Mod. Home ☐ Mobile Home ☐ Business ☐ Other

No. Bedrooms 3 No. Persons No. Employees

Water Supply: ☐ Individual ☐ Public ☑ Community

☑ Gravity ☑ Pressure ☐ Slab ☑ Crawl Space ☐ Basement w/plumbing ☐ Basement wo/plumbing

Comments:/Conditions:

Follow contour / See Attached pump specs.

Comments:/Conditions: Filter install

INITIAL SITE SKETCH

Please Find Attached Layout.

Pump Specs. Stated Approximate - will need exact elevations to determine.

AS BUILT SKETCH

Install As Drawn

Permit can be suspended or revoked if any false information is supplied toward securing the permit/any unauthorized changes are made to the site/any unauthorized changes are made in the installation of the system. Improvement Permit with plat valid without expiration ☐ Improvement Permit with site plan valid for sixty months ☑ Authorization to Construct is valid for a period equal to that of Improvement Permit – not to exceed sixty months.

Signed: date 10/25/07

Improvement Permit by: R.S. date 17 Oct. 07

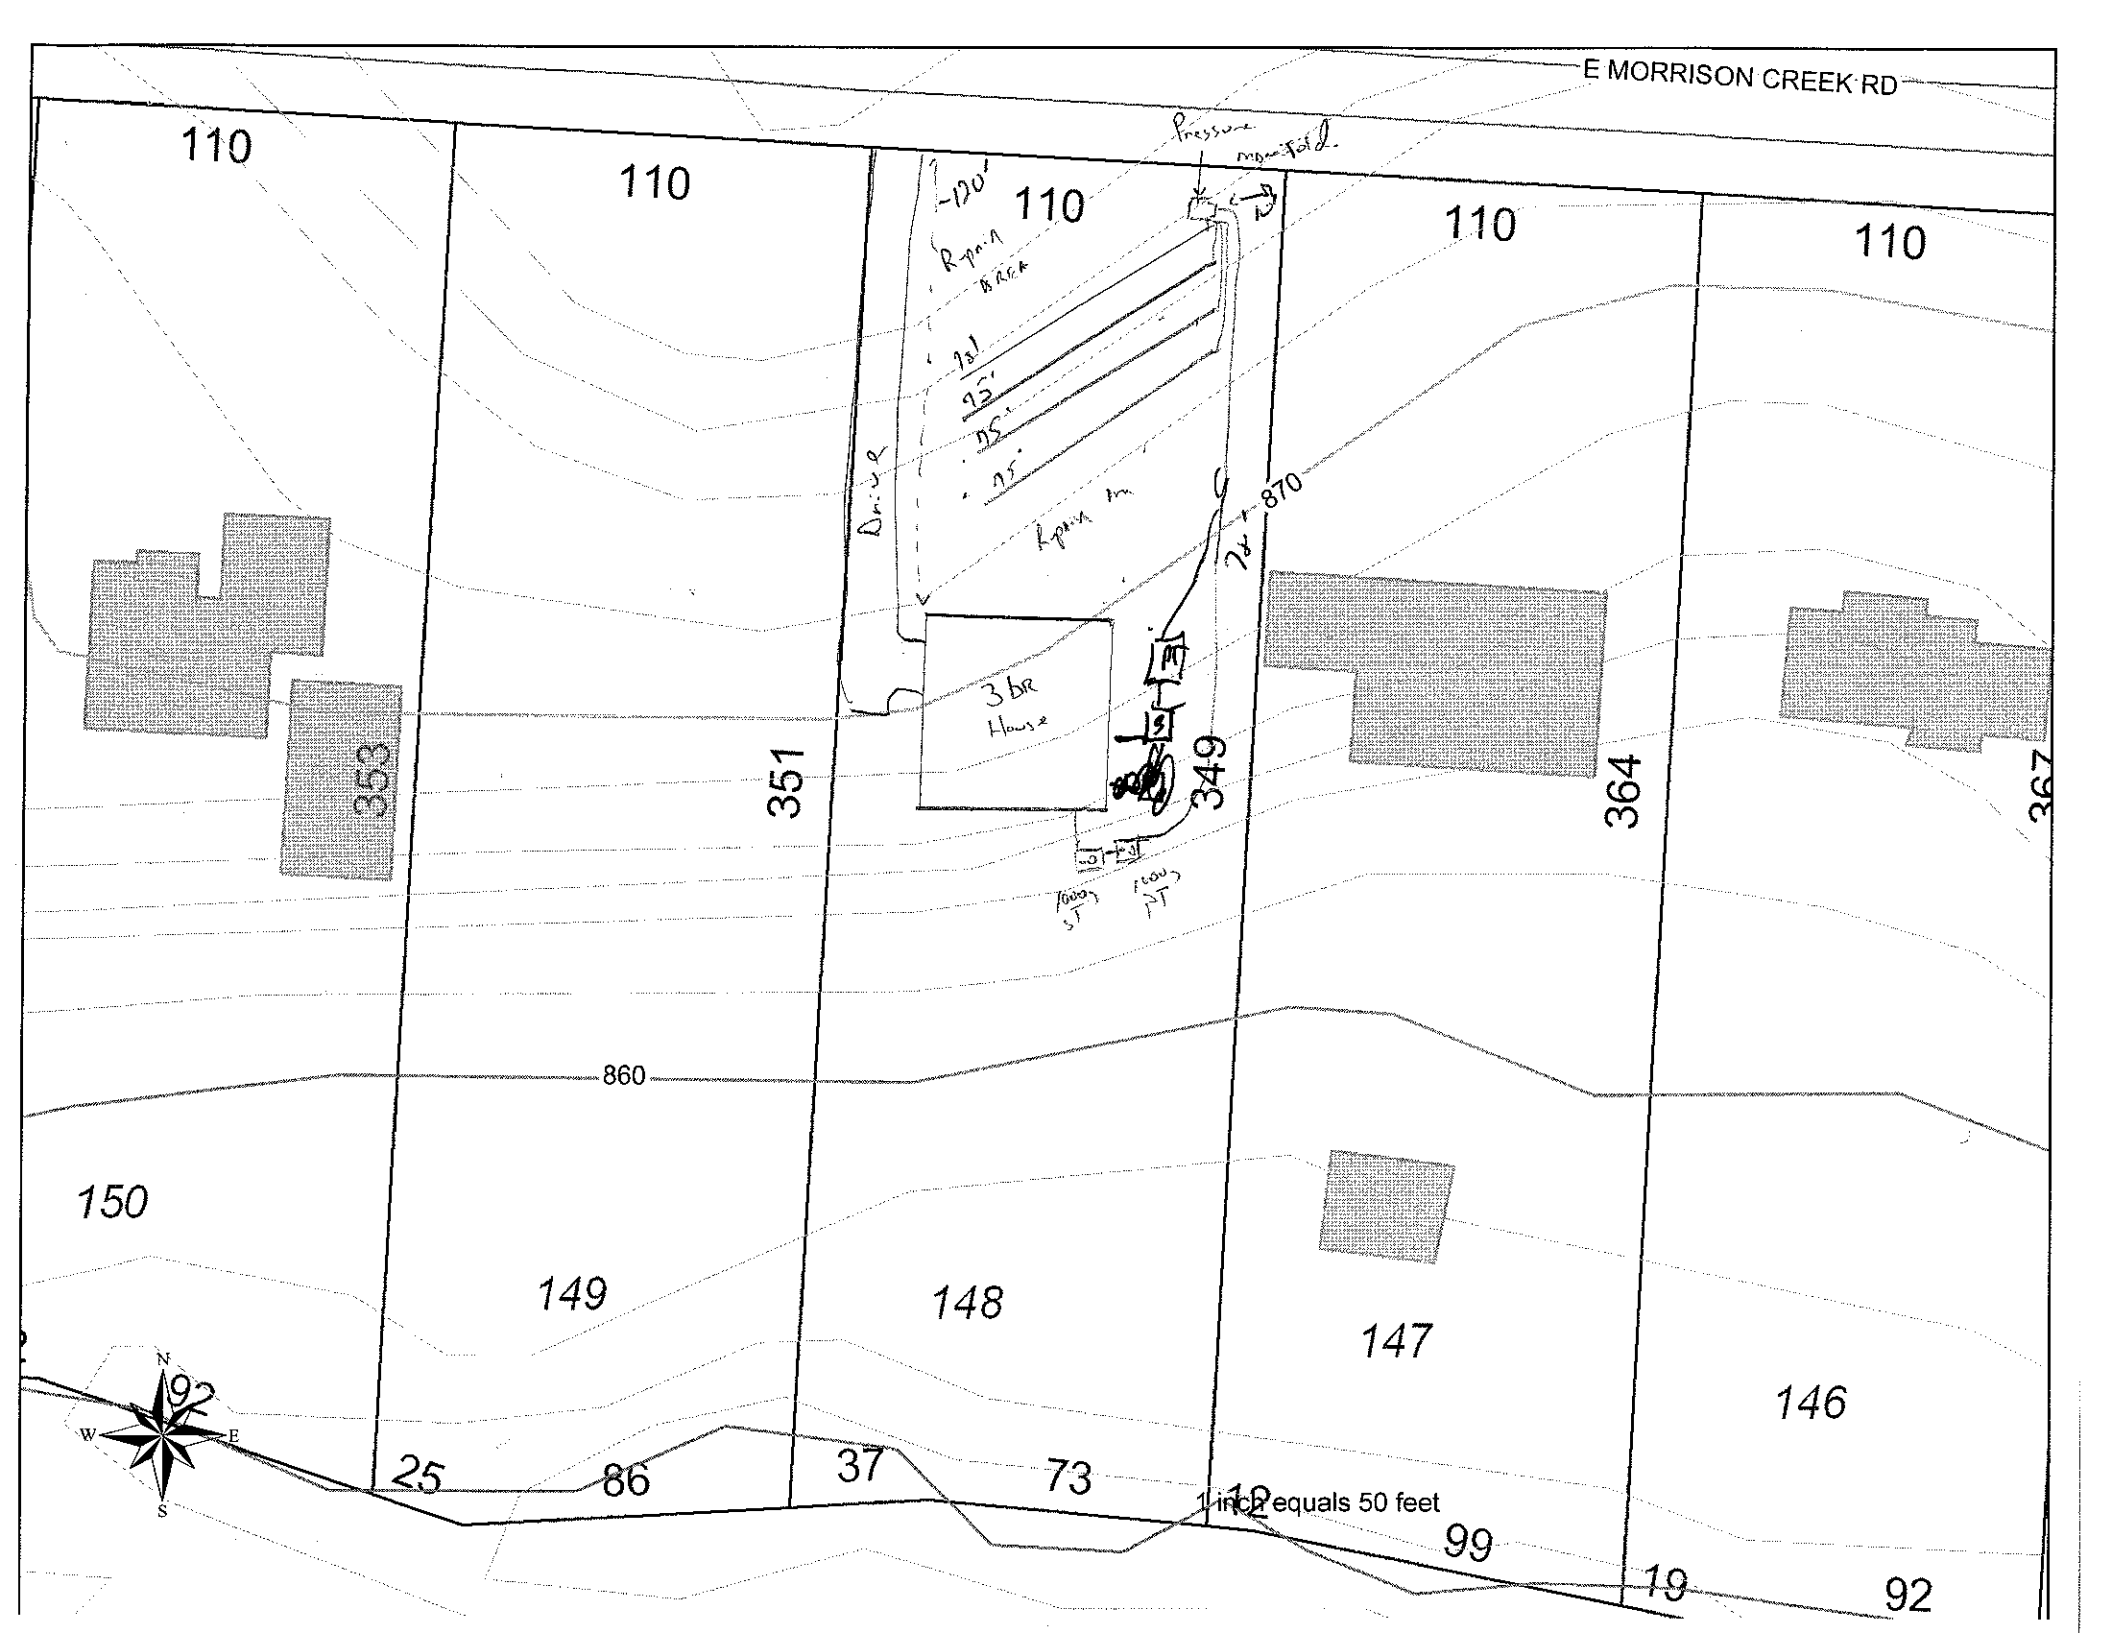
Authorization to Construct by: R.S. date 17 Oct. 07

Installed by: Rowan

Operation Permit by: R.S. date 13 Mar. 08

Existing System Inspection by: date

HEALTH DEPT. COPY: WHITE OWNER COPY (FINAL): YELLOW OWNER COPY (INITIAL): PINK


E MORRISON CREEK RD
110
110
110
110
110
Pressure manifold
120'
Rpwm
BRICK
75'
75'
75'
75'
Rpwm
Drive
870
3 bR House
353
351
349
364
367
860
150
149
148
147
146
92
25
86
37
73
12
99
19
92
N
W
E
S
1 inch equals 50 feet