IREDELL COUNTY HEALTH DEPARTMENT

Statesville Office (704) 878-5305 Mooresville Office (704) 660-3625 PERMIT # 21830 1

IMPROVEMENT PERMIT / AUTHORIZATION TO CONSTRUCT / OPERATION PERMIT / EXISTING SYSTEM

PIN # 4726507359

APPLICANT: Dale Gryder APPLICANT ADDRESS: 2940 S. Chipley Ford Rd

SITE ADDRESS: 129 E Morrison Creek Rd PHONE: 704-876-5656 ALT. PHONE: 704-796-6157

SITE DIRECTIONS: Miller Farm Rd Turn on Arter to Red Buck to E. Morrison Creek Rd

SUBDIVISION: Deercroft SECTION: 53 LOT # 139 LOT AREA: 0.63ac DESIGN FLOW: Ex L.T.A.R.: Ex


Septic Tank	1000 (gal)	STB	10@12	Date	3-2-16	☐ New System	☑ Repair	☐ Expansion	System Type: I ☐ II ☐ III IV V VI
Pump Tank	N/A (gal)	PT	N/A	Date	N/A	System Description:	Tank		
Pump Make	N/A	Model	N/A	Serial #	EF-4	Repair System Description:			
# Nitrification Fields	Ex	# Lines	Ex	Linear Ft:	Ex	Maintenance Agreement Required:	☐ YES	☑ NO	
Trench Width	Ex	Max. Trench Bottom Depth	Ex	Gravel Depth	Ex	☒ GRAVITY	☐ PRESSURE		

☒ Residence No. Bedrooms Ex ☐ Business No. Persons Ex ☐ Other No. Employees ☐ Slab ☒ Crawl Space ☐ Basement w/plumbing ☐ Basement w/o plumbing


Water Supply: ☐ Private ☒ Public ☐ Community

Comments / Conditions:

INITIAL SITE SKETCH

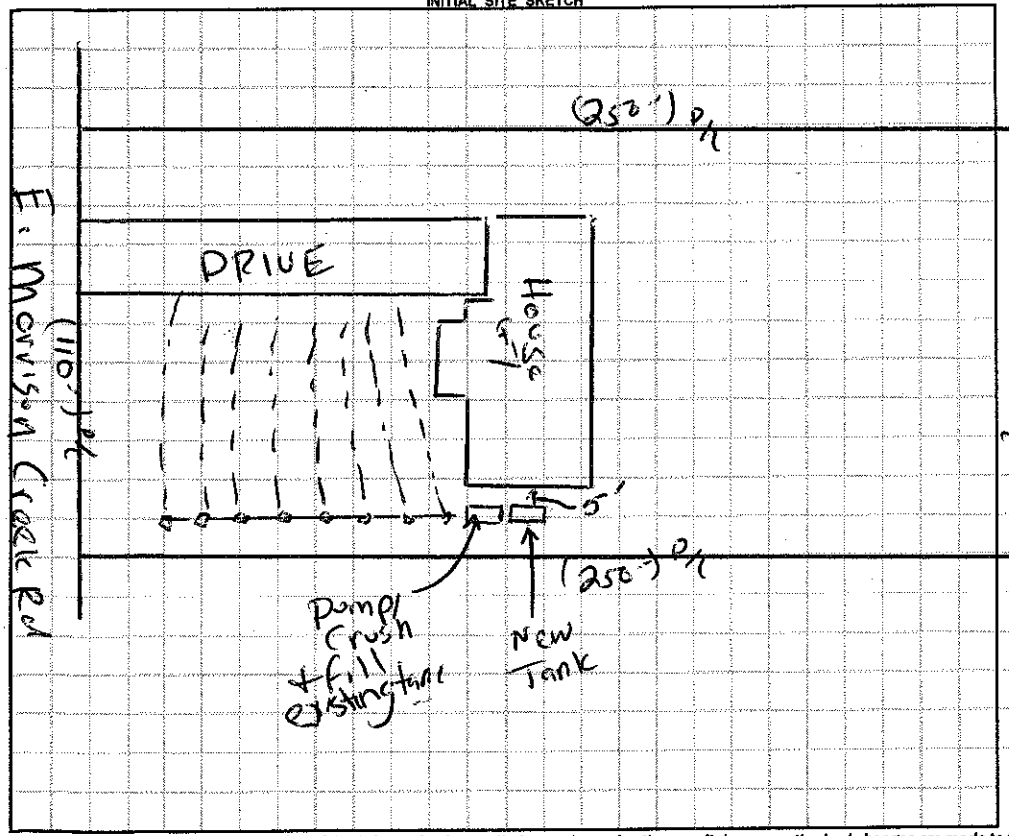

AS BUILT SKETCH

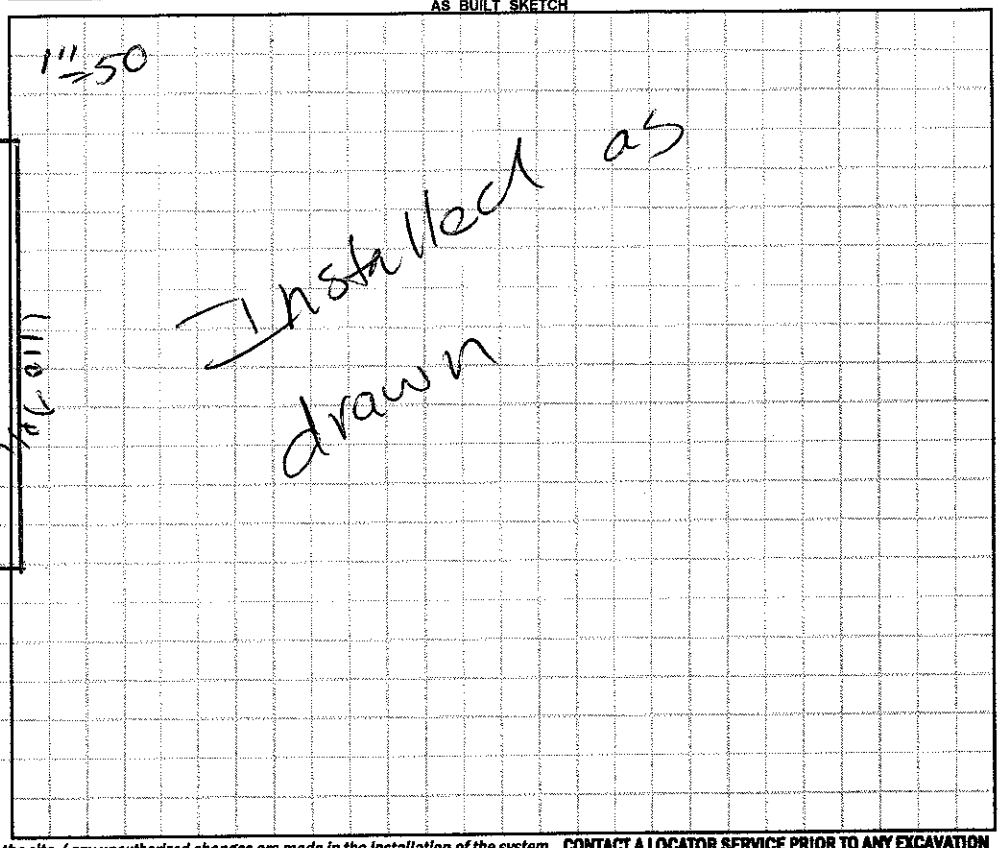

Permit can be suspended or revoked if any false information is supplied toward securing the permit / any unauthorized changes are made to the site / any unauthorized changes are made in the installation of the system. **CONTACT A LOCATOR SERVICE PRIOR TO ANY EXCAVATION**

☐ **IMPROVEMENT PERMIT** *with plat valid without expiration.* ☑ **IMPROVEMENT PERMIT** *with site plan valid for 60 mos.* ☑ **AUTHORIZATION TO CONSTRUCT** *valid for period equal to IMPROVEMENT PERMIT--not to exceed 60 mo.*

Owner / Applicant Signature: Dale Gryder Date: 4.29.15 Installed by: Yountz Septic

IMPROVEMENT PERMIT by: Date: 04/29/16 OPERATION PERMIT by: Date: 05/16/16

AUTHORIZATION TO CONSTRUCT by: Date: 04/29/16 Existing System Inspected by: Date:

Health Dept. Copy - WHITE Applicant (Final Approval) - YELLOW Applicant (Conditional Approval) - PINK