IREDELL COUNTY HEALTH DEPARTMENT

STATESVILLE 704-878-5305 MOORESVILLE 704-664-5281

IMPROVEMENT PERMIT / CERTIFICATE OF COMPLETION / OPERATION PERMIT / EXISTING SYSTEM INSPECTION

PROPERTY DESCRIPTION NO. 069374 DATE 9-10-97 TAX MAP NO. 4726507666 Watershed: ☐ Yes ☑ No

OWNER OR CONTRACTOR Franklin J Bustle PHONE: Business _____ Home 873-3785

ADDRESS 581 Scotts Creek Rd Statesville

LOCATION Scotts Creek TL Miller Farm TR After TL Red Buck TL Ridgeview

SUBDIVISION Deer Craft BLOCK / SECTION _____ LOT 12A LOT AREA 0.63 SITE CLASS. P/S DESIGN FLOW 360 L.T.A.R. 0.3

Septic Tank: 1000 Gallons; STB 1012 Date 1-28-98

Pump Tank: _____ Gallons; PT _____ Date _____

Pump Make: _____ Model _____ Serial No. _____

Nitrification Field: No Fields 1 Square Feet 1200 Linear Feet 400

No Lines 5 Trench Width 36.0 Max Trench Bottom Depth 36.0 Gravel Depth 12.0

☑ New System ☐ Repair System Type: I, ☐ II, III, IV, V, VI

System Description: Gravity Conventional

Repair System Description: Gravity Chamber

Maintenance Agreement Required: ☐ Yes ☑ No conventional

☑ House/Mod. Home No. Bedrooms 3

☐ Mobile Home No. Bathrooms 2

☐ Business No. Employees _____

☐ Other _____


☐ Slab ☑ Crawl Space ☐ Basement w/plumbing ☐ Basement wo/plumbing

Water Supply: ☐ Individual ☐ Community ☒ Public


Comments: keep lines on contour 9ft on center

Comments:

INITIAL SITE SKETCH

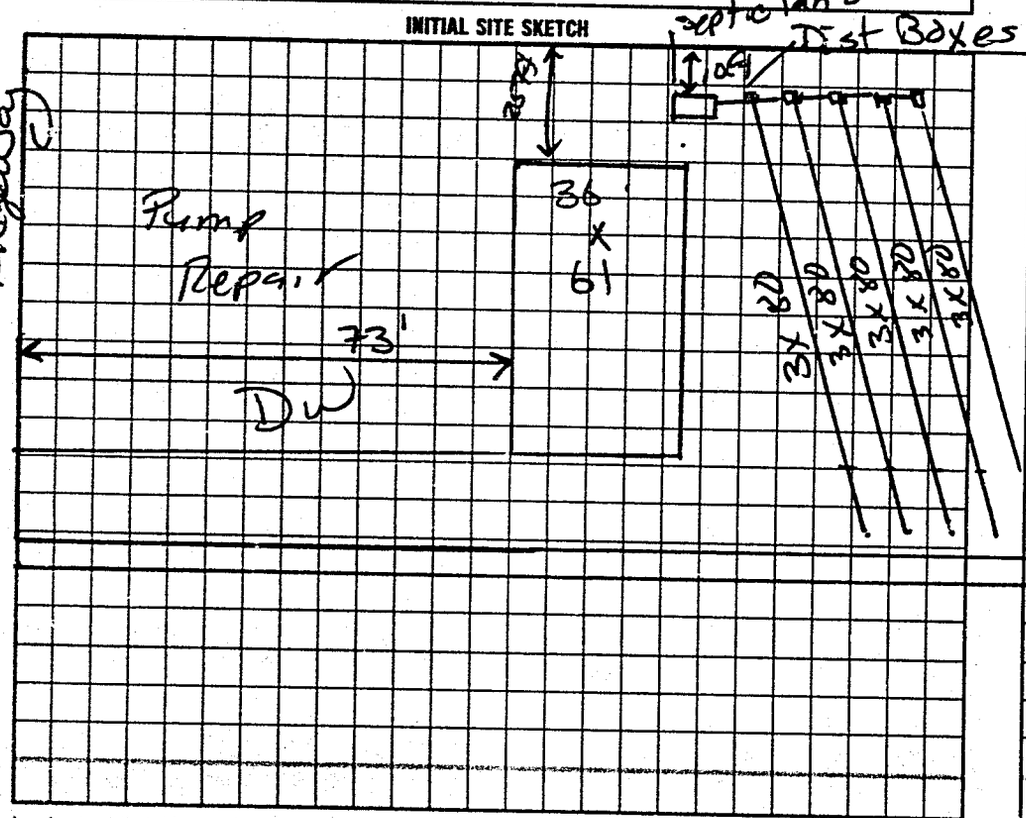

AS BUILT SKETCH

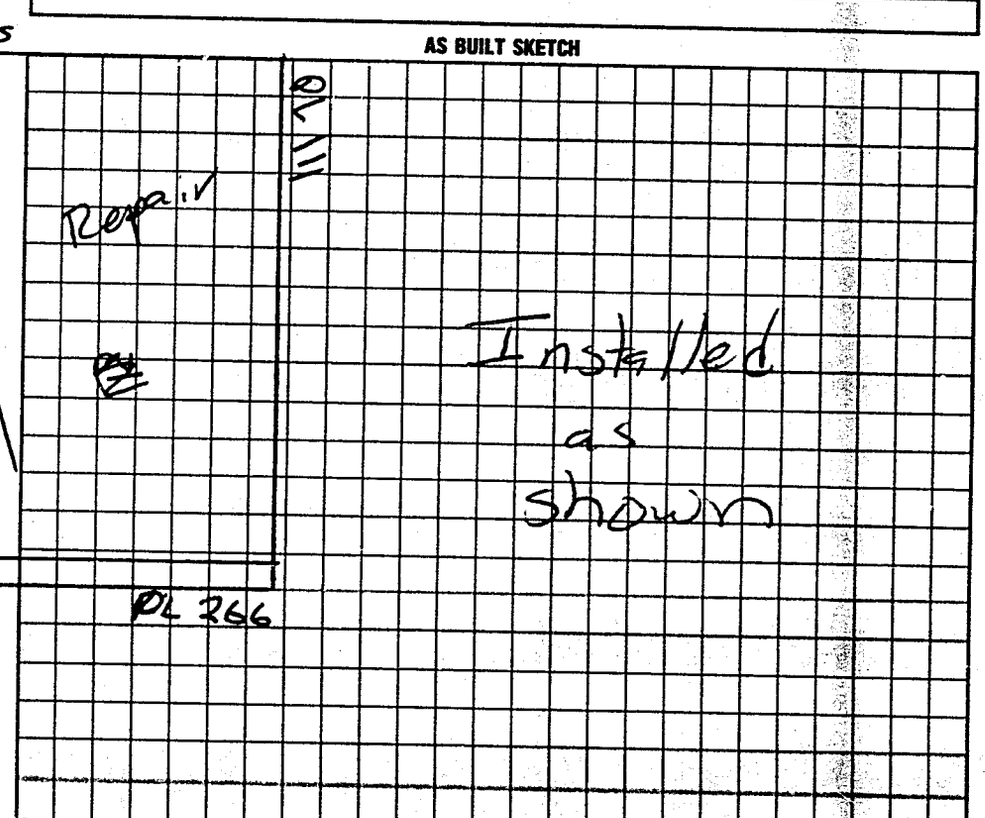

I understand that this permit can be suspended or revoked if any false information is supplied toward securing the permit/any unauthorized changes are made to the site/any unauthorized changes are made in the installation of the system. Improvement Permit is valid for 60 months from date of issuance.

Signed: T. Jimmy Bustle

Improvement Permit by: Mark Cox RS date 9-11-97

Authorization to Const. Existing System Inspection by: Mark Cox RS date 9-19-97

Installed by: David Yantz

Certificate of Completion by: _____ date _____

Operation Permit by: Mark Cox RS date 04-298

HEALTH DEPT. COPY: WHITE INSPECTION COPY (FINAL): GREEN OWNER COPY (FINAL): YELLOW INSPECTION COPY (INITIAL): PINK OWNER COPY (INITIAL): GOLD