9/30 Pd #1520

IREDELL COUNTY HEALTH DEPARTMENT

STATESVILLE 704-878-5305 MOORESVILLE 704-664-5281

IMPROVEMENT PERMIT / CERTIFICATE OF COMPLETION / OPERATION PERMIT / EXISTING SYSTEM INSPECTION

PROPERTY DESCRIPTION NO. 2430 | 06 | 30 DATE 9-28-96 TAX MAP NO. 9A-9-A-147 Watershed: ☐ Yes ☒ No

OWNER OR CONTRACTOR JIM HITT PHONE: Business Home 878-9664

ADDRESS 1216 RADIO ROAD STATESVILLE NC 28677

LOCATION NC 115 N, TL SCOTTS CREEK, TL MILLER FARM, TR ANTLER, TL REDBUCK, TL MORRISON CREEK, 4th FROM END ON RIGHT

SUBDIVISION DEERCROFT BLOCK / SECTION III LOT 147 LOT AREA ~110'X 855' SITE CLASS. PS DESIGN FLOW 360 L.T.A.R. 0.20 GPD/FT²

Septic Tank: 1000 Gallons; STB 1007 Date 10-20-97

Pump Tank: 1000 Gallons; PT 77 Date 7-24-97

Pump Make: Hydromatic Model SHEF50A1 Serial No. 51867008?

Nitrification Field: No Fields 1 Square Feet Eq. P. 1800 Linear Feet ~468

No Lines SIX Trench Width 36" Max Trench Bottom Depth 36" Gravel Depth N/A

☒ New System ☐ Repair System Type: I, II, III, IV, V, VI

System Description: CHAMBERED PUMPED

Repair System Description: LOW PRESSURE PIPE

Maintenance Agreement Required: ☐ Yes ☒ No

☒ House/Mod. Home ☐ Mobile Home ☐ Business ☐ Other

No. Bedrooms 3 No. Bathrooms 2 No. Employees


Water Supply: ☐ Individual ☐ Community ☒ Public

☐ Slab ☒ Crawl Space ☐ Basement w/plumbing ☐ Basement wo/plumbing


Comments: ① INSTALL 78 CHAMBERS IN SIX EQUAL LENGTH LINES ON CONTOUR ② KEEP SYSTEM MINIMUM 10' FROM PROPERTY LINE AND WATER LINE ③ CONTACT HEALTH DEPT. FOR PUMP & PRESSURE MANIFOLD REQUIREMENTS PRIOR TO INSTALLATION

Comments:
12-1-97 checked pressure setting mo
1-16-98 Checked alarm & panel

INITIAL SITE SKETCH

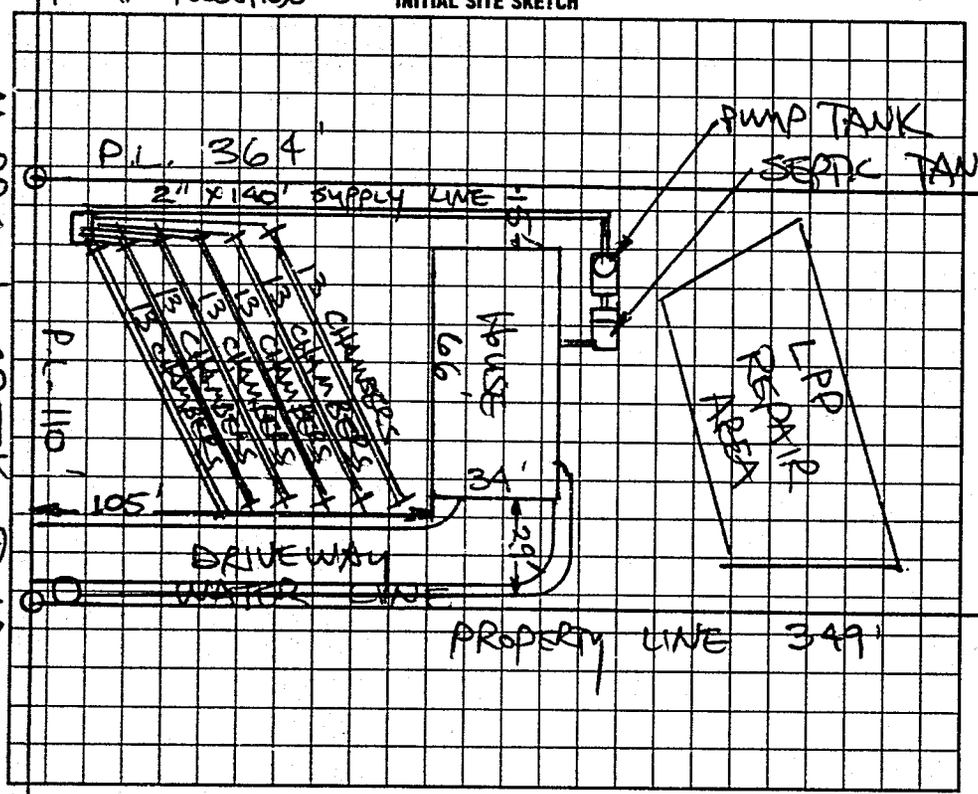

AS BUILT SKETCH

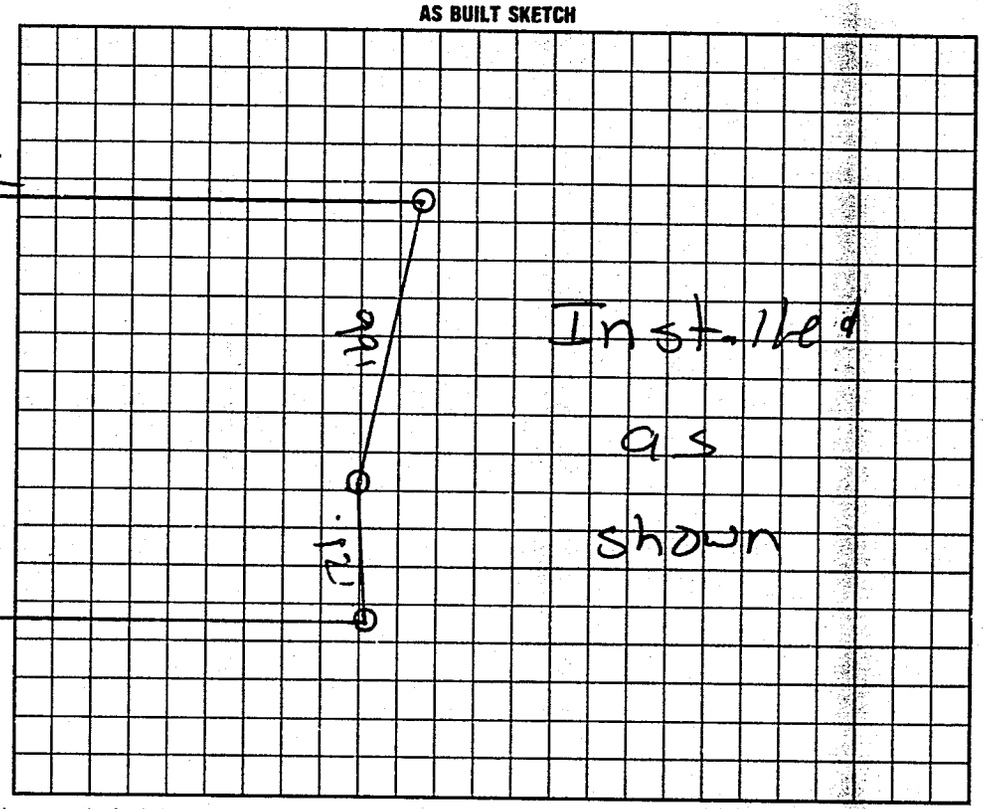

I understand that this permit can be suspended or revoked if any false information is supplied toward securing the permit/any unauthorized changes are made to the site/any unauthorized changes are made in the installation of the system. AUTH. TO CONST. IS VALID FOR A PERIOD EQUAL TO THE VALIDITY OF THE I.P. NOT TO EXCEED FIVE YEARS. I.P. & SITE PLAN IS VALID FOR FIVE YEARS.

Signed: James Edward Hitt, Jr.

Improvement Permit by: STEVE HENDRICK date 9-28-96

Authorization to Construct

Existing System Inspection by: STEVE HENDRICK date 9-28-96

Installed by: James Huddle

~~Certificate of Completion~~ by: date

Operation Permit by: Mark Coffey date 1-16-98

HEALTH DEPT. COPY: WHITE INSPECTION COPY (FINAL): GREEN OWNER COPY (FINAL): YELLOW INSPECTION COPY (INITIAL): PINK OWNER COPY (INITIAL): GOLD