IREDELL COUNTY HEALTH DEPARTMENT

STATESVILLE 704-878-5305 MOORESVILLE 704-664-5281

IMPROVEMENT PERMIT / AUTHORIZATION TO CONSTRUCT / OPERATION PERMIT / EXISTING SYSTEM INSPECTION

PERMIT# 150617 PIN# 4726-50-8675 DATE 11 June 08

OWNER OR APPLICANT Michael & Cheryl Simmons PHONE: Business 704-309-4658 Home

ADDRESS 136 Ridgeview Rd. Statesville

LOCATION Scott Creek Rd. TL Miller Farm TR Auten TL Red Buck TL Ridgeview on Rt.

SUBDIVISION Deerlee ft BLOCK / SECTION III LOT 127 LOT AREA 0.63Ac. SITE CLASS. PS DESIGN FLOW 300gpd L.T.A.R. 0.25sq ft/gpd

Septic Tank: Exist. Gallons: STB Date

Pump Tank: Gallons: PT Date

Pump Make: Model Serial No.

Nitrification Field: No Fields 1 Square Feet 400 Linear Feet 100

No Lines 2 Trench Width 36" Max Trench Bottom Depth 30" Gravel Depth

☐ New System ☐ Repair ☑ Expansion System Type: I II (III) IV V VI

System Description: 25% Reduction

Repair System Description: 25% Reduction

Maintenance Agreement Required: ☐ Yes ☒ No

☑ House/Mod. Home No. Bedrooms 3

☐ Mobile Home No. Persons

☐ Business No. Employees

☐ Other

Water Supply: ☐ Individual ☒ Public ☐ Community

☑ Gravity ☐ Pressure ☐ Slab ☑ Crawl Space ☐ Basement w/plumbing ☐ Basement wo/plumbing

Comments:/Conditions: Installing pool. Abandon all portions of system within 15' of pool. Cut-off lines and install 3ft. dam in each affected line keeping it 1ft. deeper than gravel.

Comments:/Conditions:

INITIAL SITE SKETCH

Please see attached layout.

AS BUILT SKETCH

Installed as drawn on site plan

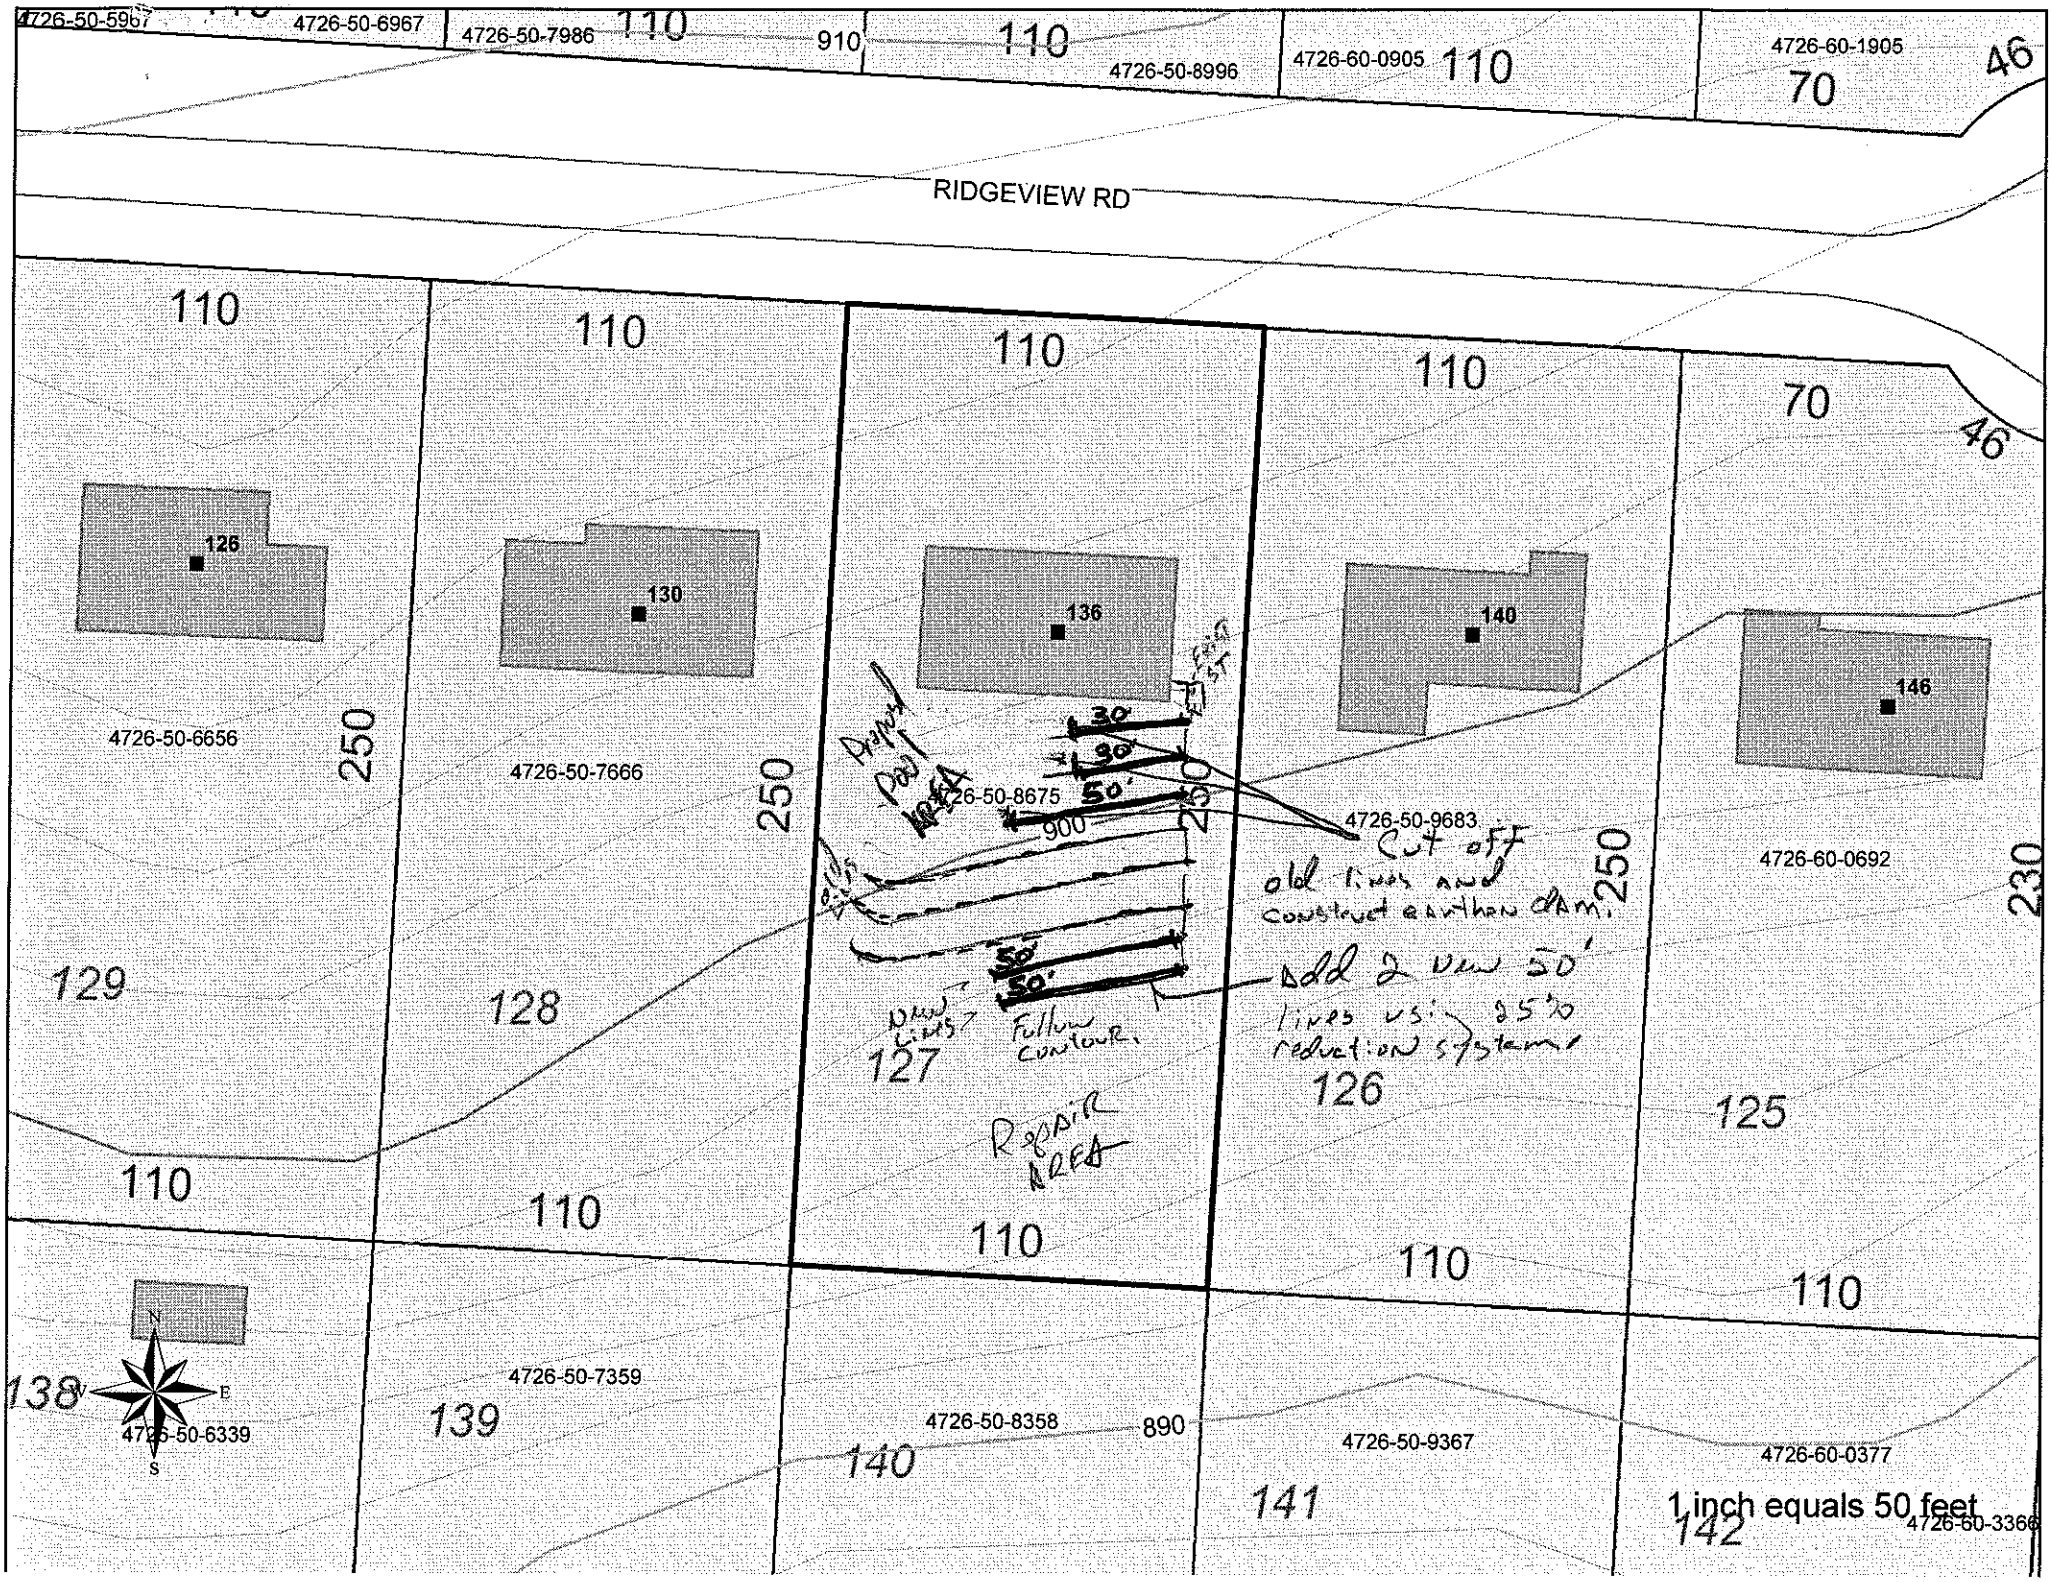
Permit can be suspended or revoked if any false information is supplied toward securing the permit/any unauthorized changes are made to the site/any unauthorized changes are made in the installation of the system. Improvement Permit with plat valid without expiration ☐ Improvement Permit with site plan valid for sixty months ☑ Authorization to Construct is valid for a period equal to that of Improvement Permit – not to exceed sixty months.

Signed: Cheryl Simmons date 6-13-08 Installed by: Ground Breakers

Improvement Permit by: R.S. date 12 June 08 Operation Permit by: R.S. date 28 July 08

Authorization to Construct by: R.S. date 12 June 08 Existing System Inspection by: date

HEALTH DEPT. COPY: WHITE OWNER COPY (FINAL): YELLOW OWNER COPY (INITIAL): PINK


4726-50-5967
4726-50-6967
4726-50-7986
910
4726-50-8996
4726-60-0905
4726-60-1905
RIDGEVIEW RD
110
70
46
126
130
136
140
146
4726-50-6656
4726-50-7666
4726-50-8675
4726-50-9683
4726-60-0692
250
230
900
Proposed Pool Area
Cut off old lines and construct earthen dam.
Add 2 new 50' lines using 25% reduction system.
Follow contour.
Repair Area
129
128
127
126
125
4726-50-6339
4726-50-7359
4726-50-8358
4726-50-9367
4726-60-0377
890
138
139
140
141
142
N
S
E
1 inch equals 50 feet
4726-60-3366