1:00 56141

# IREDELL COUNTY HEALTH DEPARTMENT

STATESVILLE 704-878-5305 MOORESVILLE 704-664-5281

## IMPROVEMENT PERMIT / CERTIFICATE OF COMPLETION / OPERATION PERMIT / EXISTING SYSTEM INSPECTION

PROPERTY DESCRIPTION NO. 21201 DATE 5/23/95 TAX MAP NO. 9A-9-A-127 Watershed: ☐ Yes ☑ No

OWNER OR CONTRACTOR KENNETH A. WATT PHONE: Business Home 876-0047

ADDRESS 129 BECKHAM ROAD STATESVILLE, NC 28677

LOCATION NC115 N, TL SCOTTS CREEK, TL MILLER FARM, TR ANTLER, TL RED BUCK, TL RIDGEVIEW

SUBDIVISION DEERCROFT BLOCK / SECTION III LOT 127 LOT AREA 110' x 250' SITE CLASS. PS DESIGN FLOW 360 L.T.A.R. 0.25 GPD/FT²

Septic Tank: 1000 Gallons; STB 791 Date 5-30-95

Pump Tank: Gallons; PT Date

Pump Make: Model Serial No.

Nitrification Field: No Fields 1 Square Feet 1440 Linear Feet 480

No Lines 6 Trench Width 36" Max Trench Bottom Depth 18-20" Gravel Depth 12"

☑ New System ☐ Repair System Type: I ☐ II, III, IV, V, VI

System Description: CONVENTIONAL GRAVITY

Repair System Description: CHAMBERED GRAVITY

Maintenance Agreement Required: ☐ Yes ☑ No

☑ House/Mod. Home ☐ Mobile Home ☐ Business ☐ Other

No. Bedrooms 3 No. Bathrooms 2 No. Employees

☐ Slab ☑ Crawl Space ☐ Basement w/plumbing ☐ Basement wo/plumbing


Water Supply: ☐ Individual ☐ Community ☑ Public

Comments: ① KEEP SYSTEM MINIMUM 5' FROM HOUSE, 10' FROM PROPERTY LINE ② INSTALL LINES ON CONTOUR NO DEEPER THAN 30", 9' MIN. APART ON CENTERS

Comments:

7B LOT ON RIGHT

INITIAL SITE SKETCH

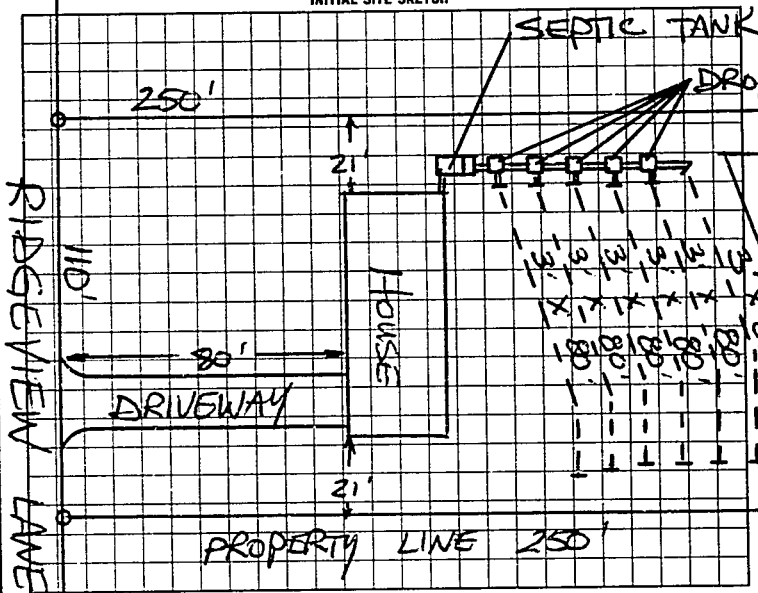


AS BUILT SKETCH

SAME AS INITIAL SKETCH

I understand that this permit can be suspended or revoked if any false information is supplied toward securing the permit/any unauthorized changes are made to the site/any unauthorized changes are made in the installation of the system. Improvement Permit is valid for 60 months from date of issuance.

Signed: Kenneth A. Watt

Improvement Permit by: STEVE HEDRICK date 5/23/95

Existing System Inspection by date

Installed by: A-1 Backhoe

Certificate of Completion by: Michael D. Dennis date 8-14-95

Operation Permit by date

HEALTH DEPT. COPY. WHITE INSPECTION COPY (FINAL). GREEN OWNER COPY (FINAL) YELLOW INSPECTION COPY (INITIAL) PINK OWNER COPY (INITIAL) GOLD

0 0 2 2 0 6