9/30 Pd #152

IREDELL COUNTY HEALTH DEPARTMENT

STATESVILLE 704-878-5305 MOORESVILLE 704-664-5281

IMPROVEMENT PERMIT / CERTIFICATE OF COMPLETION / OPERATION PERMIT / EXISTING SYSTEM INSPECTION

PROPERTY DESCRIPTION NO. 25160-75233 DATE 9-28-96 TAX MAP NO. 9A-9-A-146 Watershed: ☐ Yes ☒ No

OWNER OR CONTRACTOR JAMES E. HITT, JR PHONE: Business Home 878-9664

ADDRESS 1216 RADIO ROAD STATESVILLE, NC 28677

LOCATION NC 115 N, TL SCOTTS CREEK, TL MILLER FARM TRAILER, TL REDBUCK, TL MORRISON CREEK, 3RD FROM END ON (R)

SUBDIVISION DEER CROFT BLOCK / SECTION III LOT 146 LOT AREA ~110'X 365' SITE CLASS. P3 DESIGN FLOW 360 L.T.A.R. 0.20 GPD/FT²

Septic Tank: 1000 Gallons; STB 794 Date 3-23-98

Pump Tank: 1000 Gallons; PT 2~~3~~ Date 8-30-98

Pump Make: HYDROMATIC Model SHEF 50M Serial No.

Nitrification Field: No Fields ☒ Square Feet EQ TO 1800 Linear Feet 450+

No Lines SIX SEVEN Trench Width 36" Max Trench Bottom Depth 36" Gravel Depth N/A

☒ New System ☐ Repair System Type: I, II, III, IV, V, VI

System Description: CHAMBERED PUMP-FED

Repair System Description: LOW PRESSURE PIPE

Maintenance Agreement Required: ☐ Yes ☒ No

☒ House/Mod. Home ☐ Mobile Home ☐ Business ☐ Other

No. Bedrooms 3 No. Bathrooms 2 No. Employees


☐ Slab ☒ Crawl Space ☐ Basement w/plumbing ☐ Basement wo/plumbing

Water Supply: ☐ Individual ☐ Community ☒ Public


Comments: ① INSTALL 98 CHAMBERS IN SIX EQUAL LENGTH LINES AS SHOWN ON CONTOUR ② KEEP SYSTEM MINIMUM 10' FROM PROPERTY LINE & WATER LINE ③ CONTACT HEALTH DEPT. FOR PUMP & PRESSURE MANIFOLD REQUIREMENTS PRIOR TO INSTALLATION.

Comments: ① 84 CHAMBERS INSTALLED IN SEVEN EQUAL LENGTH LINES DUE TO DRIVEWAY/GARAGE CHANGES ON-SITE. ② ALL SYSTEM COMPONENTS EXCEPT ELECTRICAL BOX & ALARM CHECKED 10-6-98

INITIAL SITE SKETCH

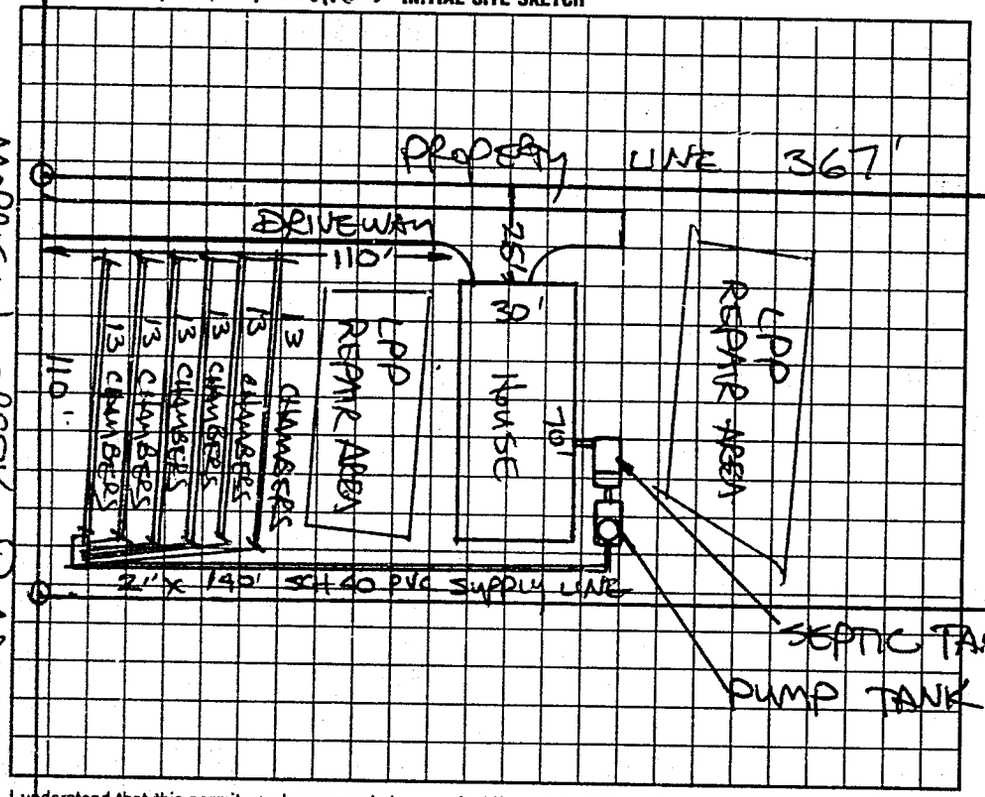

AS BUILT SKETCH

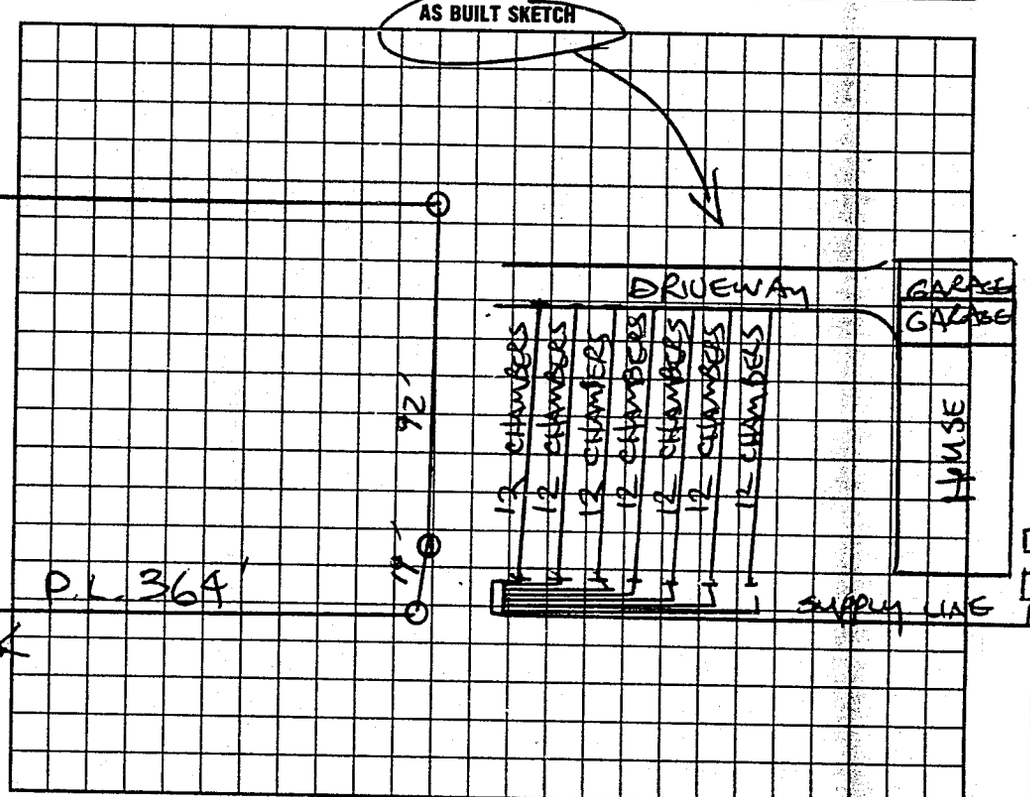

MORRISON CREEK ROAD

I understand that this permit can be suspended or revoked if any false information is supplied toward securing the permit/any unauthorized changes are made to the site/any unauthorized changes are made in the installation of the system.

AUTH. TO CONST. IS VALID FOR A PERIOD EQUAL TO THE VALIDITY OF THE I.P. NOT TO EXCEED FIVE YEARS. I.P. W/SITE PLAN IS VALID FIVE YEARS

Signed: James Edward Hitt Jr.

Improvement Permit by: STEVE HEDRICK date 9-28-96

AUTHORIZATION TO CONSTRUCT

Existing System Inspection by: STEVE HEDRICK date 9-28-96

Installed by: JAMES HUBLER

~~Certificate of Completion by:~~ date

Operation Permit by: STEVE HEDRICK date 12-18-98

HEALTH DEPT. COPY: WHITE INSPECTION COPY (FINAL): GREEN OWNER COPY (FINAL): YELLOW INSPECTION COPY (INITIAL): PINK OWNER COPY (INITIAL): GOLD