IREDELL COUNTY HEALTH DEPARTMENT

STATESVILLE 704-878-5305 (@) MOORESVILLE 704-664-5281 (@)

IMPROVEMENT PERMIT / AUTHORIZATION TO CONSTRUCT / OPERATION PERMIT / EXISTING SYSTEM INSPECTION

PERMIT # 166056 PIN # 4726 50 9683 DATE May 12, 2011

OWNER or APPLICANT Ed Bundy PHONE: Business 704 495 5043 Home:

OWNER or APPLICANT ADDRESS 140 Ridgeview Rd. Statesville, NC 28625

LOCATION / DIRECTIONS Scotts Creek Rd TL on Miller Town Rd. TR Antler TL Red Buck TL Ridgeview on Right #140

SUBDIVISION Deercroft BLOCK / SECTION LOT # 126 LOT AREA 110'x250' DESIGN FLOW 360 gpd L.T.A.R. .25-.3

Septic Tank Existing Gallons: STB Date

Pump Tank Gallons: P T Date

Pump Make Model Serial #

Nitrification Field No Fields 1 No Lines 2 Linear Feet 130

Trench Width 36" Max. Trench Bottom Depth 36" Gravel Depth N/A ☒ GRAVITY ☐ PRESSURE

☐ New System ☐ Repair ☒ Expansion System Type I II (III) IV V VI

System Description: Gravity 25% Reduction

Repair System Description: Gravity 25-50% Reduction

Maintenance Agreement Required ☐ YES ☒ NO


☒ Residence No. Bedrooms 3 ☐ Business No. Persons ☐ Other No. Employees ☐ Slab ☒ Crawl Space ☐ Basement w/plumbing ☐ Basement w/o plumbing

Water Supply ☐ Private ☒ Public ☐ Community


Comments / Conditions: Remove 4" corrugated pipe and gravel from first 3 trenches on Septic tank side of pool excavation to a distance of 15' from pool wall. Create earthen or concrete dam where shown. Septic system being modified due to pool installation

Comments / Conditions

INITIAL SITE SKETCH

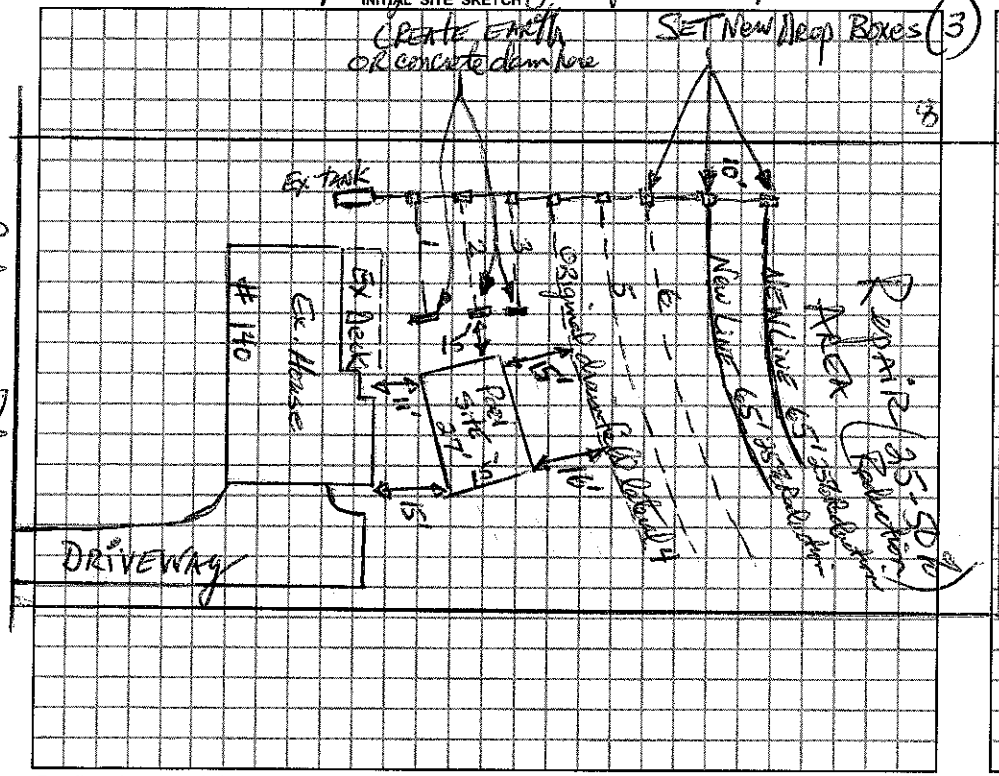

AS BUILT SKETCH

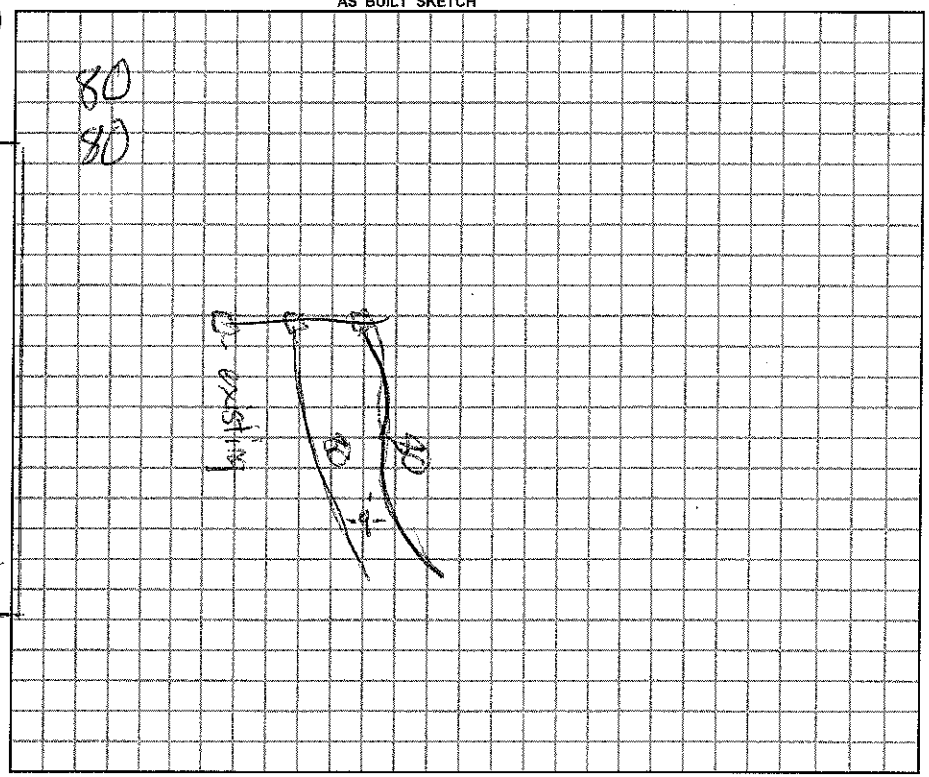

Permit can be suspended or revoked if any false information is supplied toward securing the permit / any unauthorized changes are made to the site / any unauthorized changes are made in the installation of the system.

☐ IMPROVEMENT PERMIT w / plat valid without expiration. ☒ IMPROVEMENT PERMIT w / site plan valid for 60 mos. ☐ AUTHORIZATION TO CONSTRUCT valid for period equal to IMPROVEMENT PERMIT-not to exceed 60 mo.

Owner / Applicant Signature: Thomas E. Bundy Date 5-13-11

Improvement Permit by: [signature] REHS Date 5-12-11

Authorzation to Construct by: [signature] REHS Date 5-12-11

YOU SHOULD CONTACT A LOCATOR SERVICE PRIOR TO ANY EXCAVATION.

Installed by: Cothren + Sons

Operation Permit by: [signature] Date: 6-4-11

Existing System Inspected by: Date:

WHITE COPY Environmental Health YELLOW COPY (Final) Owner / Applicant PINK COPY (Initial) Owner / Applicant