IREDELL COUNTY HEALTH DEPARTMENT

STATESVILLE 704-878-5305 MOORESVILLE 704-664-5281

IMPROVEMENT PERMIT / AUTHORIZATION TO CONSTRUCT / OPERATION PERMIT / EXISTING SYSTEM INSPECTION

DATE 2/5/01

PERMIT# 010090 PIN# 4726510599

OWNER OR CONTRACTOR Wayne Haynes PHONE: Business (704) 224-7382 Home

ADDRESS 139 Long Reed Dr. Mooresville NC 28117

LOCATION Hwy 115 N, ② Scotts Creek Ln, ③ Miller Farm Ln, ④ on Antler Dr. 1st + End # 117

SUBDIVISION Deercroft BLOCK / SECTION LOT 117 LOT AREA .6 Ac SITE CLASS. 15 DESIGN FLOW 360 L.T.A.R. .25

Septic Tank: 1,000 Gallons: STB 794 Date 5-13-01

Pump Tank: Gallons: PT Date

Pump Make: Model Serial No.

Nitrification Field: No Fields 1 Square Feet 1440 Linear Feet 780 + 30'

No Lines See 72' Trench Width 36" Max Trench Bottom Depth 30" Gravel Depth —

☒ New System ☐ Repair System Type: I, II, III, IV, V, VI

System Description: 25% Reduction Pump

Repair System Description: 5% Reduction Pump

Maintenance Agreement Required: ☐ Yes ☒ No

☒ House/Mod. Home ☐ Mobile Home ☐ Business ☐ Other

No. Bedrooms 3 No. Bathrooms 2 No. Employees


Water Supply: ☐ Individual ☒ Public ☐ Community

☐ Slab ☒ Crawl Space ☐ Basement w/plumbing ☐ Basement wo/plumbing


Comments/Conditions: ① Do not install Uber Lock ② Install 360ft of Chamber or HDES ③ Keep 10ft off property lines ④ Install lines on contour

Comments/Conditions — Poly Lok Filters Installed — Septic Tank Marker Installed — Installed 360 Ft HDES Section 8

INITIAL SITE SKETCH

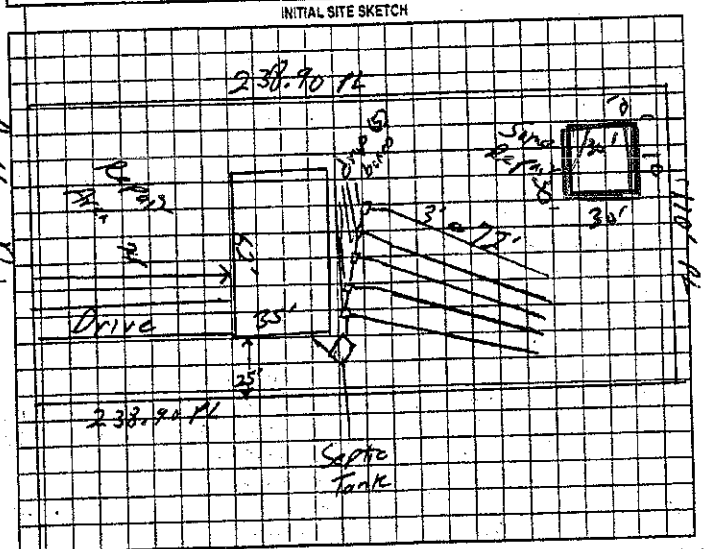

AS BUILT SKETCH

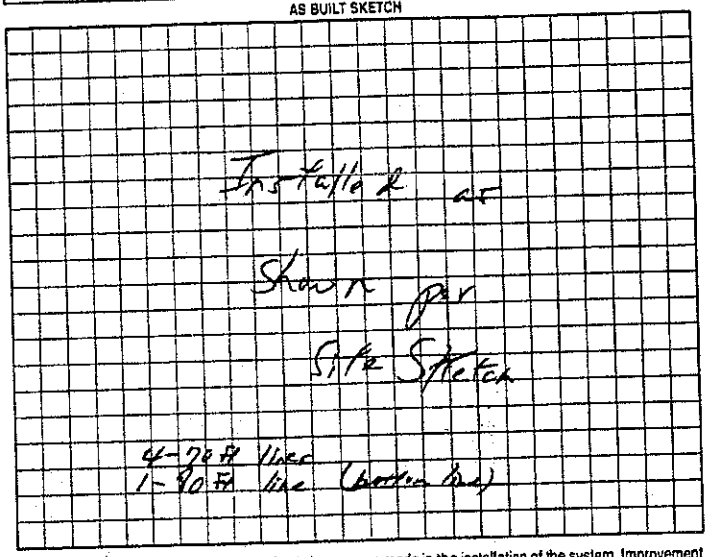

Permit can be suspended or revoked if any false information is supplied toward securing the permit/any unauthorized changes are made to the site/any unauthorized changes are made in the installation of the system. Improvement Permit with pipit valid without expiration. Improvement Permit with site plan valid for sixty months. Authorization to Construct is valid for a period equal to that of Improvement Permit – not to exceed sixty months.

Signed: William O. Johnson date 2-8-01 Installed by: Mitchell Hauling + Grading

Improvement Permit by: William O. Johnson REI date 2/5/01 Operation Permit by: William O. Johnson date 6-15-01

Authorization to Construct by: William O. Johnson REI date 2/5/01 Existing System Inspection by: date

HEALTH DEPT. COPY: WHITE OWNER COPY (FINAL): YELLOW OWNER COPY (INITIAL): PINK

Location of the proposed 30' X 30' GARAGE addition does not appear to impact the existing on-site septic system.**NOTE: KEEP MIN' 5' FROM SYSTEM

R. STEVE HENDRICK REHS

Date: 2/14/2013

ICHD-Environmental Health Division