IREDELL COUNTY HEALTH DEPARTMENT

STATESVILLE 704-878-5305 MOORESVILLE 704-664-5281

4889/

IMPROVEMENT PERMIT / CERTIFICATE OF COMPLETION / OPERATION PERMIT / EXISTING SYSTEM INSPECTION

PROPERTY DESCRIPTION NO. 17111 DATE 9/28/93 TAX MAP NO. 9A-9-A-64

OWNER OR CONTRACTOR JEFFREY TODD ELLIS PHONE: Business Home 878-6633

ADDRESS RT. 15, BOX 19, STVL, NC 28677

LOCATION NC115N TL SCOTTS CREEK RD, TL MILLER FARM, TRANTER DR, LOT #N ANTER ELK DRIVE

SUBDIVISION DEERCROFT BLOCK / SECTION II LOT 64 LOT AREA 110x288 SITE CLASS. PS L.T.A.R. 0.35 GPD/FT²

Water Supply: ☐ Individual ☐ Community ☑ Public

Septic Tank: 1000 Gallons; STB 358 Date 2/8/94

Pump Tank: ____ Gallons; PT ____ Date ____

Nitrification Field: No. Fields 1 Square Feet 1035 Linear Feet 345

No. Lines 3 Trench Width 36 Trench Depth 18-36 Gravel Depth 12"

☑ New System ☐ Repair System Type: I II III IV V VI

System Description: CONV. GRAVITY

Repair System Description: CONV. GRAVITY

Maintenance Agreement Required: ☐ Yes ☑ No

☑ House/Mod. Home No. Bedrooms 3

☐ Mobile Home No. Bathrooms 2

☐ Business No. Employees ____

☐ Other ____

Garbage Disposal: ☐ Yes ☑ No

Auto. Dishwasher: ☑ Yes ☐ No

Auto. Washing Machine: ☑ Yes ☐ No


Other ____

☐ Slab ☑ Crawl Space ☐ Basement w/plumbing ☐ Basement wo/plumbing

Comments

SEPTIC TANK INSPECTED 2/8/94 RSH

INITIAL SITE SKETCH

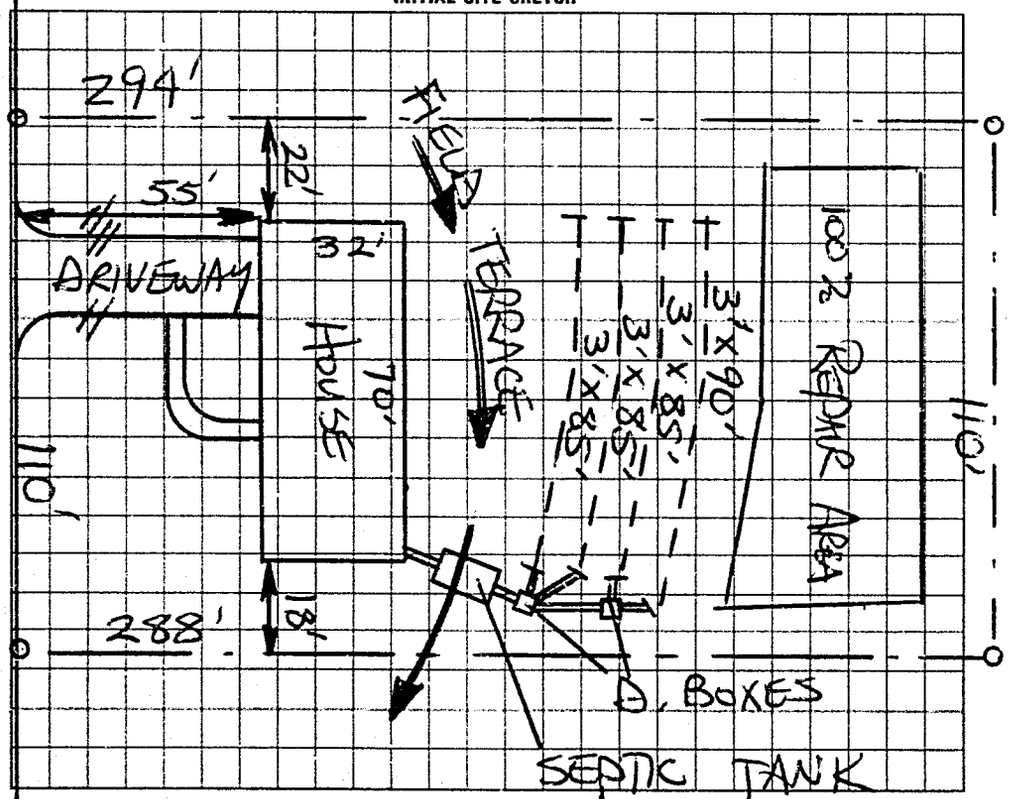

AS BUILT SKETCH

SYSTEM INSTALLED ACCORDING TO INITIAL SITE SKETCH

ANTER DRIVE

I understand that this permit can be suspended or revoked if any false information is supplied toward securing the permit/any unauthorized changes are made to the site/any unauthorized changes are made in the installation of the system. Improvement Permit is valid for 60 months from date of issuance.

Signed: Jeffrey Todd Ellis

Improvement Permit by: STEVE HEDRICK date 9/28/93

Existing System Inspection by: ____ date ____

Installed by: DAVID YOUNTZ

Certificate of Completion by: STEVE HEDRICK date 3/17/94

Operation Permit by: ____ date ____

HEALTH DEPT. COPY WHITE INSPECTION COPY (FINAL) GREEN OWNER COPY (FINAL) YELLOW INSPECTION COPY (INITIAL) PINK OWNER COPY (INITIAL) GOLD

590000