IREDELL COUNTY HEALTH DEPARTMENT

STATESVILLE 704-878-5305 MOORESVILLE 704-664-5281

53751

IMPROVEMENT PERMIT / CERTIFICATE OF COMPLETION / OPERATION PERMIT / EXISTING SYSTEM INSPECTION

PROPERTY DESCRIPTION NO. 17864 DATE 2/22/94 TAX MAP NO. 9A-9-A-68 Watershed: ☐ Yes ☑ No

OWNER OR CONTRACTOR HERITAGE BLDG. CO. PHONE: Business Home 528-6694

ADDRESS RT. 10, Box 177-A, STVL, NC 28677

LOCATION NC 115 N TL SCOTTS CREEK, TL MILLER FARM TR ANTLER DR, 3RD LOT ON (R) PAST ELK DR.

SUBDIVISION DEERCROFT BLOCK / SECTION II LOT 68 LOT AREA 239 x 110' SITE CLASS. PS DESIGN FLOW 360 L.T.A.R. 0.33 GPD/FT²

Septic Tank: 1000 Gallons; STB 794 Date 1/27/95

Pump Tank: _____ Gallons; PT _____ Date _____

Pump Make: _____ Model _____ Serial No. _____

Nitrification Field: No. Lines 1 Square Feet 1080 Linear Feet 360

No Lines 4 Trench Width 36" Max Trench Bottom Depth 18-36" Gravel Depth 12"

☑ New System ☐ Repair System Type: I ☑ II III IV V VI

System Description: CONV. GRAVITY

Repair System Description: CONV. GRAVITY

Maintenance Agreement Required: ☐ Yes ☑ No

☐ Slab ☑ Crawl Space ☐ Basement w/plumbing ☐ Basement wo/plumbing

☑ House/Mod. Home No. Bedrooms 3-2

☐ Mobile Home No. Bathrooms

☐ Business No. Employees


☐ Other

Water Supply: ☐ Individual ☐ Community ☑ Public

Comments: (1) KEEP SYSTEM MINIMUM 5' FROM HOUSE, 10' FROM PROPERTY LINE (2) INSTALL LINES ON CONTOUR, NO DEEPER THAN 36", 9' O.C.

Comments:

INITIAL SITE SKETCH

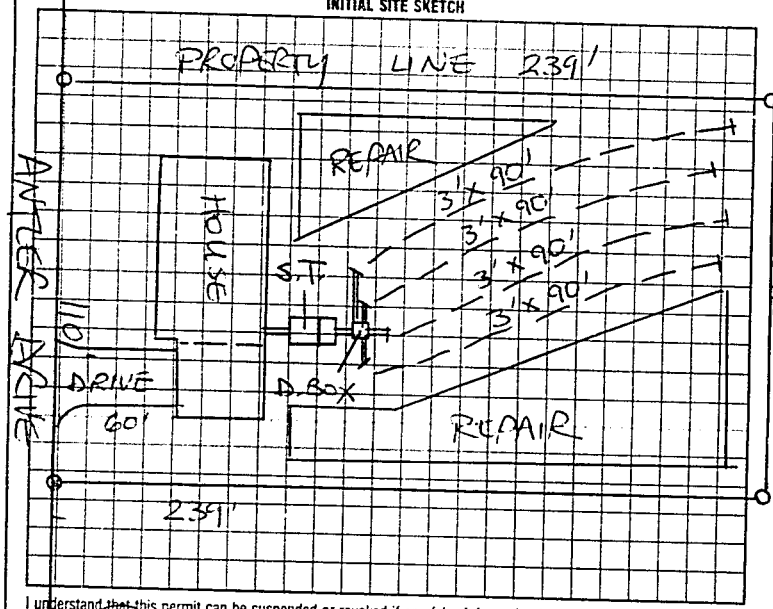

AS BUILT SKETCH

SYSTEM INSTALLED ACCORDING TO INITIAL SITE SKETCH

I understand that this permit can be suspended or revoked if any false information is supplied toward securing the permit/any unauthorized changes are made to the site/any unauthorized changes are made in the installation of the system. Improvement Permit is valid for 60 months from date of issuance.

Signed _____

Improvement Permit by: STEVE HENDRICK date 2/22/94

Existing System Inspection by: _____ date _____

Installed by: WES LYTON

Certificate of Completion by: STEVE HENDRICK date 3/23/95

Operation Permit by: _____ date _____

HEALTH DEPT COPY WHITE INSPECTION COPY (FINAL) GREEN OWNER COPY (FINAL): YELLOW INSPECTION COPY (INITIAL): PINK OWNER COPY (INITIAL): GOLD