IREDELL COUNTY HEALTH DEPARTMENT

STATESVILLE 704-878-5305 MOORESVILLE 704-664-5281

50582

IMPROVEMENT PERMIT / CERTIFICATE OF COMPLETION / OPERATION PERMIT / EXISTING SYSTEM INSPECTION

PROPERTY DESCRIPTION NO. 17867 DATE 2/22/94 TAX MAP NO. 9A-9-A-77

OWNER OR CONTRACTOR HERITAGE BLDG. CO PHONE: Business Watershed: ☐ Yes ☑ No

ADDRESS RT. 10 BOX 177-A STVL, NC 28677 Home 528-6644

LOCATION NC 115 N, TL 1 SCOTTS CREEK TL 1 MILLER FARM TR DOE TRAIL, 3RD LOT ON RT. PASTELK-

SUBDIVISION DEERCROFT BLOCK / SECTION II LOT 77 LOT AREA 110 x 239 SITE CLASS. PS DESIGN FLOW 360 L.T.A.R. 0.35 GPD/FT²

Septic Tank: 1000 Gallons; STB 794 Date 2/14/94

Pump Tank: _____ Gallons; PT _____ Date _____

Pump Make: _____ Model _____ Serial No. _____

Nitrification Field: No. Fields 1 Square Feet 1035 Linear Feet 345

No Lines 3 Trench Width 36" Max Trench Bottom Depth 18-36" Gravel Depth 12"

☑ New System ☐ Repair System Type: I, II, III, IV, V, VI

System Description: CONV. GRAVITY

Repair System Description: CONV. GRAVITY

Maintenance Agreement Required: ☐ Yes ☑ No

☑ House/Mod. Home No. Bedrooms 3

☐ Mobile Home No. Bathrooms 2

☐ Business No. Employees _____

☐ Other _____


☐ Slab ☑ Crawl Space ☐ Basement w/plumbing ☐ Basement wo/plumbing

Water Supply: ☐ Individual ☐ Community ☑ Public


Comments: (1) KEEP SYSTEM MINMUM 5' FROM HOUSE 10' FROM PROPERTY LINE, (2) INSTALL LINES ON CONTOUR, NO DEEPER THAN 36", 9' OC.

Comments:

INITIAL SITE SKETCH

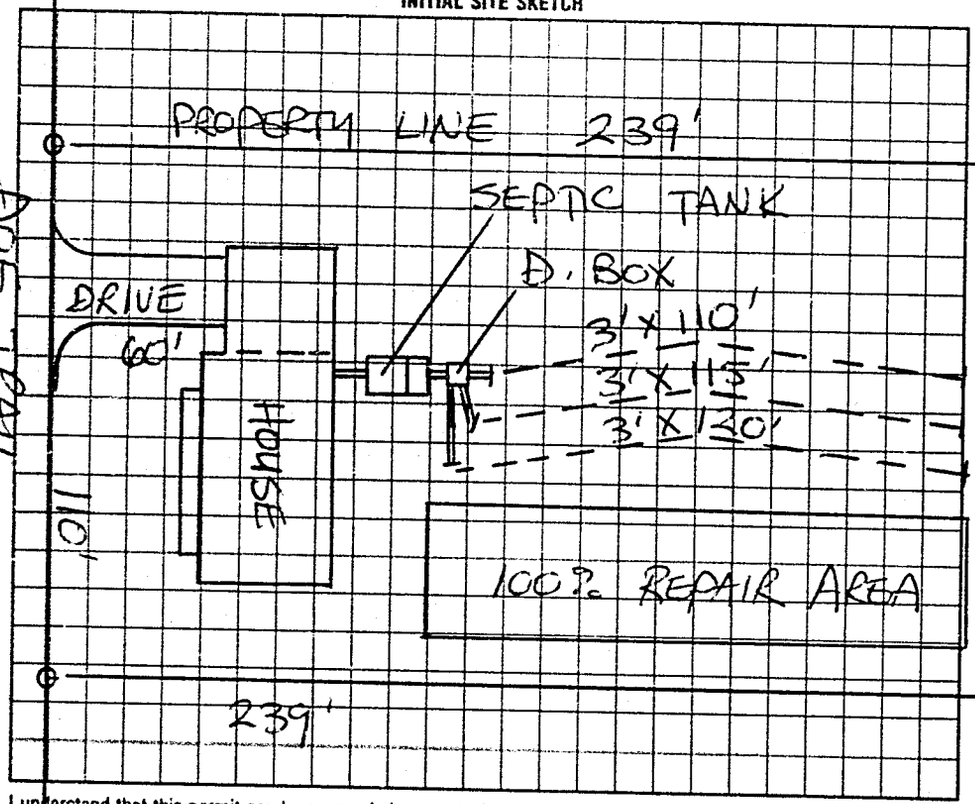

AS BUILT SKETCH

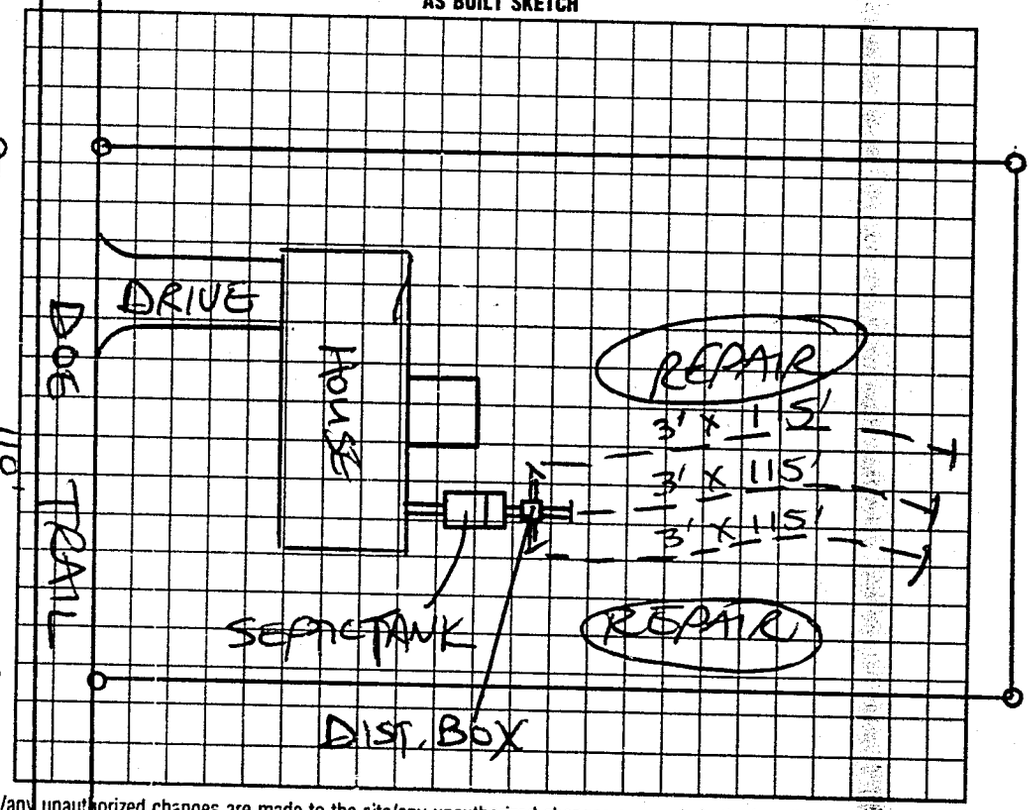

I understand that this permit can be suspended or revoked if any false information is supplied toward securing the permit/any unauthorized changes are made to the site/any unauthorized changes are made in the installation of the system. Improvement Permit is valid for 60 months from date of issuance.

Signed: _____

Improvement Permit by: STEVE HEDRICK date 2/22/94

Existing System Inspection by: _____ date _____

Installed by: WES LYTTON

Certificate of Completion by: STEVE HEDRICK date 4/29/94

Operation Permit by: _____ date _____

HEALTH DEPT. COPY: WHITE INSPECTION COPY (FINAL): GREEN OWNER COPY (FINAL): YELLOW INSPECTION COPY (INITIAL): PINK OWNER COPY (INITIAL): GOLD