Davor Sijerkovic Permit # 178389

IREDELL COUNTY HEALTH DEPARTMENT

STATESVILLE 704-878-5305 MOORESVILLE 704-664-5281

IMPROVEMENT PERMIT / CERTIFICATE OF COMPLETION / OPERATION PERMIT / EXISTING SYSTEM INSPECTION

PROPERTY DESCRIPTION NO. 23317 DATE 4-1-96 TAX MAP NO. 9A-9-A-74 Watershed: ☐ Yes ☒ No

OWNER OR CONTRACTOR KENT & SHERRY NICHOLSON PHONE: Business Home 876-4359

ADDRESS 182 MILLSTONE DRIVE, STATESVILLE, NC 28677

LOCATION NC115N, TL SCOTTS CREEK, TL MILLER FARM, TR DOE TRAIL, ON LEFT AT ELK DRIVE

SUBDIVISION DEER CROFT BLOCK / SECTION II LOT 74 LOT AREA ~110 X 239' SITE CLASS. PS DESIGN FLOW 360 L.T.A.R. 0.25 GPD/FT²

Septic Tank: 1000 Gallons: STB 1012 Date 5-26-96

Pump Tank: Gallons: PT Date

Pump Make: Model Serial No.

Nitrification Field: No Fields 1 Square Feet 1440 Linear Feet 480

No Lines 6 Trench Width 36" Max Trench Bottom Depth 18-36" Gravel Depth 12"

☒ New System ☐ Repair System Type: I II III IV V

System Description: CONVENTIONAL GRAVITY

Repair System Description: CONV. GRAVITY

Maintenance Agreement Required: ☐ Yes ☒ No

☒ House/Mod. Home No. Bedrooms 3

☐ Mobile Home No. Bathrooms 2

☐ Business No. Employees

☐ Other


☐ Slab ☐ Crawl Space ☐ Basement w/plumbing ☐ Basement wo/plumbing

Water Supply: ☐ Individual ☐ Community ☒ Public


Comments: ① USE ONE FLOW DIVIDER TEE TO ACHIEVE EQUAL DISTRIBUTION INTO TWO DISTRIBUTION BOXES FEEDING THREE LINES EACH ② KEEP SYSTEM MINIMUM 5' FROM HOUSE, 10' FROM PROPERTY LINE & WATER LINE

Comments:

INITIAL SITE SKETCH

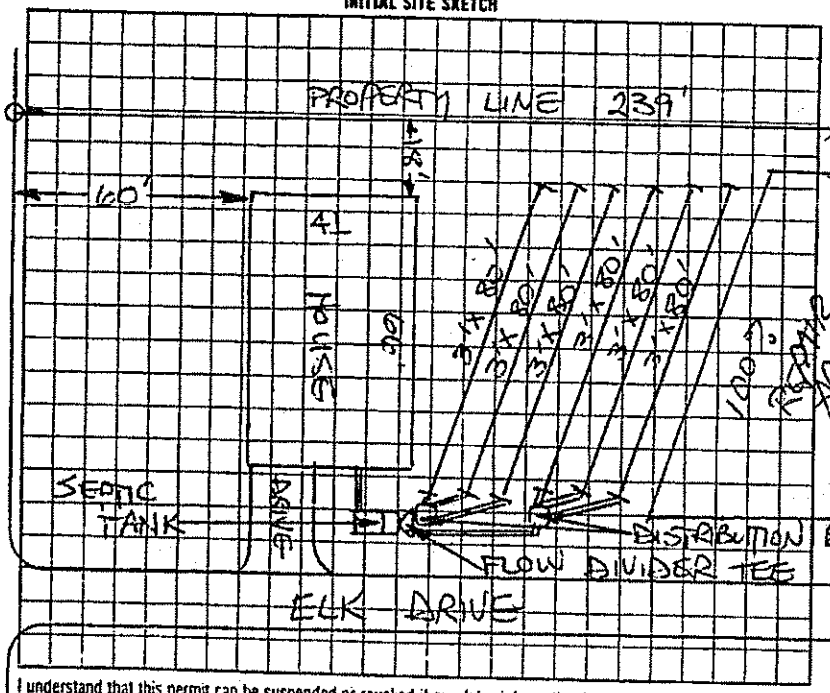

AS BUILT SKETCH

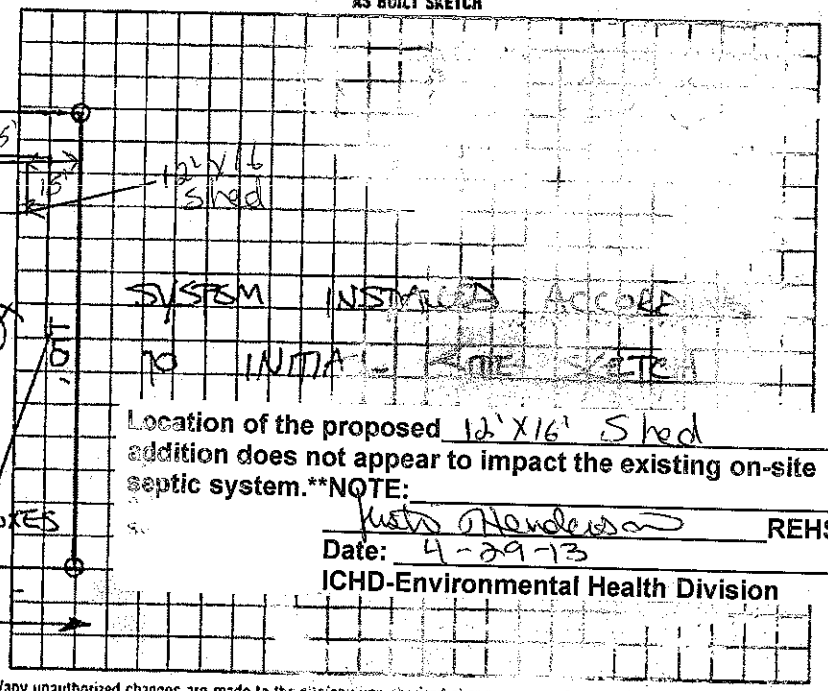

Location of the proposed 12'X16' Shed addition does not appear to impact the existing on-site septic system.**NOTE:

Justin Henderson REHS

Date: 4-29-13

ICHD-Environmental Health Division

I understand that this permit can be suspended or revoked if any false information is supplied toward securing the permit/any unauthorized changes are made to the existing approved plans made in the installation of the system.

Authorization to Construct is valid five (5) years from date of issuance. Improvement Permit is NOT AUTHORIZATION TO CONSTRUCT.

Signed:

Improvement Permit by: STEVE HEDRICK date 4-1-96

Existing System Inspection by: STEVE HEDRICK date 4-1-96

Installed by: TOMMY FRYE

Certificate of Completion by: date

Operation Permit by: STEVE date 4-19-96

HEALTH DEPT. COPY: WHITE INSPECTION COPY (FINAL): GREEN OWNER COPY (FINAL): YELLOW INSPECTION COPY (INITIAL): PINK OWNER COPY (INITIAL): GOLD