IREDELL COUNTY HEALTH DEPARTMENT

STATESVILLE 704-878-5305 MOORESVILLE 704-664-5281

50980

IMPROVEMENT PERMIT / CERTIFICATE OF COMPLETION / OPERATION PERMIT / EXISTING SYSTEM INSPECTION

PROPERTY DESCRIPTION NO. 18301 DATE 4/18/94 TAX MAP NO. 9A-9-A-72

OWNER OR CONTRACTOR DAN MAHAFFEY Watershed: ☐ Yes ☒ No

ADDRESS RT. 17, BOX 193 STVL, NC 28677 PHONE: Business Home 876-1797

LOCATION NC 115 N, TL SCOTTS CREEK RD, TL MILLER FARM RD, TR ANTLER DRIVE, LOT ON (R) BEFORE ELK

SUBDIVISION DEERCROFT BLOCK / SECTION II LOT 72 LOT AREA 110X239 SITE CLASS. P5 DESIGN FLOW 360' L.T.A.R. 0.35 GPD/FT2

Septic Tank: 1000 Gallons; STB 1012 Date 5/19/94

Pump Tank: Gallons; PT Date

Pump Make: Model Serial No.

Nitrification Field: No Fields 1 Square Feet 1035 Linear Feet 345

No Lines 4 Trench Width 36" Max Trench Bottom Depth 18-36" Gravel Depth 12"

☒ New System ☐ Repair System Type: I, (II), III, IV, V, VI

System Description: CONVENTIONAL GRAVITY

Repair System Description: CONV. GRAVITY/pump

Maintenance Agreement Required: ☐ Yes ☒ No

☒ House/Mod. Home No. Bedrooms 3

☐ Mobile Home No. Bathrooms 2

☐ Business No. Employees

☐ Other


☐ Slab ☒ Crawl Space ☐ Basement w/plumbing ☐ Basement wo/plumbing

Water Supply: ☐ Individual ☐ Community ☒ Public

Comments: (1) KEEP SYSTEM MINIMUM 5' FROM HOUSE, 10' FROM PROPERTY LINE, (2) INSTALL LINES ON CONTOUR, NO DEEPER THAN 36", 9' ON CENTER.

Comments:

INITIAL SITE SKETCH

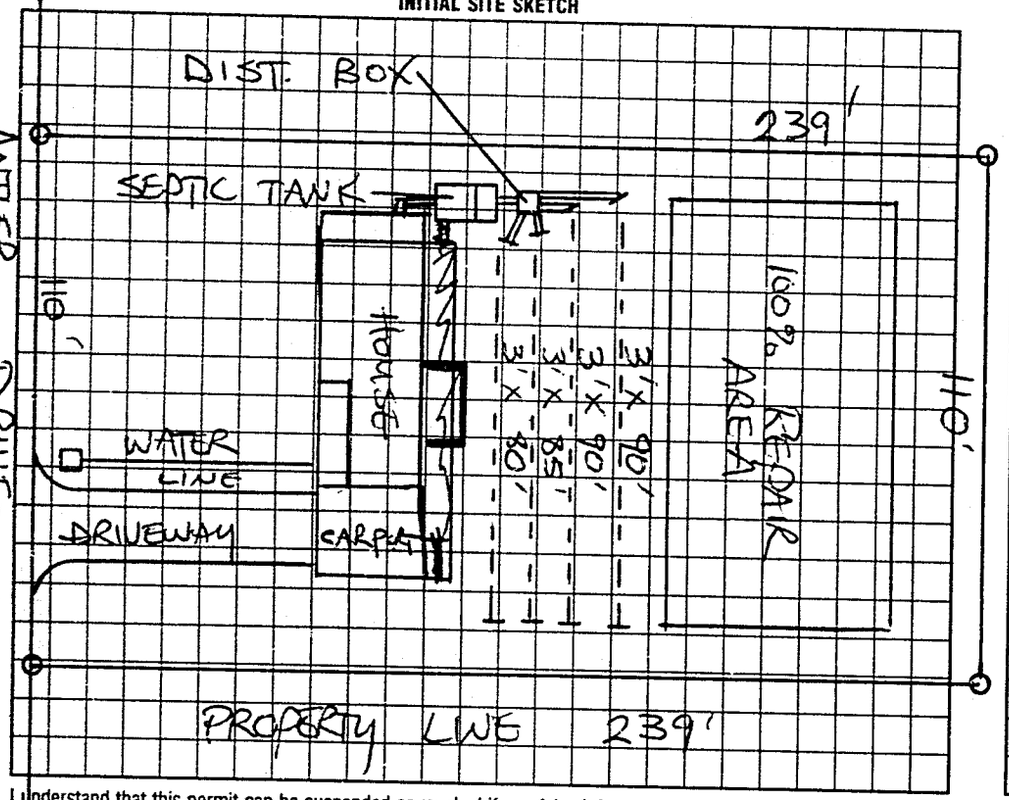

AS BUILT SKETCH

SYSTEM INSTALLED ACCORDING TO INITIAL SITE SKETCH

I understand that this permit can be suspended or revoked if any false information is supplied toward securing the permit/any unauthorized changes are made to the site/any unauthorized changes are made in the installation of the system. Improvement Permit is valid for 60 months from date of issuance.

Signed: D. Mahaffey

Improvement Permit by: STEVE HEDRICK date 4/18/94

Existing System Inspection by: date

Installed by: JAMES HUDLER

Certificate of Completion by: STEVE HEDRICK date 8/9/94

Operation Permit by: date

HEALTH DEPT. COPY: WHITE INSPECTION COPY (FINAL): GREEN OWNER COPY (FINAL): YELLOW INSPECTION COPY (INITIAL): PINK OWNER COPY (INITIAL): GOLD