4:00

IREDELL COUNTY HEALTH DEPARTMENT

STATESVILLE 704-878-5305 MOORESVILLE 704-664-5281

IMPROVEMENT PERMIT / AUTHORIZATION TO CONSTRUCT / OPERATION PERMIT / EXISTING SYSTEM INSPECTION

PERMIT# 88795 PIN# 4726316491 PT DATE 7/5/00

OWNER OR CONTRACTOR RICHARD WILSON PHONE: Business 873-9034 Home

ADDRESS 2210 JAMES WAY · STATESVILLE 28625

LOCATION SLOTTS CREEK · TL MILLER FARM · TR OFF · TR DEERCROFT · ON LT

SUBDIVISION DEERCROFT BLOCK / SECTION LOT 187 LOT AREA 1.04AC SITE CLASS PS DESIGN FLOW 360GPD L.T.A.R. · 3gpd/ft²

Septic Tank: 1000 Gallons; STB 1007 Date 8/25/00
Pump Tank: Gallons; PT Date
Pump Make: Model Serial No.
Nitrification Field: No Fields 1 Square Feet 1800 Linear Feet 400
No Lines SCBD' Trench Width 36" Max Trench Bottom Depth 36" Gravel Depth 12"

☐ New System ☐ Repair System Type: I (II) III. IV. V. VI
System Description: GRAVITY CONVENTIONAL
Repair System Description: SAME
Maintenance Agreement Required: ☐ Yes ☒ No

☒ House/Mod. Home No. Bedrooms 3
☐ Mobile Home No. Bathrooms 3
☐ Business No. Employees
☐ Other


☐ Slab ☐ Crawl Space ☐ Basement w/plumbing ☐ Basement wo/plumbing

Water Supply: ☐ Individual ☒ Public ☐ Community


Comments:/Conditions:

Comments:/Conditions:

INITIAL SITE SKETCH 1" = 50'

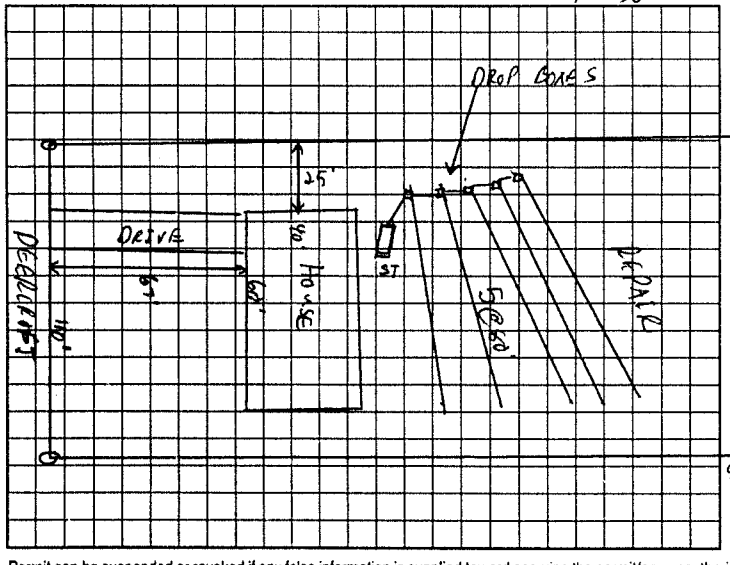

AS BUILT SKETCH

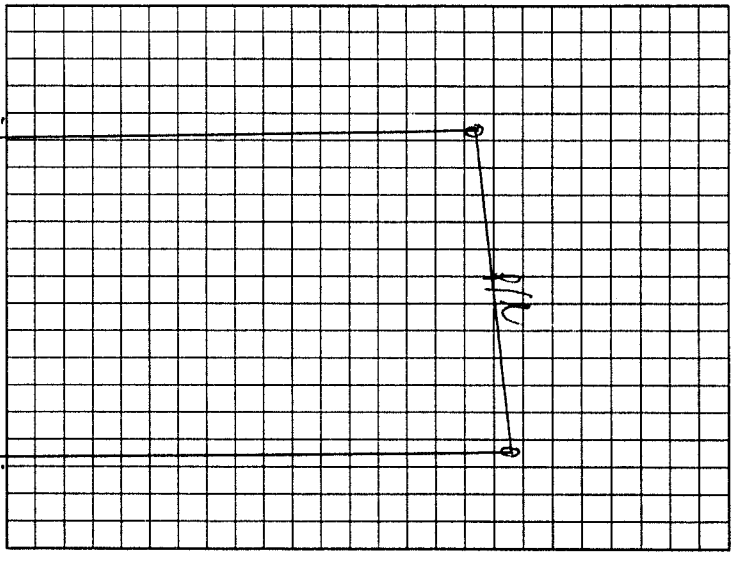

Permit can be suspended or revoked if any false information is supplied toward securing the permit/any unauthorized changes are made to the site/any unauthorized changes are made in the installation of the system. Improvement Permit with plat valid without expiration. Improvement Permit with site plan valid for sixty months. Authorization to Construct is valid for a period equal to that of Improvement Permit – not to exceed sixty months.

Signed: Richard Wilson date 7/13/00 Installed by: Advance Backhoe

Improvement Permit by: C. Hyatt RS date 7/5/00 Operation Permit by: [signature] RSI date 10/11/00

Authorization to Construct by: C. Hyatt RS date 7/5/00 Existing System Inspection by: date

HEALTH DEPT. COPY: WHITE / OWNER COPY (FINAL): YELLOW OWNER COPY (INITIAL): PINK